




STORRE & WOODBERRY INDUSTRIES, INC.		UNIT NO.	
CHEMICAL MILL OPERATIONS DIVISION		12067 C-6	
PROJECT ENGINEER	APPROVING ENGINEER	TECH. LEGAL	
THE DISTRICT ENGINEER		ENGINEERING DESIGN NUMBER	
TITLE: DRYWELL COMPOSITE PLAN AT EL. 507'-0" WEST			
LOCATION: ENRICO FERMIL ATOMIC POWER PLANT #2			
PROPERTY OF: DOCUMENT CONTROL NO.			
DRAWING NUMBER:		DATE: 11-2-67	
SM721-4694		1. IN SCALE 1/8" = 1'-0" 2. SEE DRAWING FOR 3. SEE DRAWING FOR RDS-PDR

8104060425

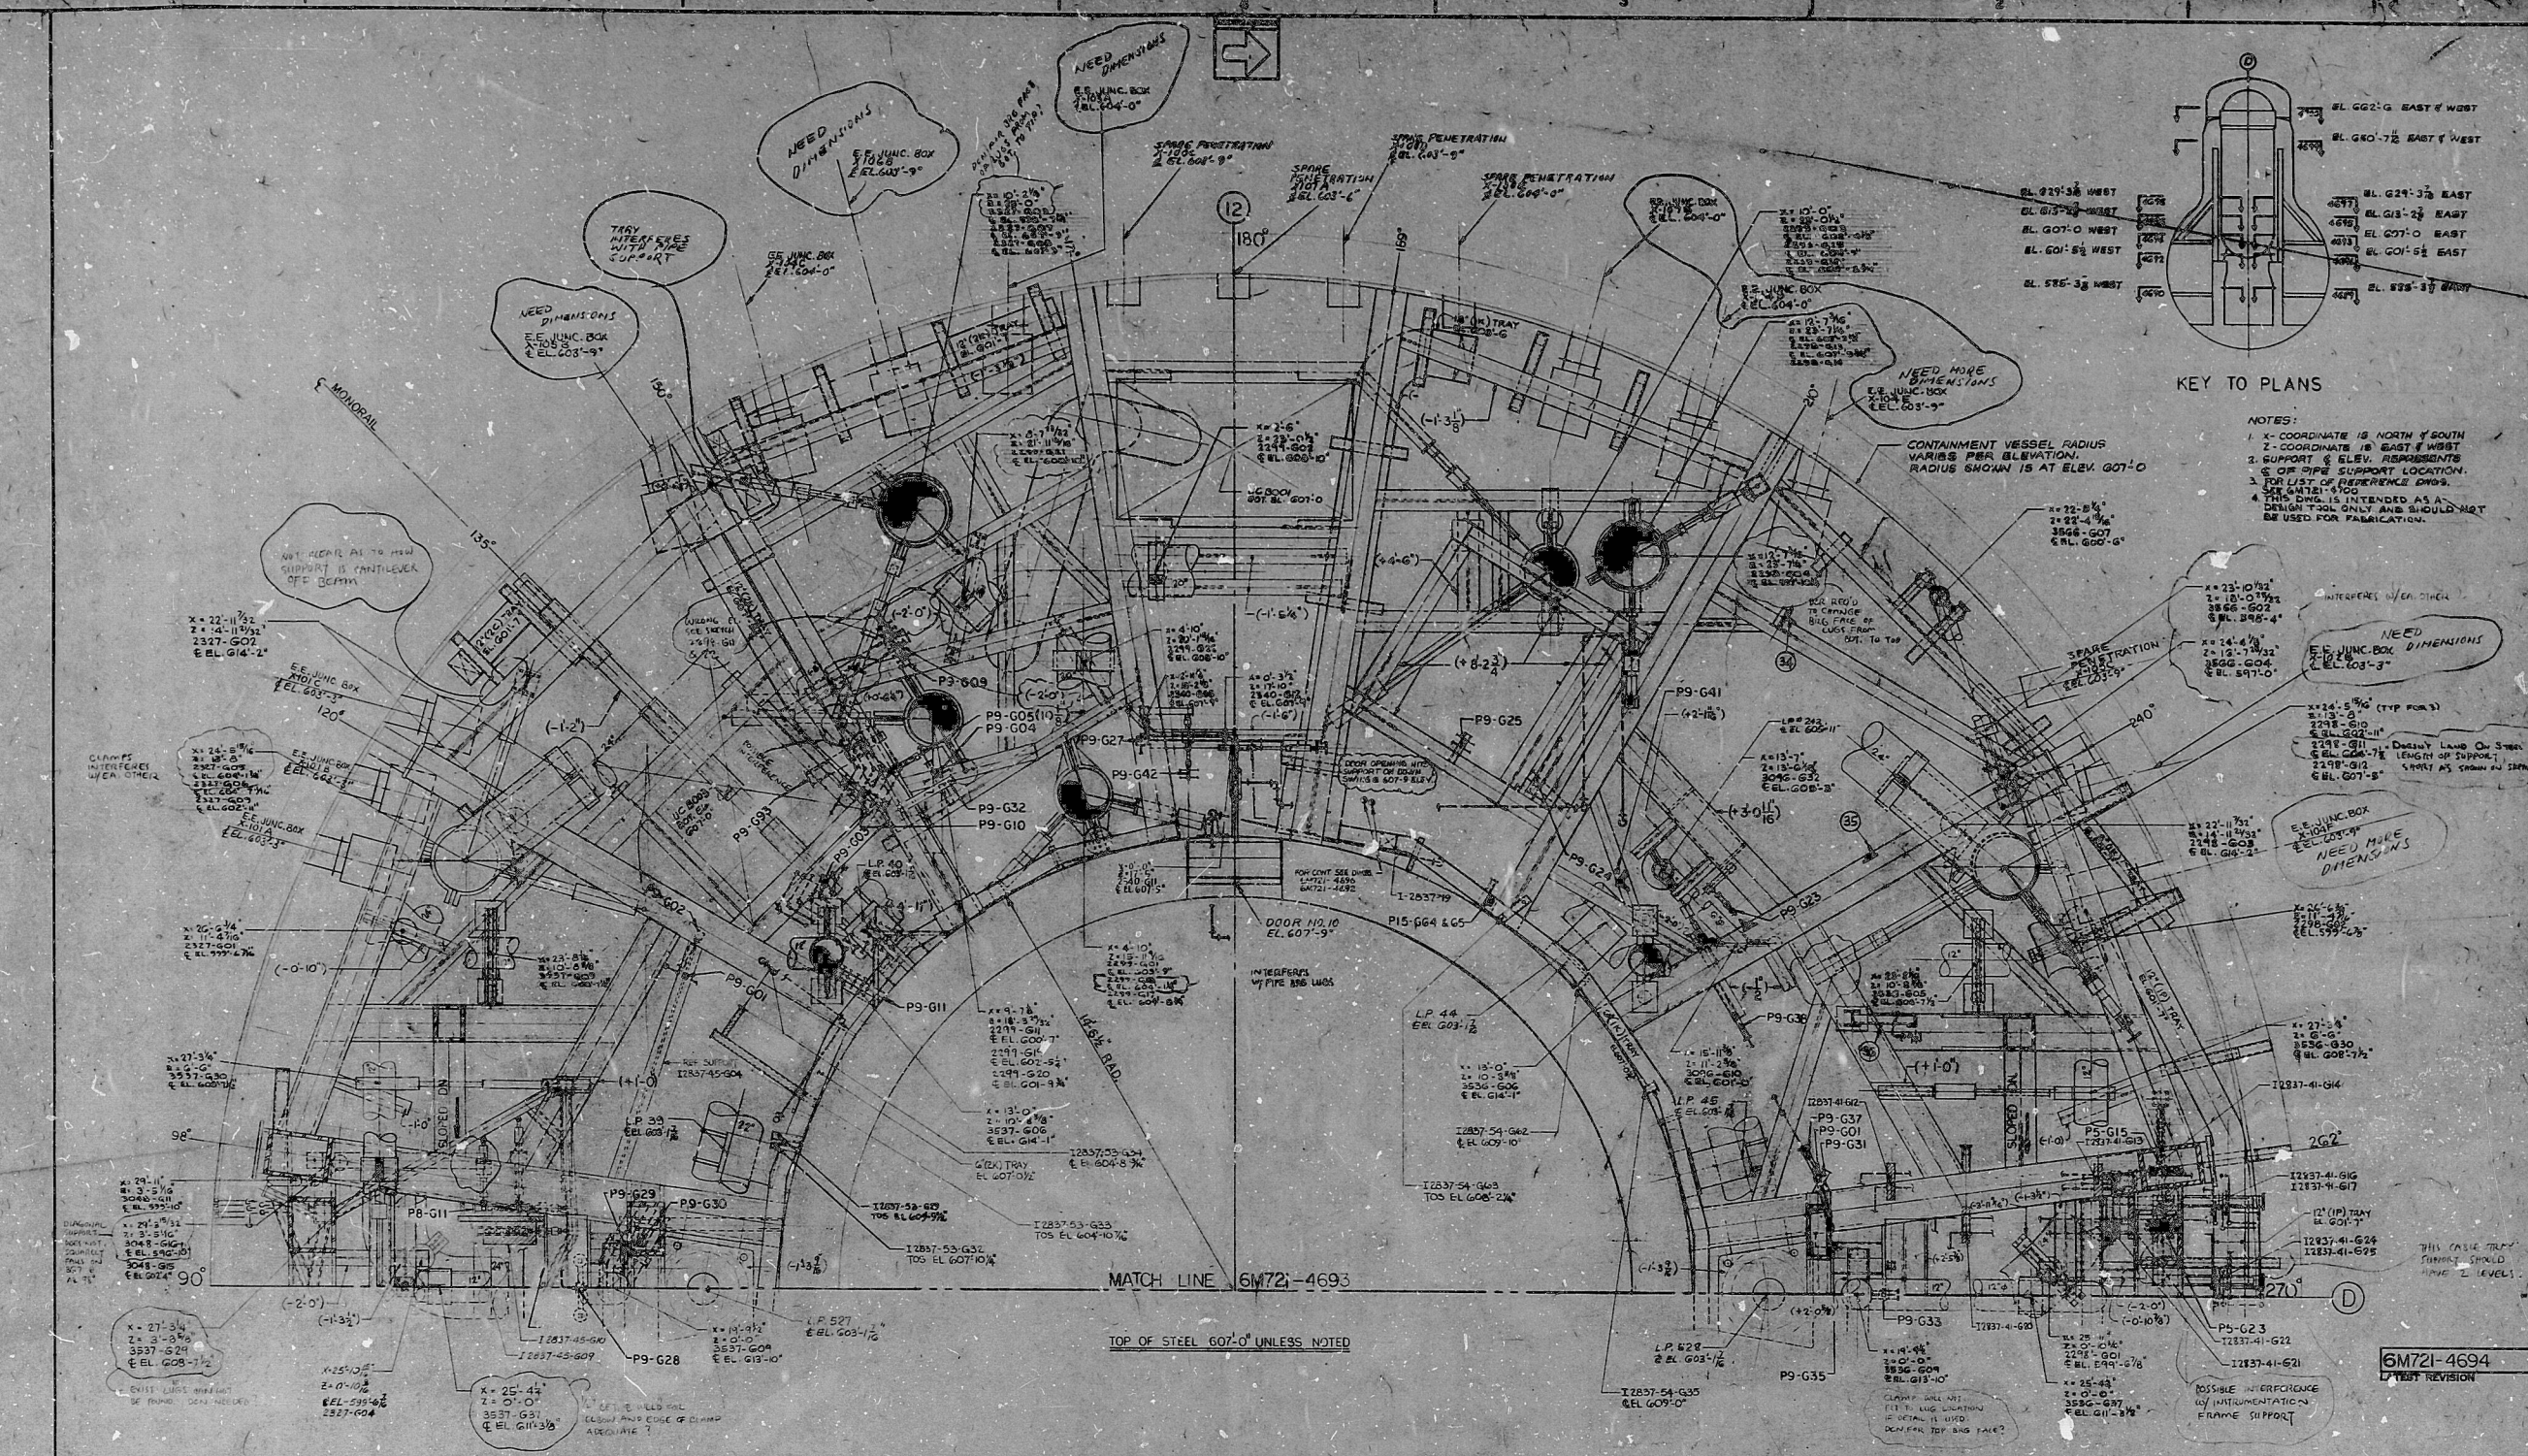