


[illegible]

RDS-RDR

8104060442

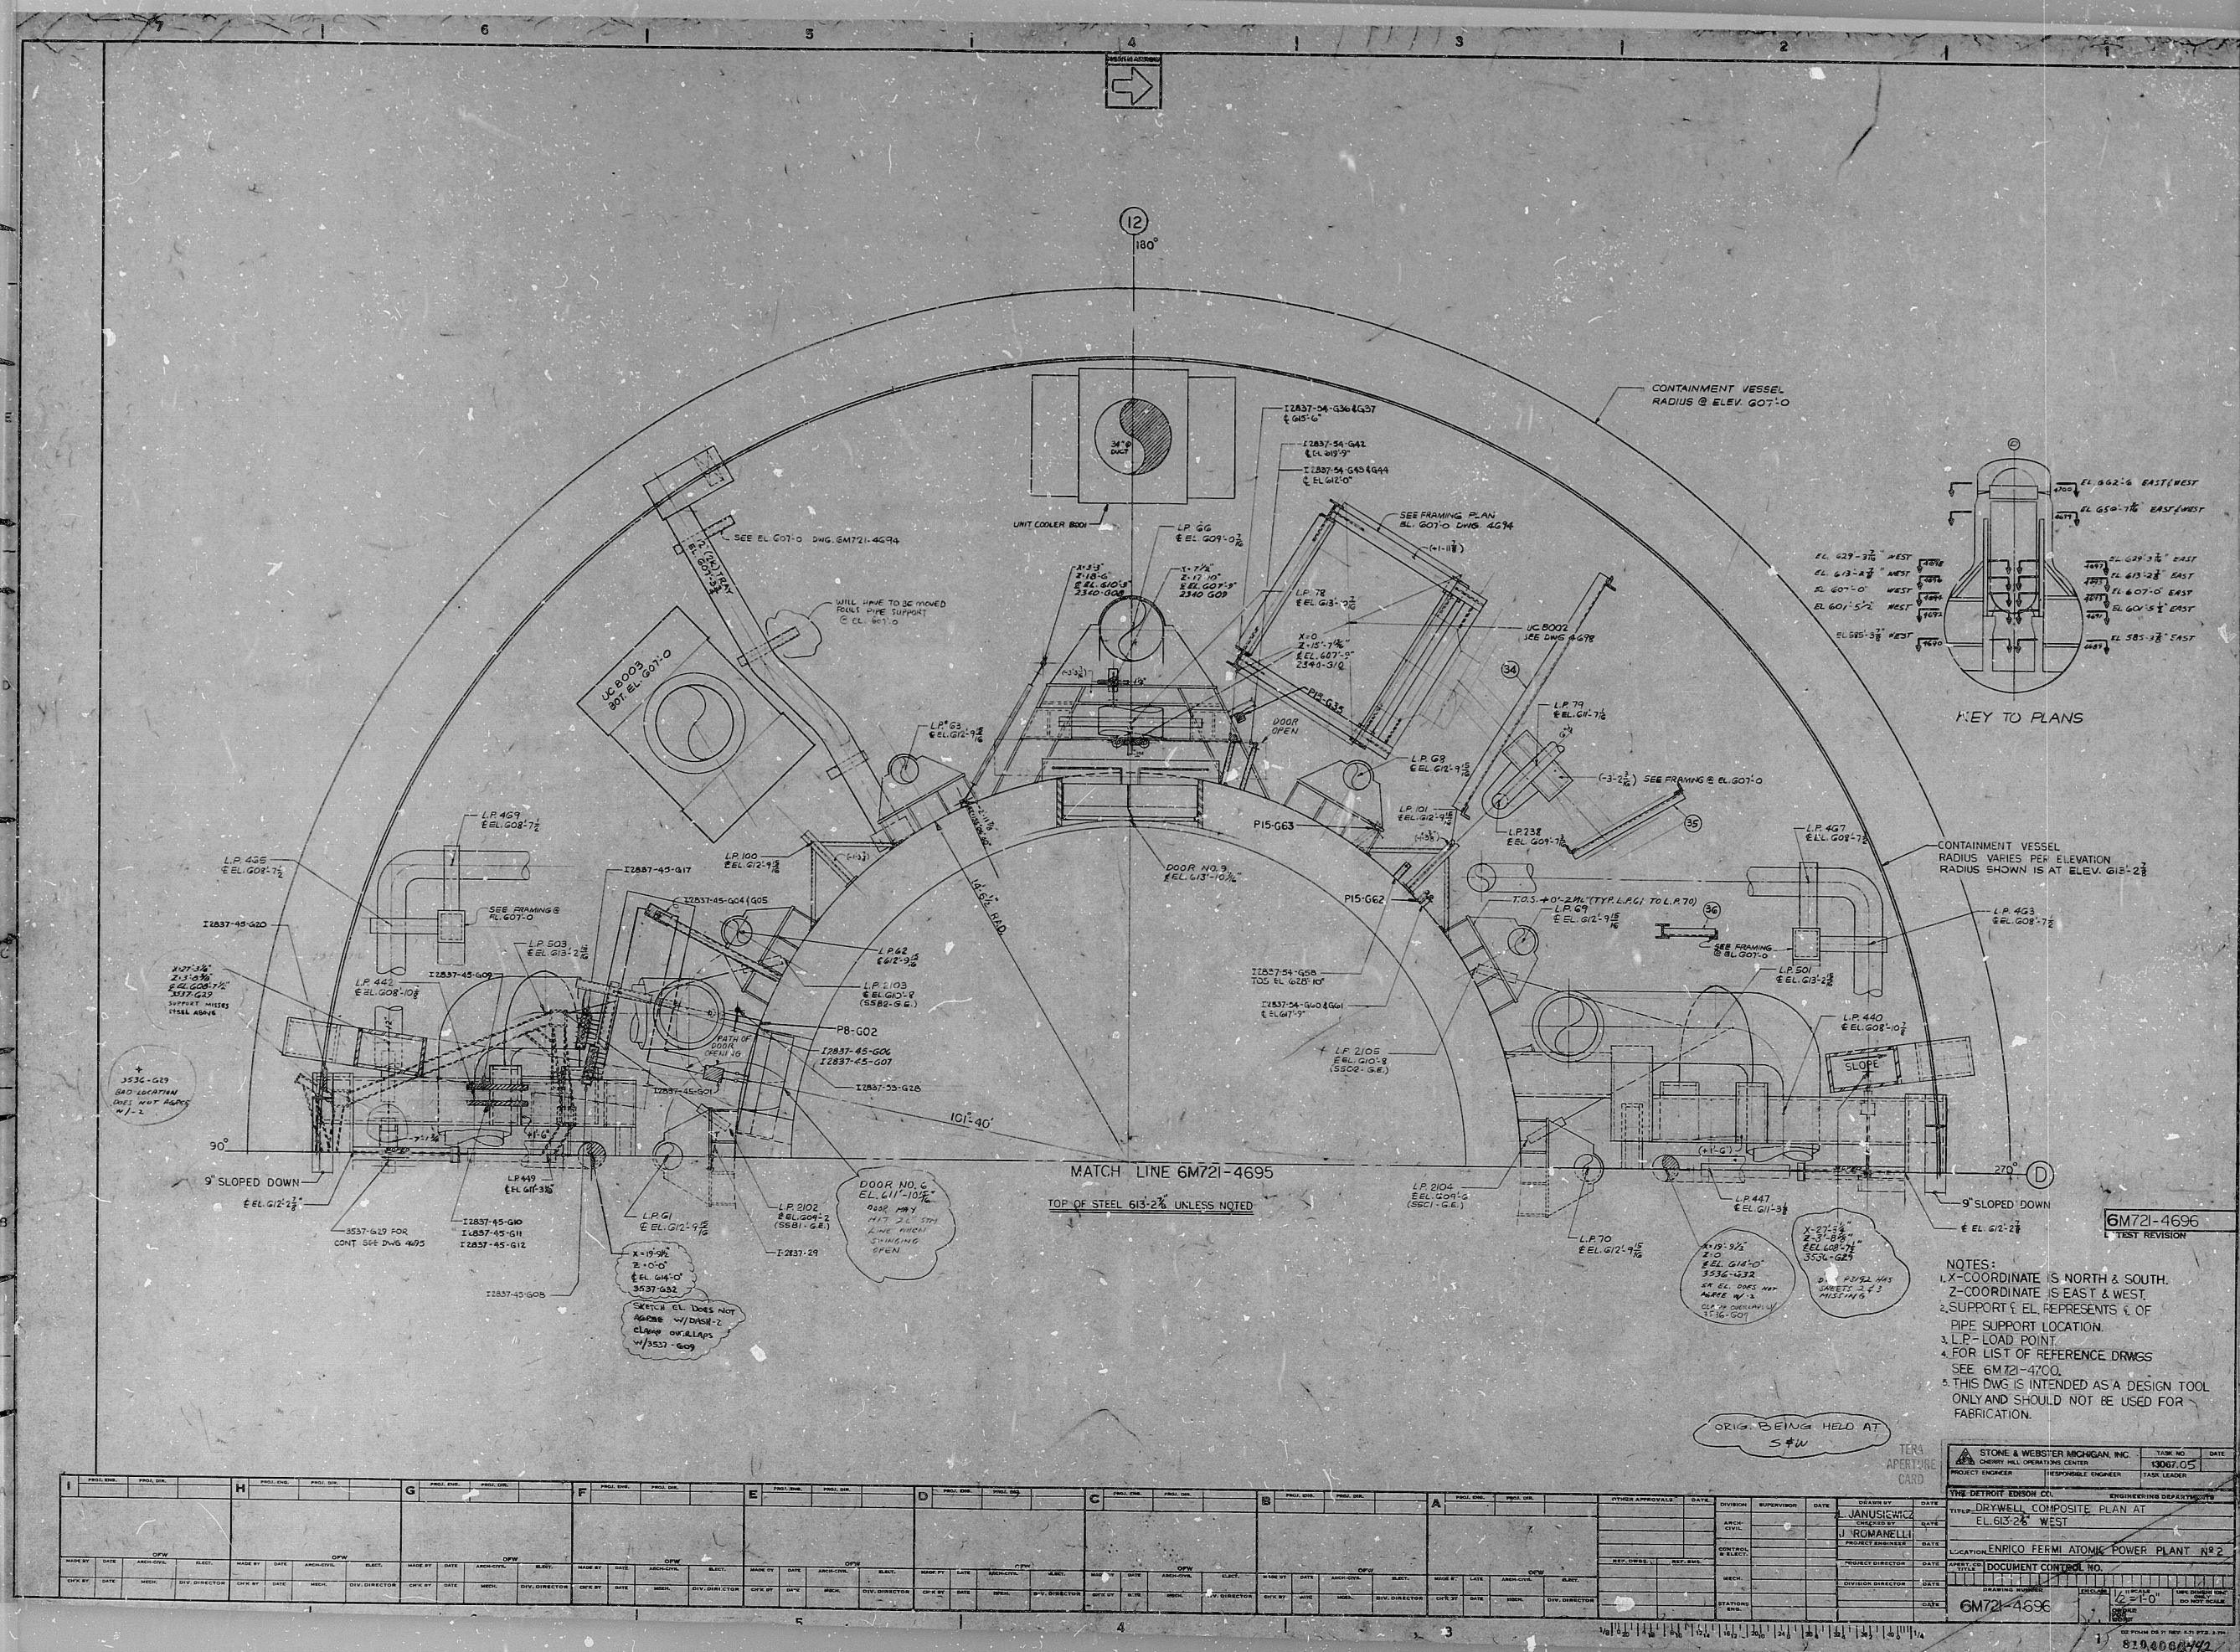