


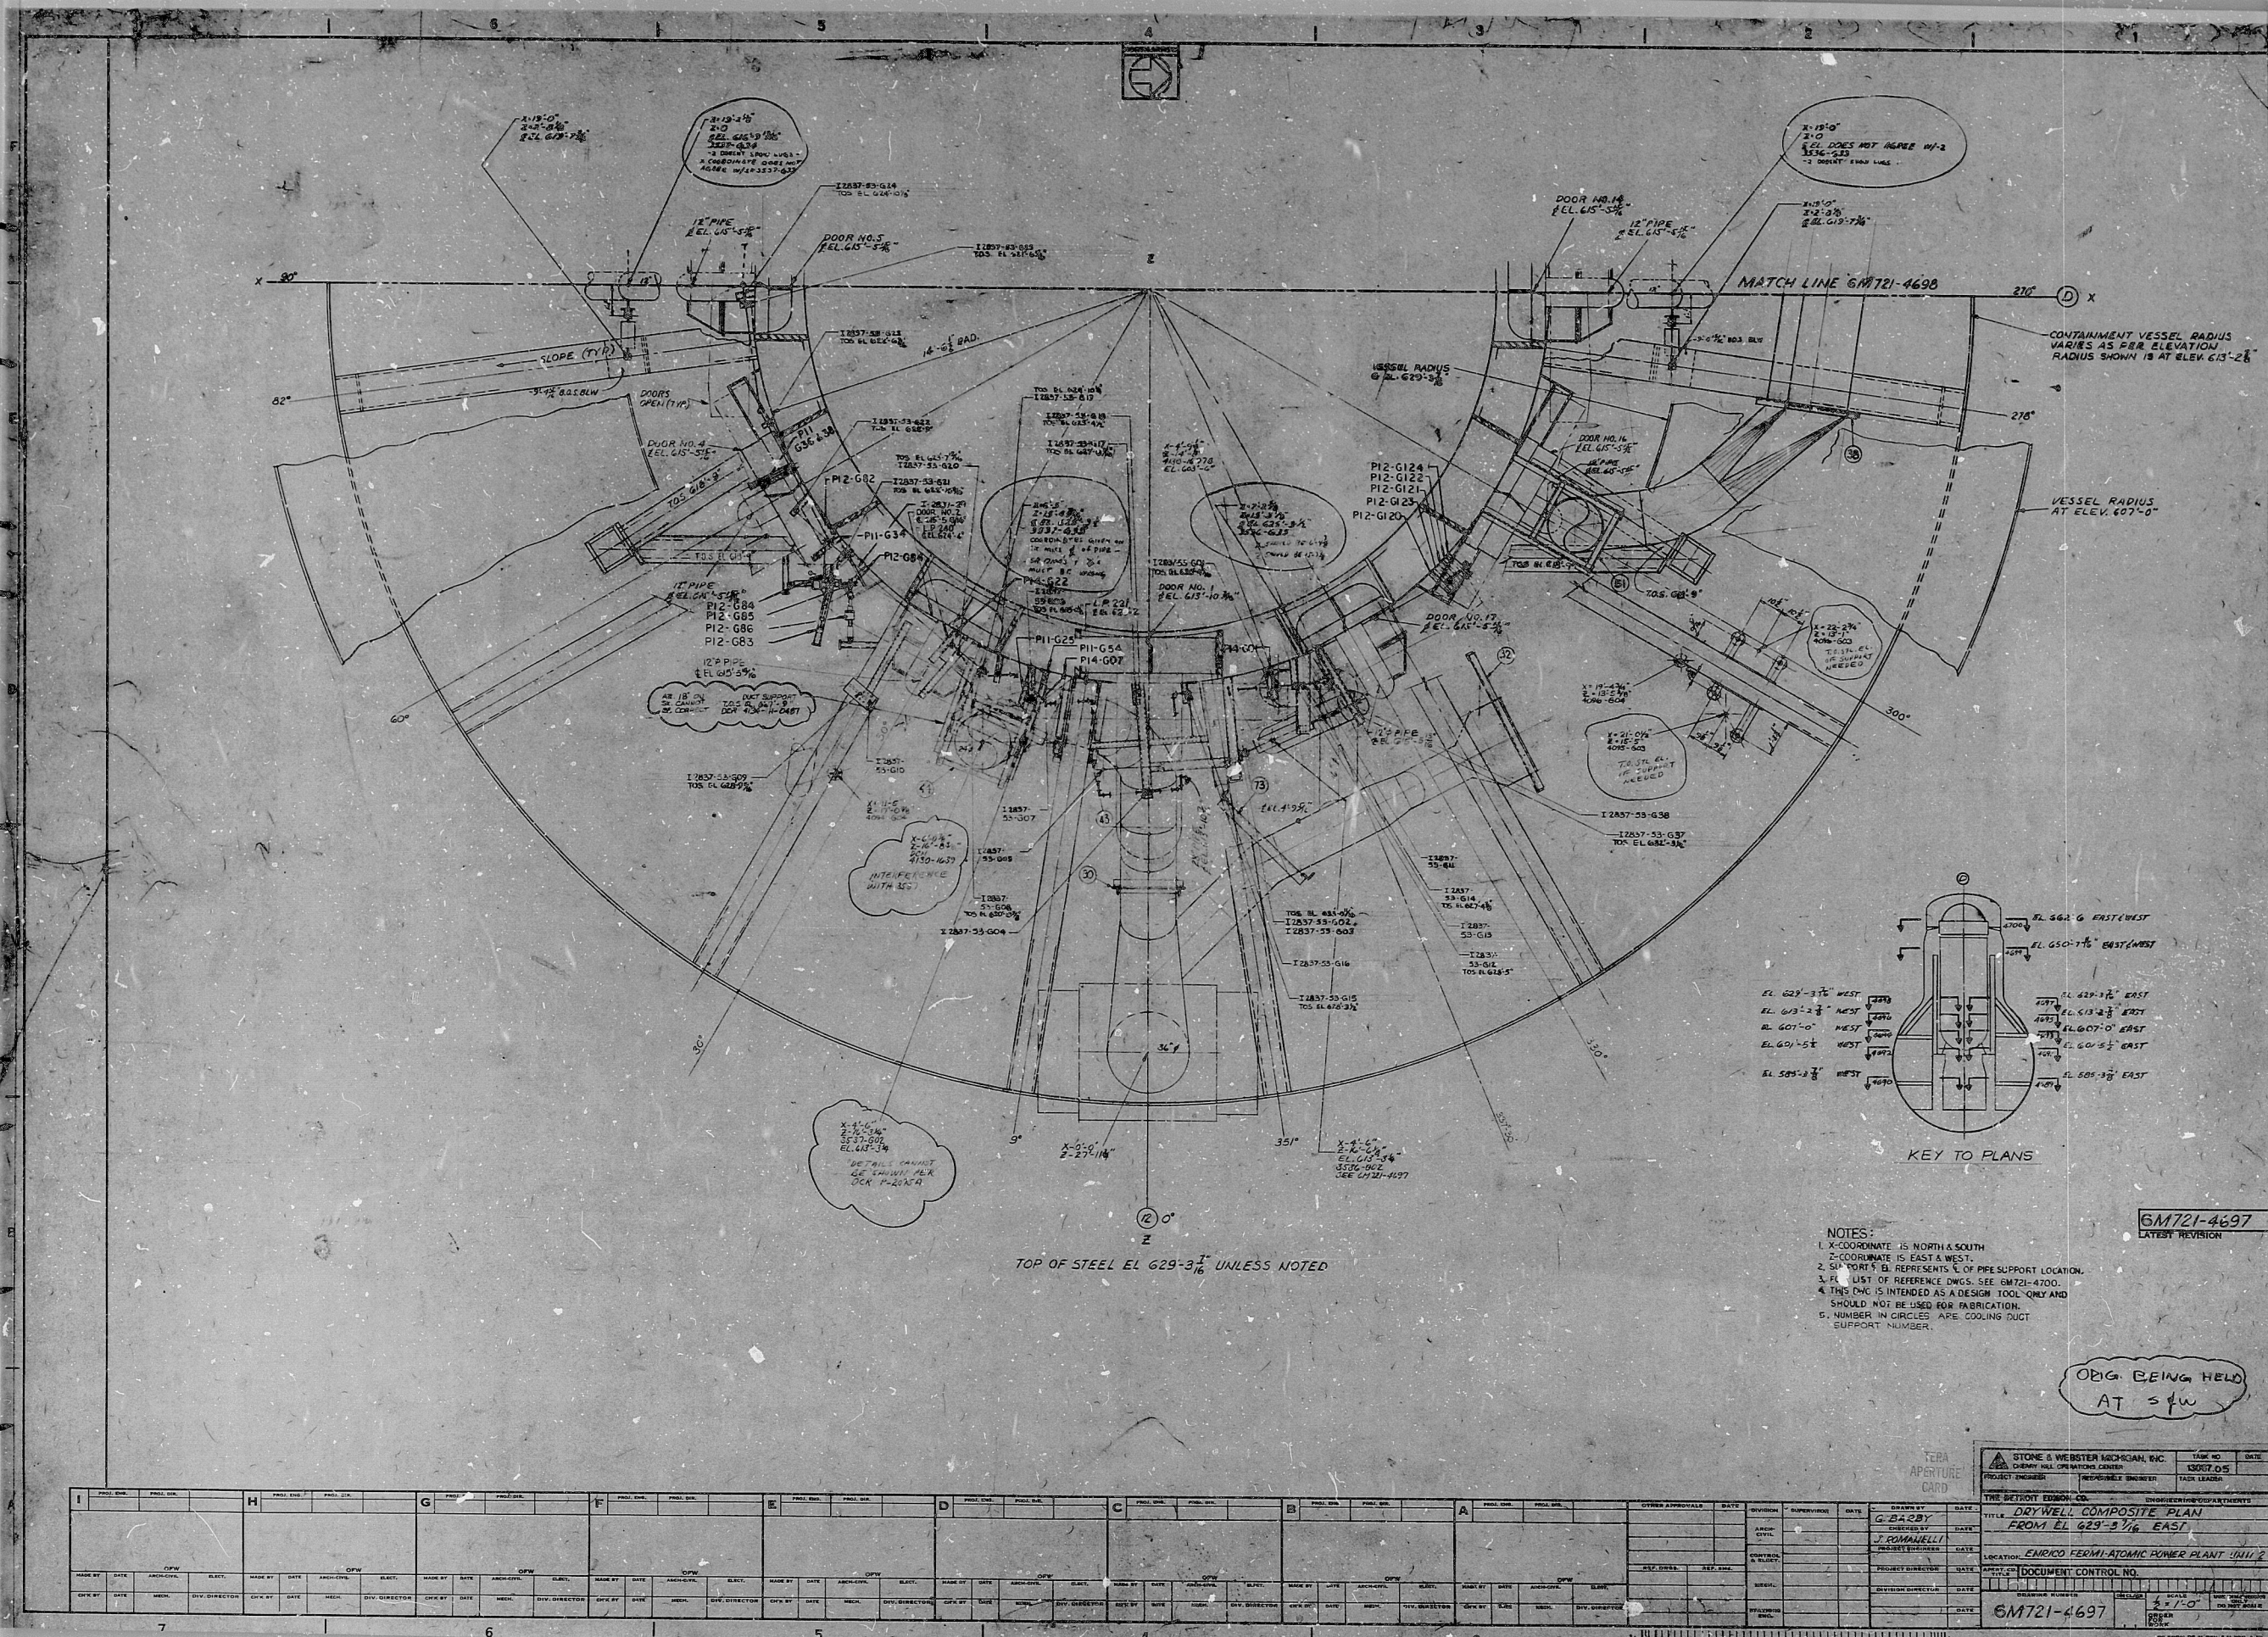

6M721-469
LATEST REVISION


ORIG. BEING HELD
AT SFW

NOTES:

1. X-COORDINATE IS NORTH & SOUTH
2. Z-COORDINATE IS EAST & WEST.
3. SUPPORT # B, REPRESENTS # OF PIPE SUPPORT LOCATION.
4. PL. LIST OF REFERENCE DWGS. SEE 6M72-4700.
4. THIS DWG IS INTENDED AS A DESIGN TOOL ONLY AND SHOULD NOT BE USED FOR FABRICATION.
5. NUMBER IN CIRCLES ARE COOLING DUCT SUPPORT NUMBER.

[illegible]

RIDS-RDR

8104060444

