


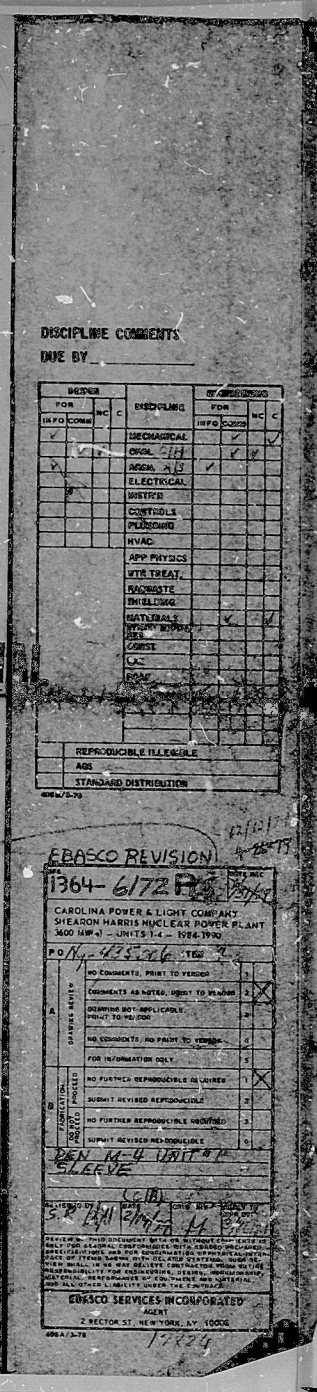

RIDS

8207140152

