


This drawing and the design it covers is the property of the Utilities which are participating in the SNUPPS Project. It is loaned to the borrower's express agreement that it will not be reproduced, copied, loaned, exhibited, or used except in the limited way and private use permitted by written consent given by the SNUPPS Utilities to the borrower.


CONTROL SWITCH "OPEN"
HIS-29

CONTROL SWITCH "CLOSE"
HIS-29

CIS A.

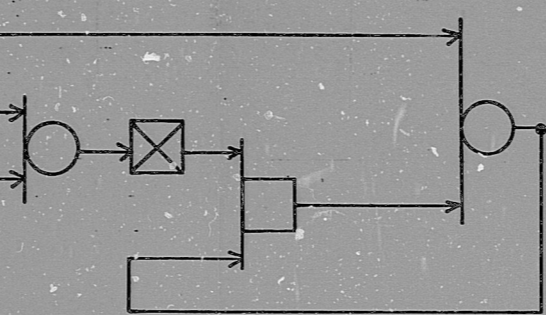

NOTES:
1. VALVE FAILS CLOSED.
2. THE STATUS OF THIS VALVE IS INDICATED ON THE ESF STATUS PANEL.

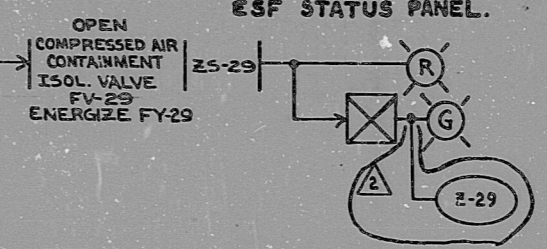

OPEN
G R
CLOSE

CONTROL SWITCH
HIS-29
CUTLER-HAMMER E-30
MOMENTARY CONTACT
LOCATION: O24
SEPARATION GROUP: I

REFERENCES
M-02KA01
E-03KA02

	<table border="1"> <tr><th>NO.</th><th>DATE</th><th>REVISIONS</th><th>BY</th><th>CHK</th><th>SUP</th><th>ENGR</th><th>PROJ</th><th>ENGR</th><th>APPR</th><th>APPR</th></tr> <tr><td>1</td><td>11-21-77</td><td>REVISED AS NOTED</td><td>JA</td><td></td><td></td><td></td><td></td><td></td><td></td><td></td></tr> <tr><td>2</td><td>12-11-77</td><td>REVISED AS NOTED</td><td>JA</td><td></td><td></td><td></td><td></td><td></td><td></td><td></td></tr> <tr><td>3</td><td>1-11-78</td><td>ISSUED FOR CONSTRUCTION</td><td>JA</td><td></td><td></td><td></td><td></td><td></td><td></td><td></td></tr> </table>	NO.	DATE	REVISIONS	BY	CHK	SUP	ENGR	PROJ	ENGR	APPR	APPR	1	11-21-77	REVISED AS NOTED	JA								2	12-11-77	REVISED AS NOTED	JA								3	1-11-78	ISSUED FOR CONSTRUCTION	JA								<p>BECHTEL GAITHERSBURG, MARYLAND</p> <p>SNUPPS JOB NO. 10466</p>	<p>CONTROL LOGIC DIAGRAM</p> <p>COMPRESSED AIR SYSTEM COMPRESSED AIR CONTAINMENT ISOLATION VALVE</p>	<table border="1"> <tr><th>UTILITY DWG. NO.</th><th>REV.</th></tr> <tr><td>BECHTEL DWG. NO.</td><td>REV.</td></tr> <tr><td>J-02KA02 (3)</td><td>2</td></tr> <tr><td colspan="2">DWG. APPLICABLE TO UNITS</td></tr> <tr><td>1</td><td>2</td></tr> <tr><td>3</td><td>4</td></tr> <tr><td>5</td><td>6</td></tr> <tr><td>7</td><td>8</td></tr> </table>	UTILITY DWG. NO.	REV.	BECHTEL DWG. NO.	REV.	J-02KA02 (3)	2	DWG. APPLICABLE TO UNITS		1	2	3	4	5	6	7	8
	NO.	DATE	REVISIONS	BY	CHK	SUP	ENGR	PROJ	ENGR	APPR	APPR	
	1	11-21-77	REVISED AS NOTED	JA	
	2	12-11-77	REVISED AS NOTED	JA	
3	1-11-78	ISSUED FOR CONSTRUCTION	JA	
UTILITY DWG. NO.	REV.	
BECHTEL DWG. NO.	REV.	
J-02KA02 (3)	2	
DWG. APPLICABLE TO UNITS	
1	2	
3	4	
5	6	
7	8	
DESIGNED: <i>DK</i>	DRAWN: <i>CB</i>	DATE: <i>12/77</i>	REVIEW LEVEL 1	
SUPERVISOR: <i>Apfalion</i>		DEC 79 CAMERA OPERATOR: <i>BN Koppa</i>	
		16X	

TERA
APERTURE
CARD

RIDS-PDR

8104060837

