



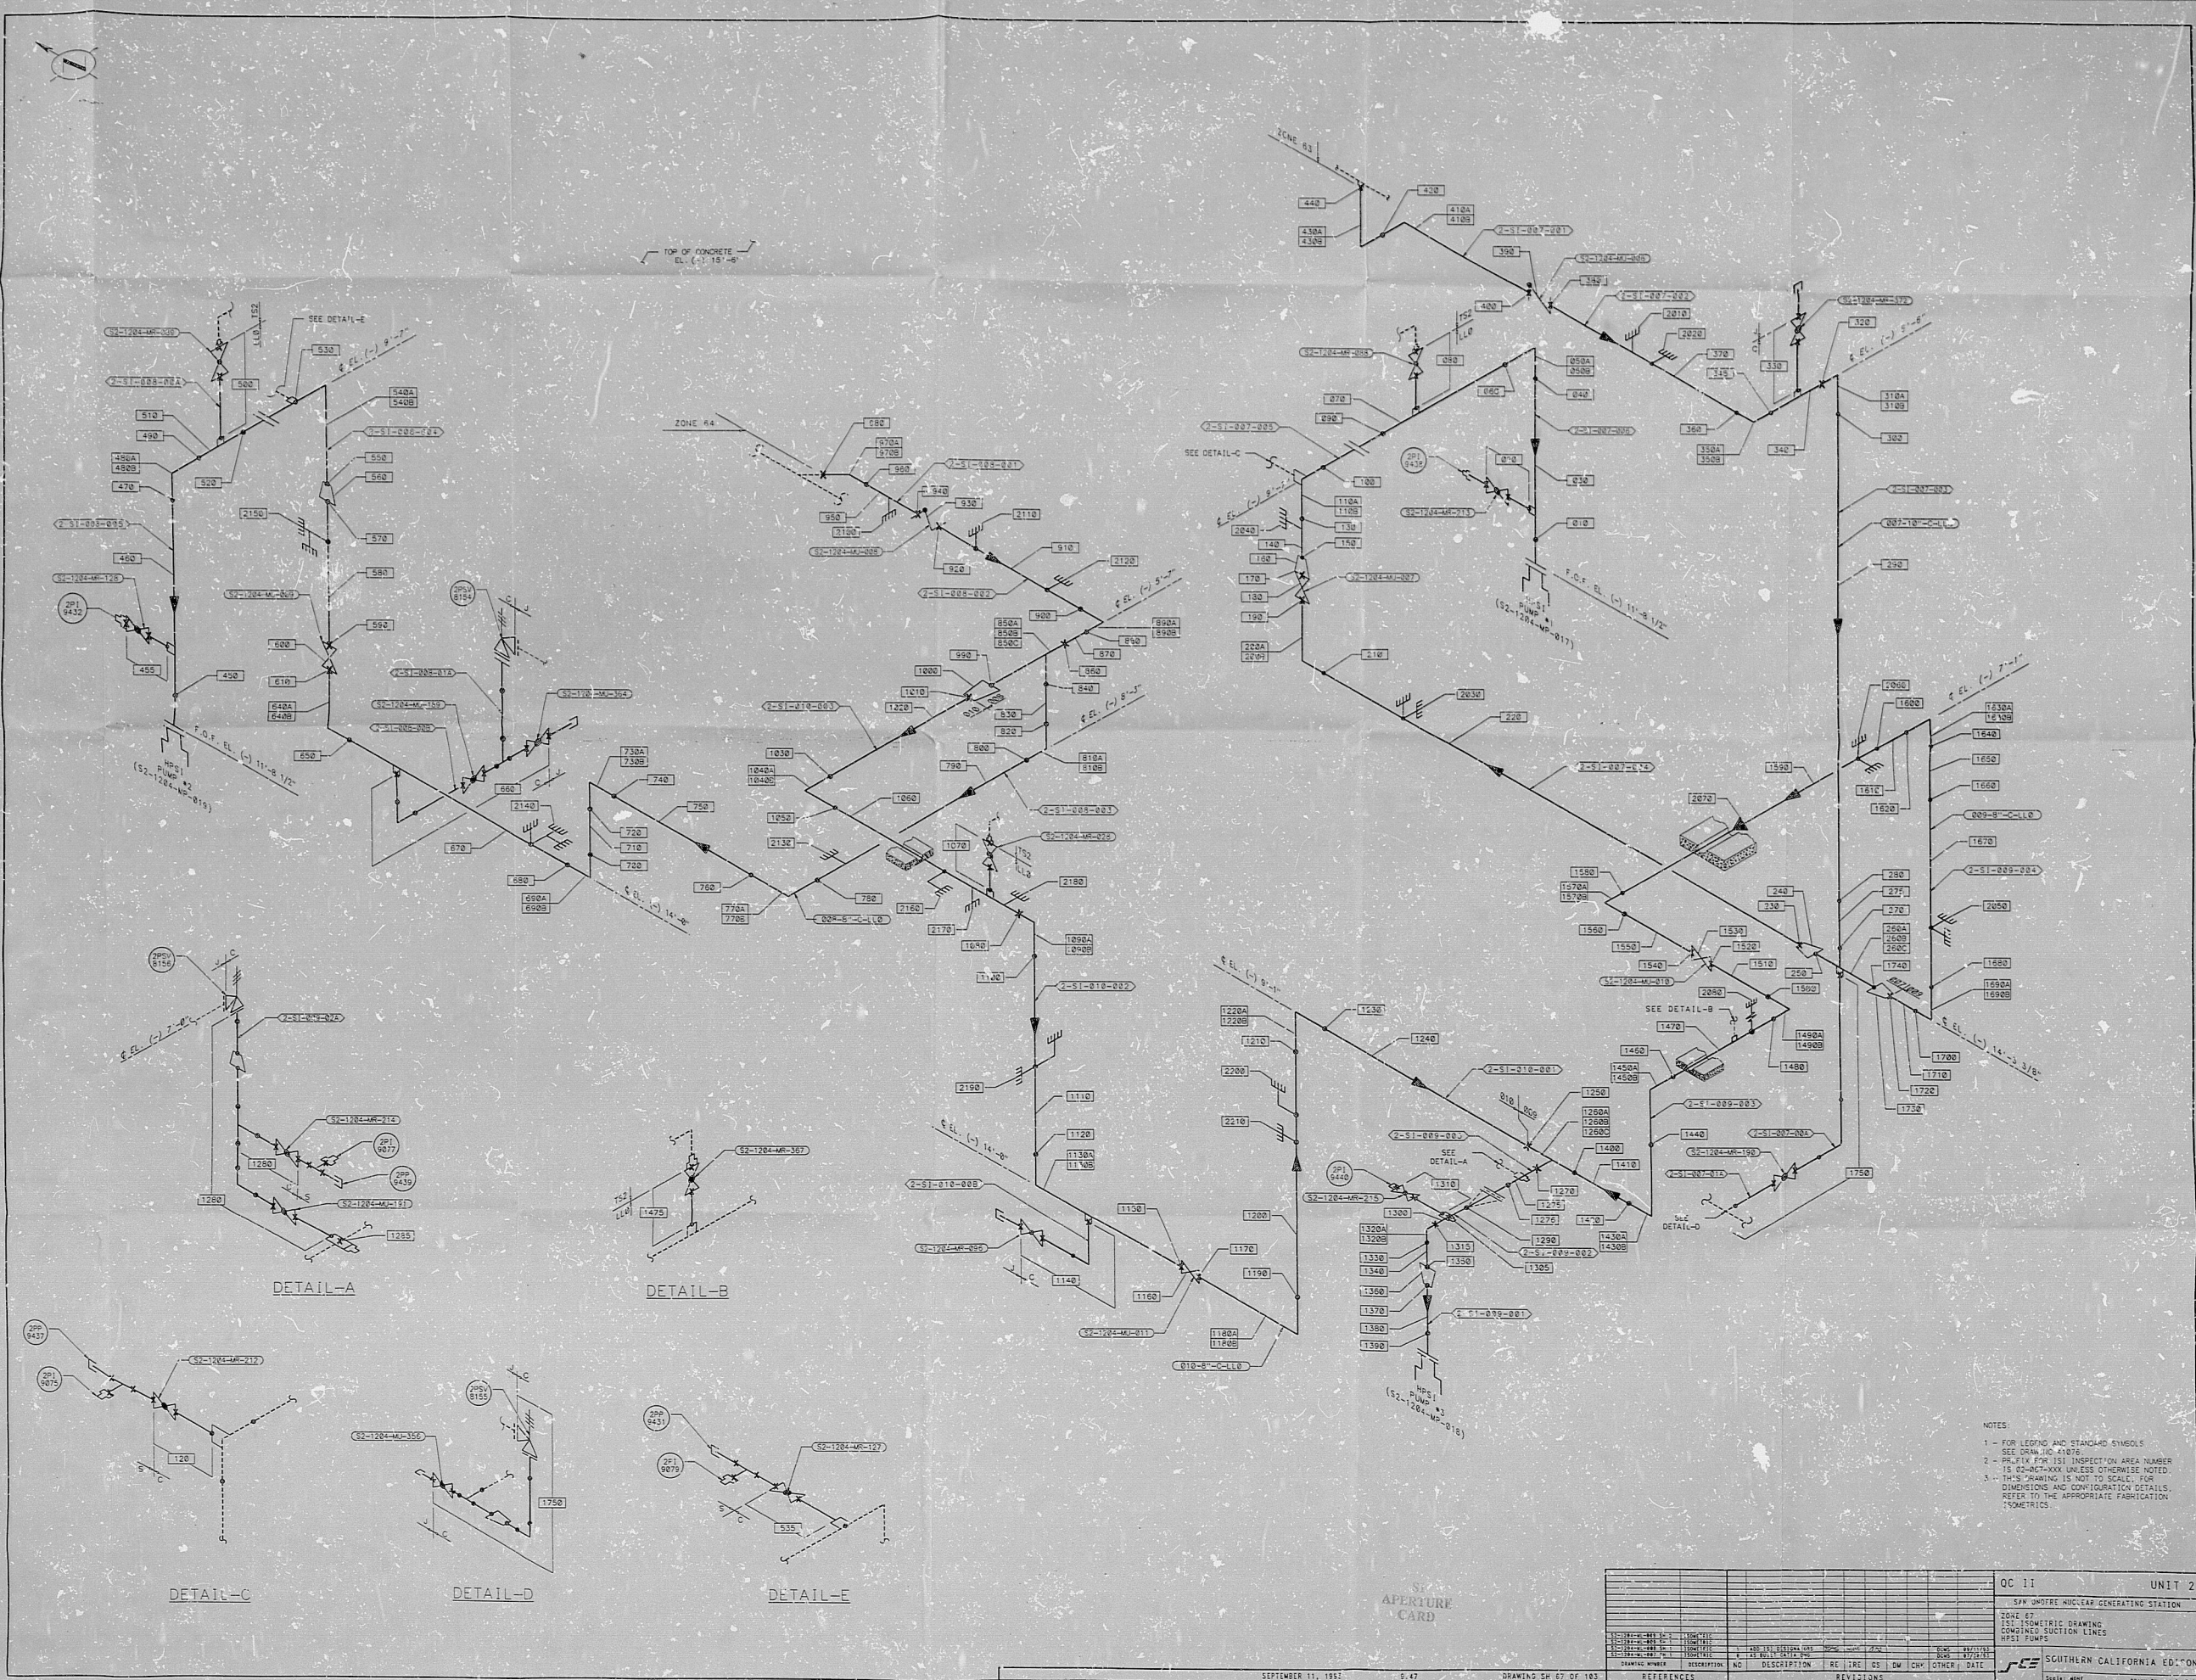

PDR RIDA

9311180192

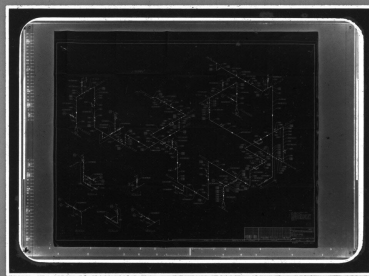

9311180192