


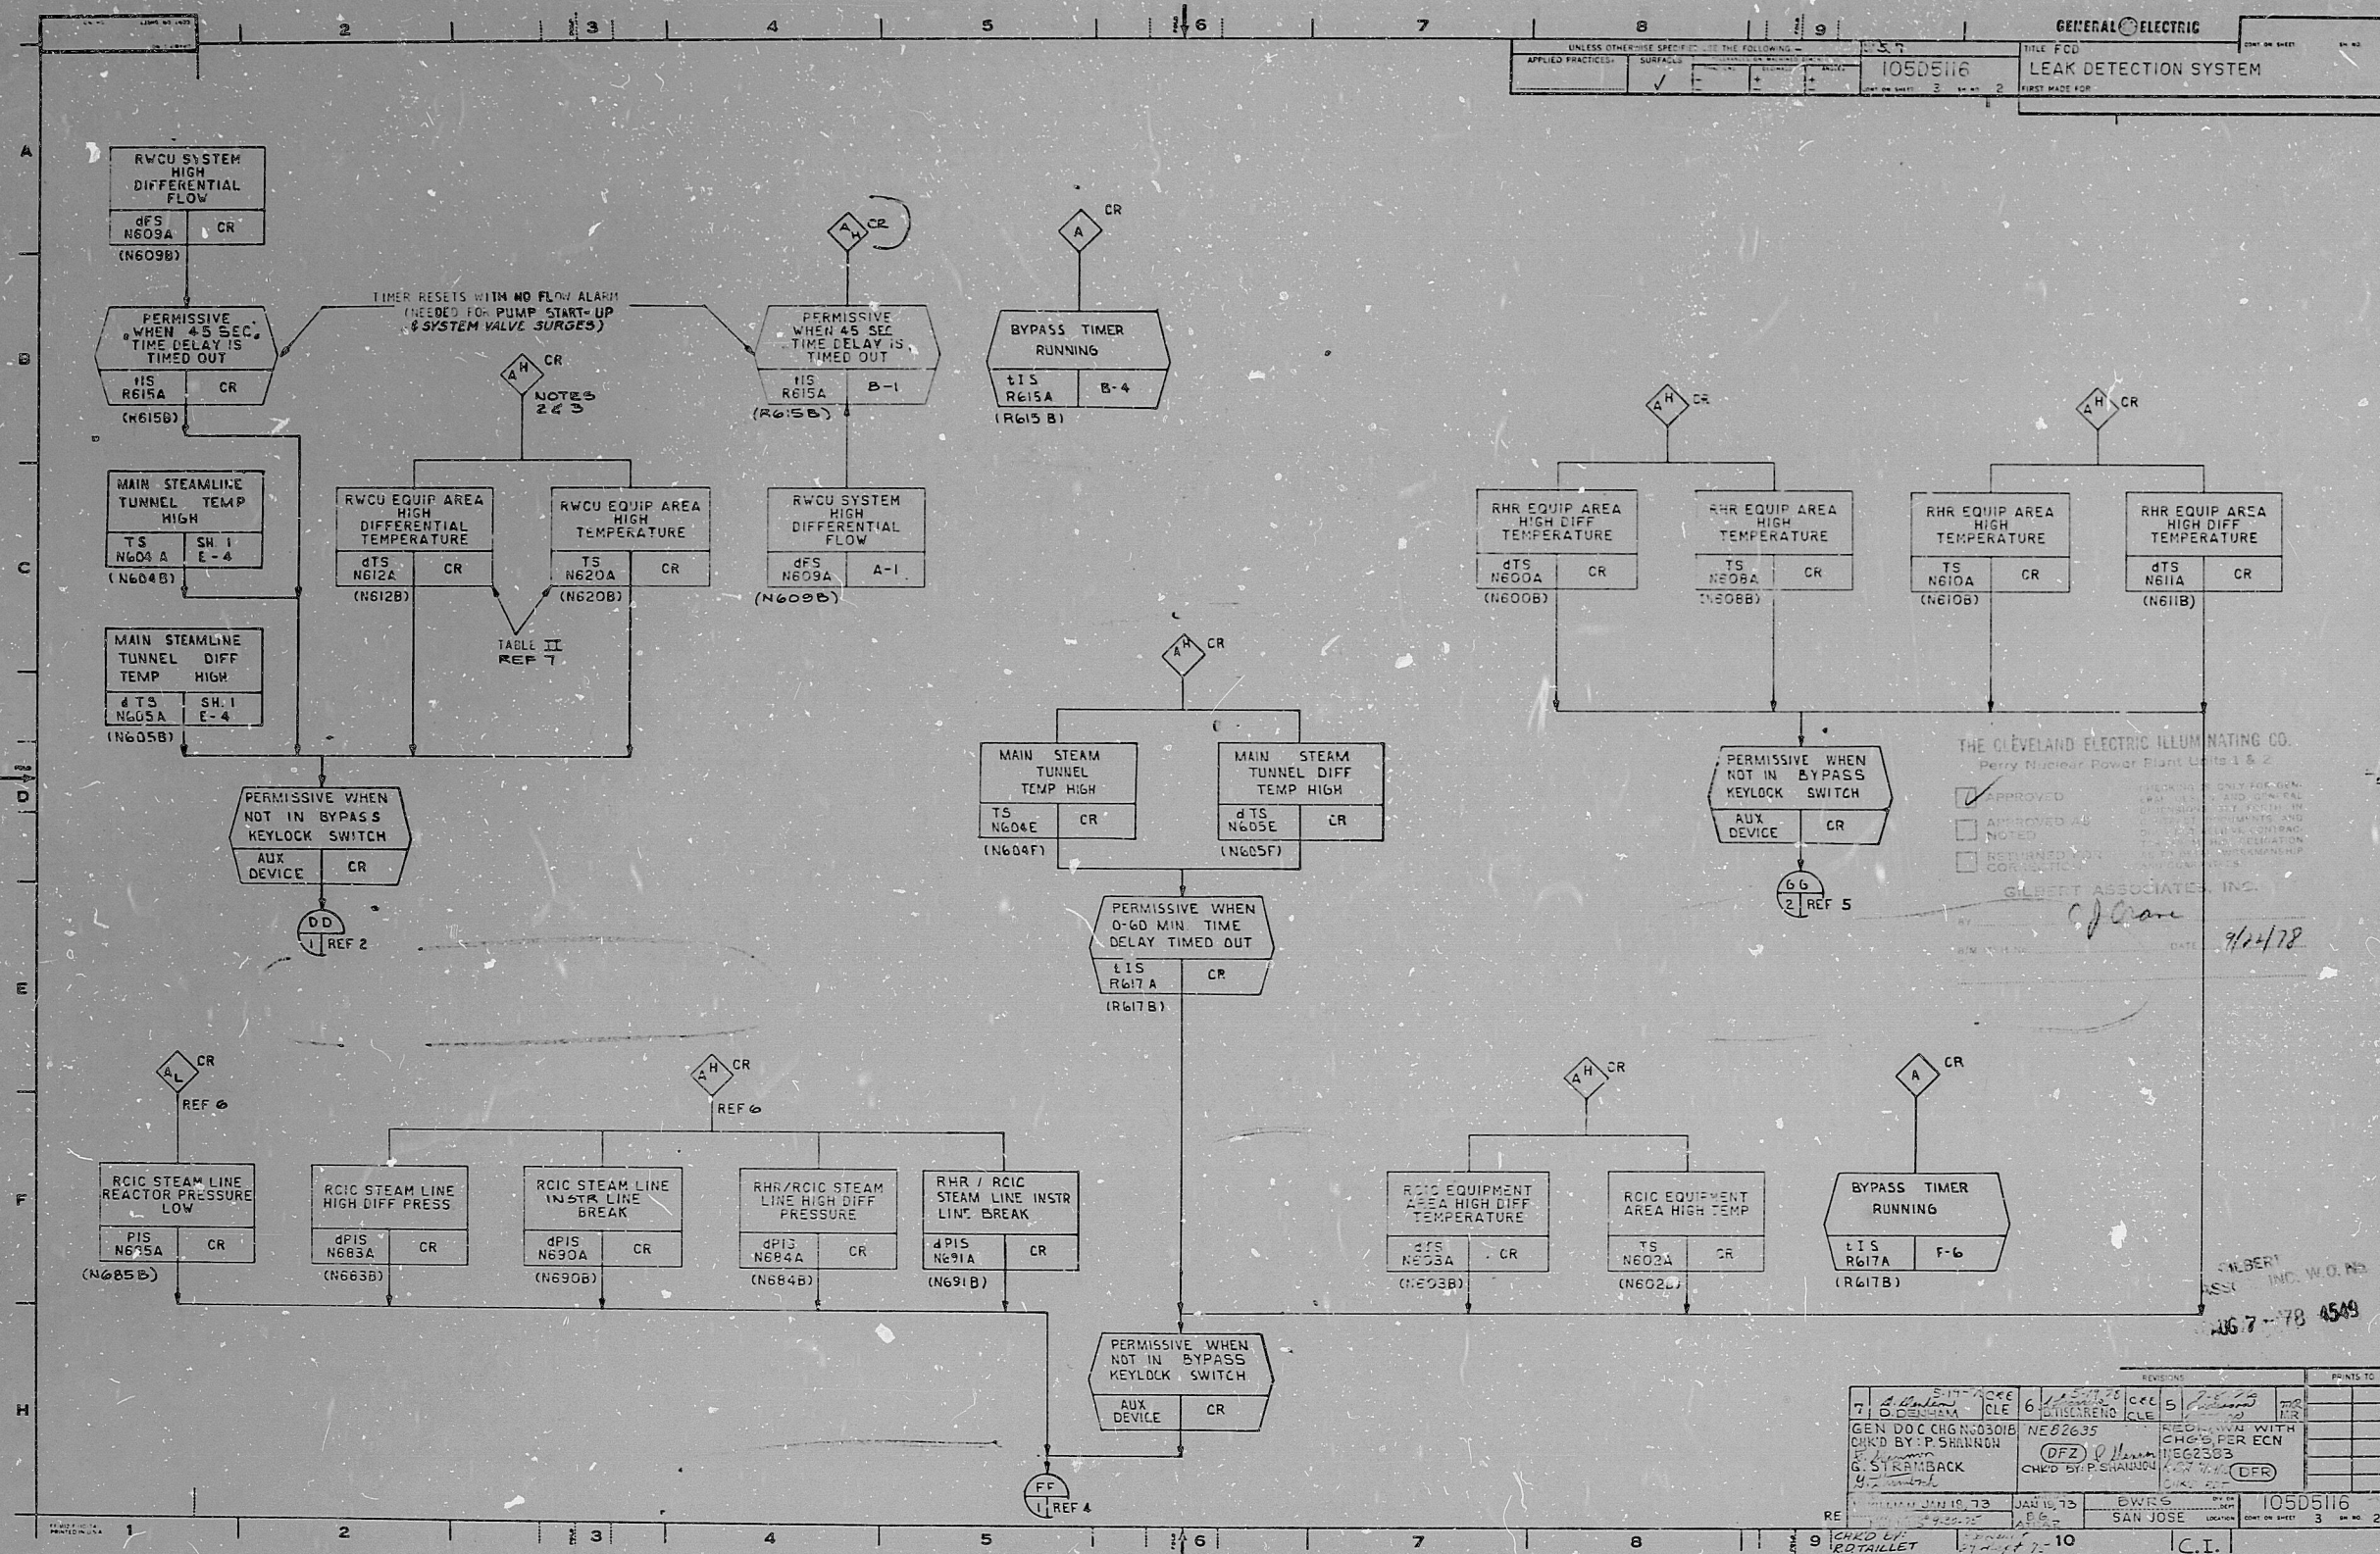

8104060881

