


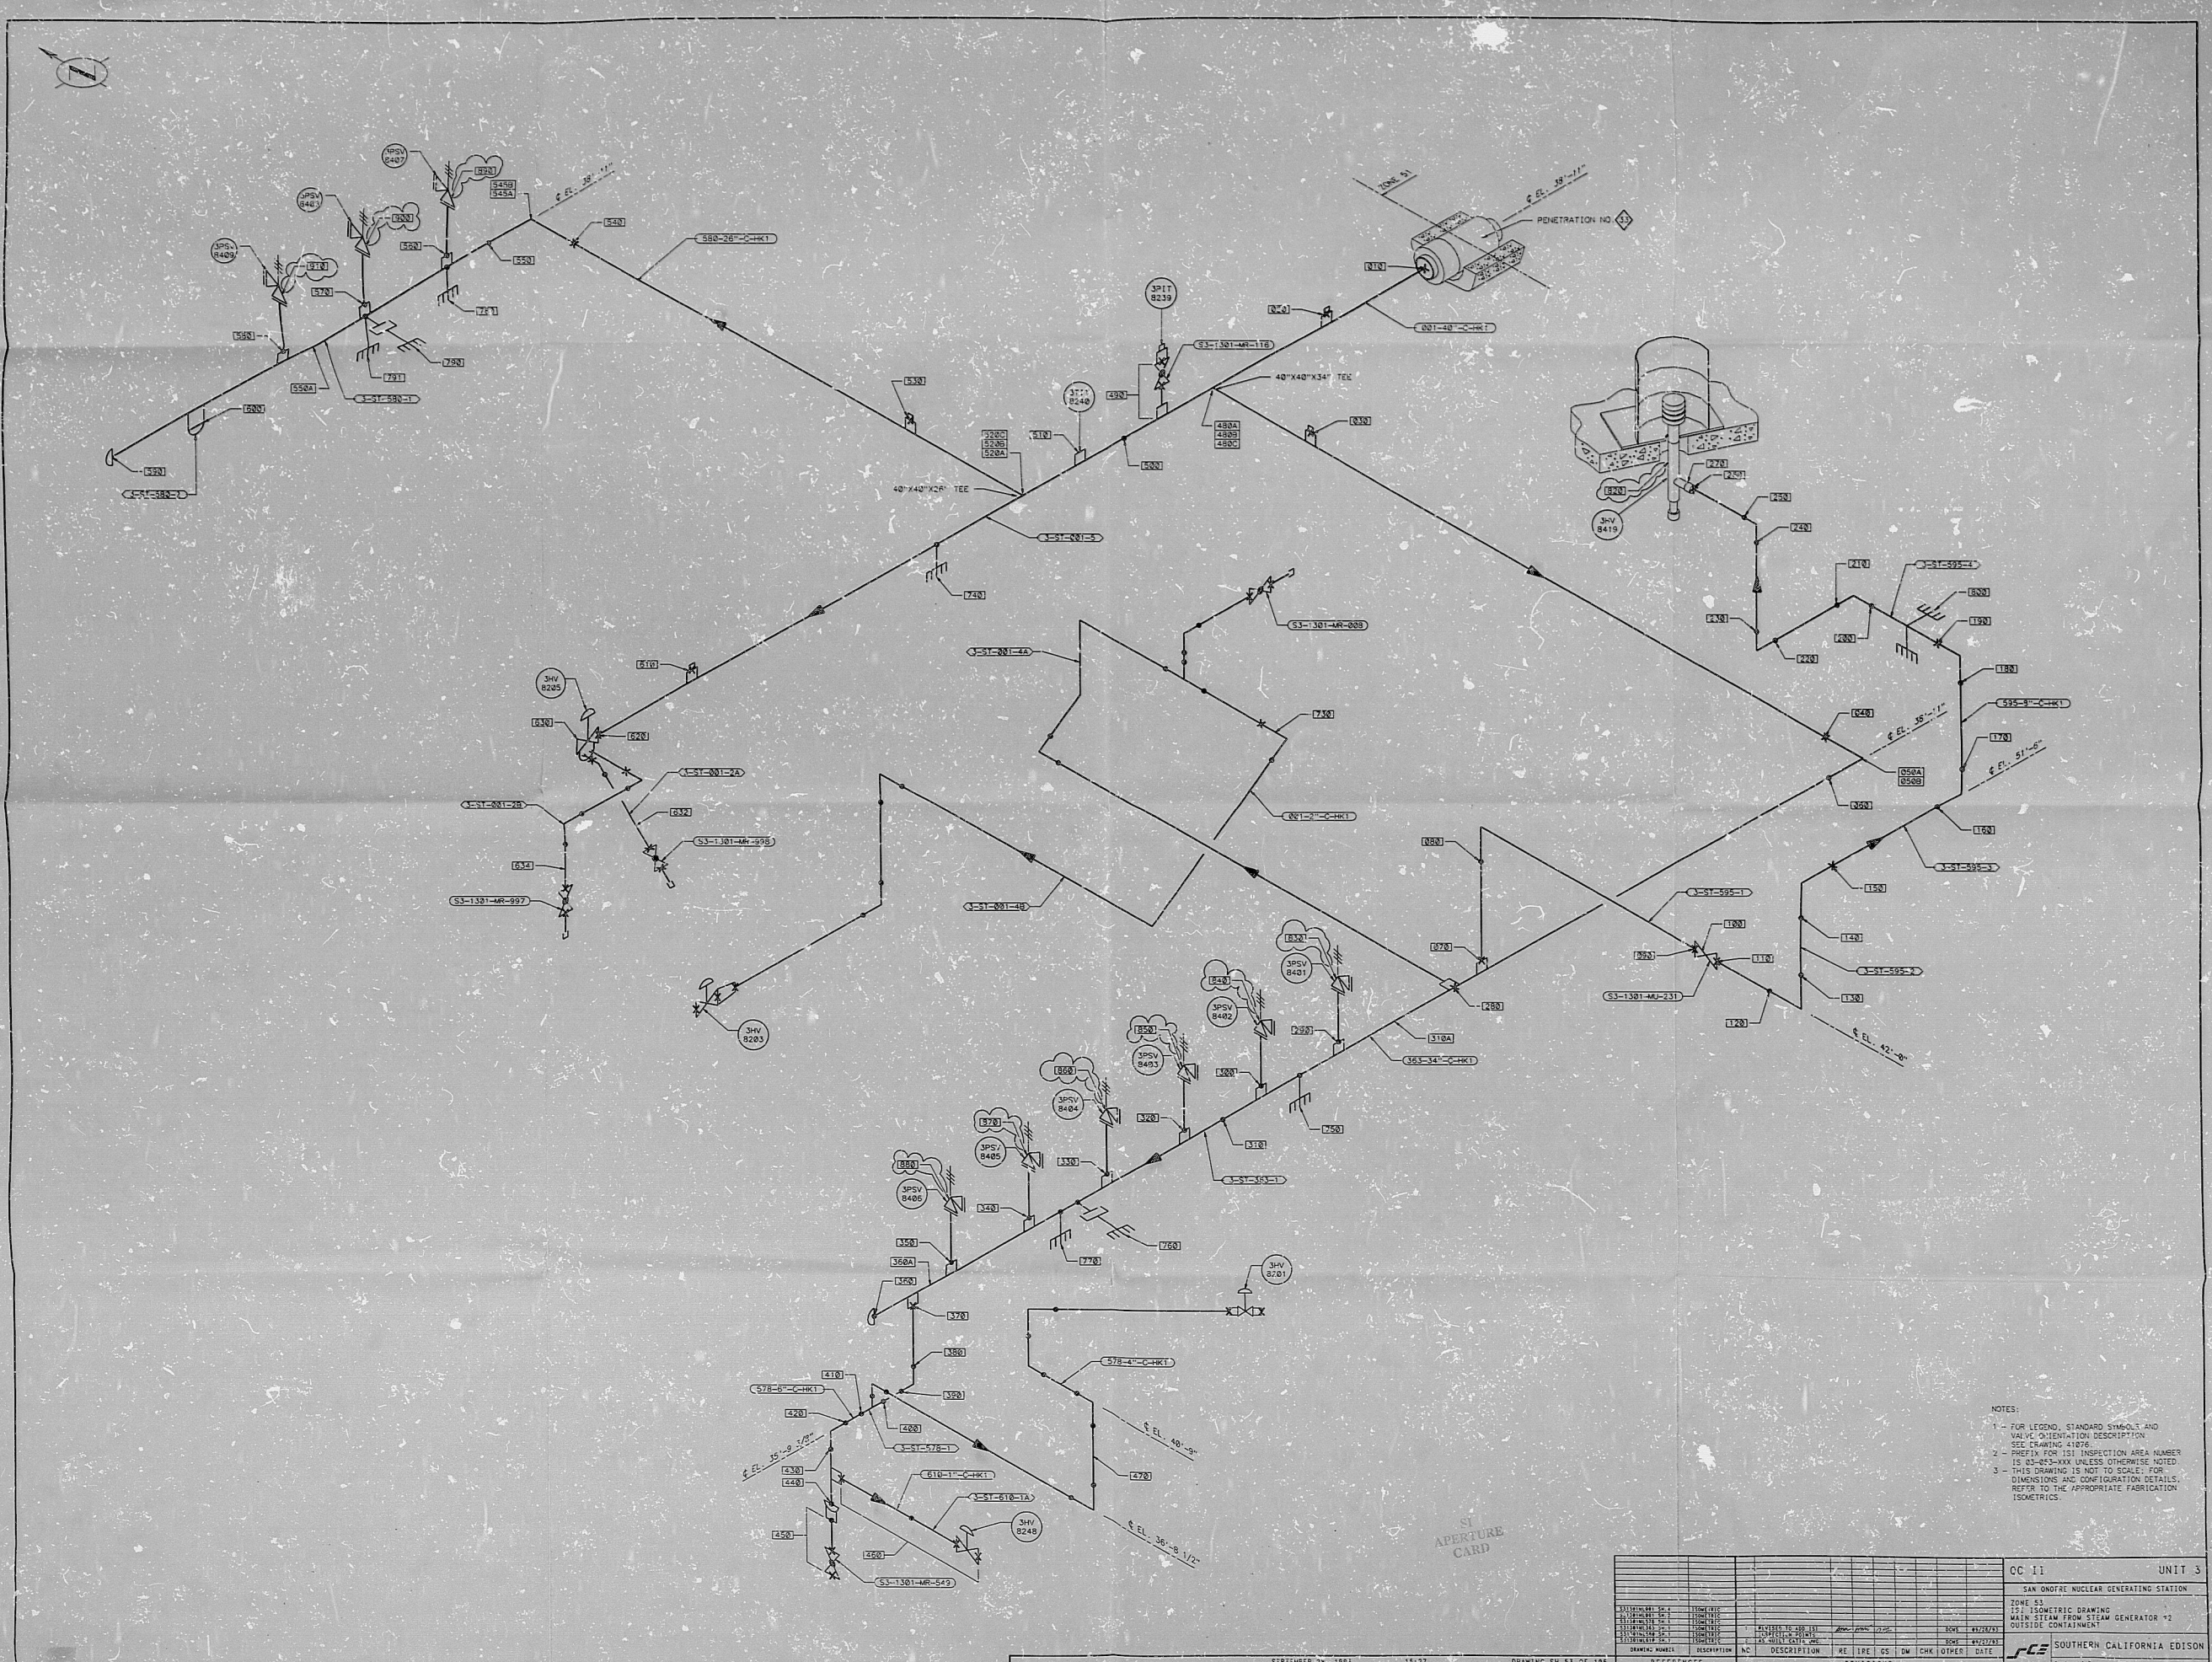


NOTES:
 1 - FOR LEGEND, STANDARD SYMBOLS AND
 VALVE ORIENTATION DESCRIPTION
 SEE DRAWING 41076.
 2 - PREFIX FOR IS1 INSPECTION AREA NUMBER
 IS 03-023-KXX UNLESS OTHERWISE NOTED.
 3 - THIS DRAWING IS NOT TO SCALE. FOR
 DIMENSIONS AND CONFIGURATION DETAILS
 REFER TO THE APPROPRIATE FABRICATION
 ISOMETRICS.

SI
 APERTURE
 CARD

		OC 11		UNIT 3	
		SAN ONOFRE NUCLEAR GENERATING STATION			
		ZONE 53			
		121 ISOMETRIC DRAWING			
		MAIN STEAM FROM STEAM GENERATOR #2			
		OUTSIDE CONTAINMENT			
SOUTHERN CALIFORNIA EDISON		DATE: 01/27/73			
PDR KIDS.

9311190316

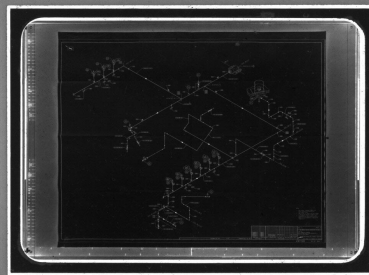

9311190316