




(G) 2002

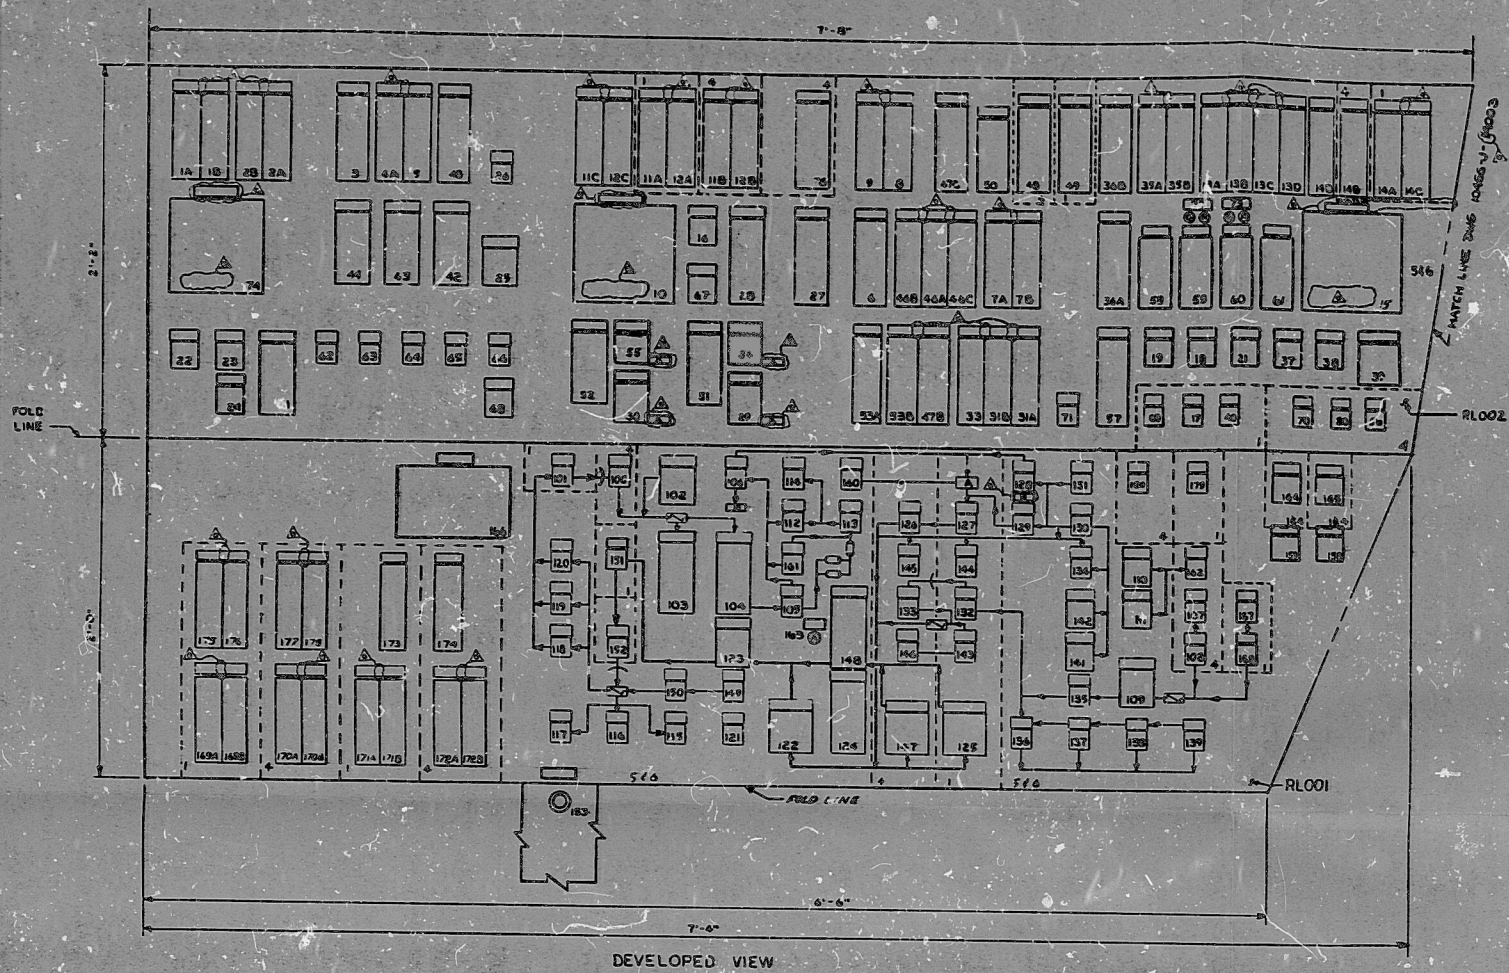

DEVELOPED VIEW

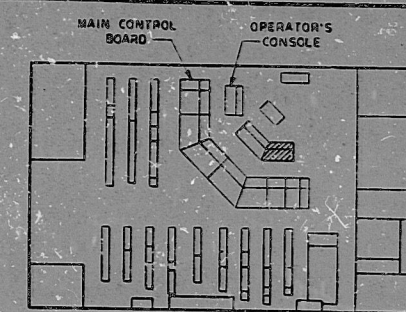

KEY PLAN
CONTROL ROOM
EL. 2047'-6"
NTS

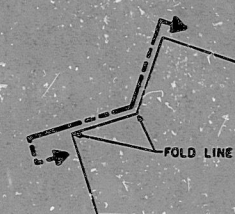

SECTION
OPERATOR'S CONSOLE
NTS

NOTES:

1. SEE DWG 10466-J-04001 FOR ARRANGEMENT OF CONTROL ROOM
2. SEE DWG 10466-J-10016 FOR PANEL BILL OF MATERIAL.
3. SEE DWG 10466-J-10017 FOR NAMEPLATE ENGRAVING LIST.
4. SEE DWG 10466-J-04020 FOR ACCURATE MIMIC LAYOUT.

△ REV. CIV.	NR	NR	NR	NR	NR	NR	NR	NR
FISC.	GEN. OFF.	NORM.	CNV.	RE- MATERIAL	PLN. BUDG.	AREA		

COORDINATION SIGN-OFF

DOCUMENT IDENTIFICATION : -14002 (D)

TI
'APERTURE'
CARD

REVIEW LEVEL 1

NO. DATE		REVISIONS	BY	CHKD	DATE	APP'D	DATE
SCALE 3"=1'		DATE "11-77" DESIGNED BY		DRAWN		REV'D	
BECHTEL BATHURSTON WARTLAND							
SNUPPS REACTOR COOLANT AND SUPPORT SYSTEM CONSOLE, FLOOD AND RLOOC							
THIS DWG. APPLICABLE TO SNUPPS UNIT 1 ONLY				SPECIFY DRAWING NO. _____			
		JOB NO.		BECHTEL DRAWING NO.		JOB	
		17466		J-14002 (Q)		0	
DRAWING APPLICABLE TO UNITS				1			

I certify that the image contained on this frame was made from the original and regular course of business, on the date stated below and that it is an accurate reproduction of the document(s) submitted in micrographic form.

PDR. RIDS

8506200531

