


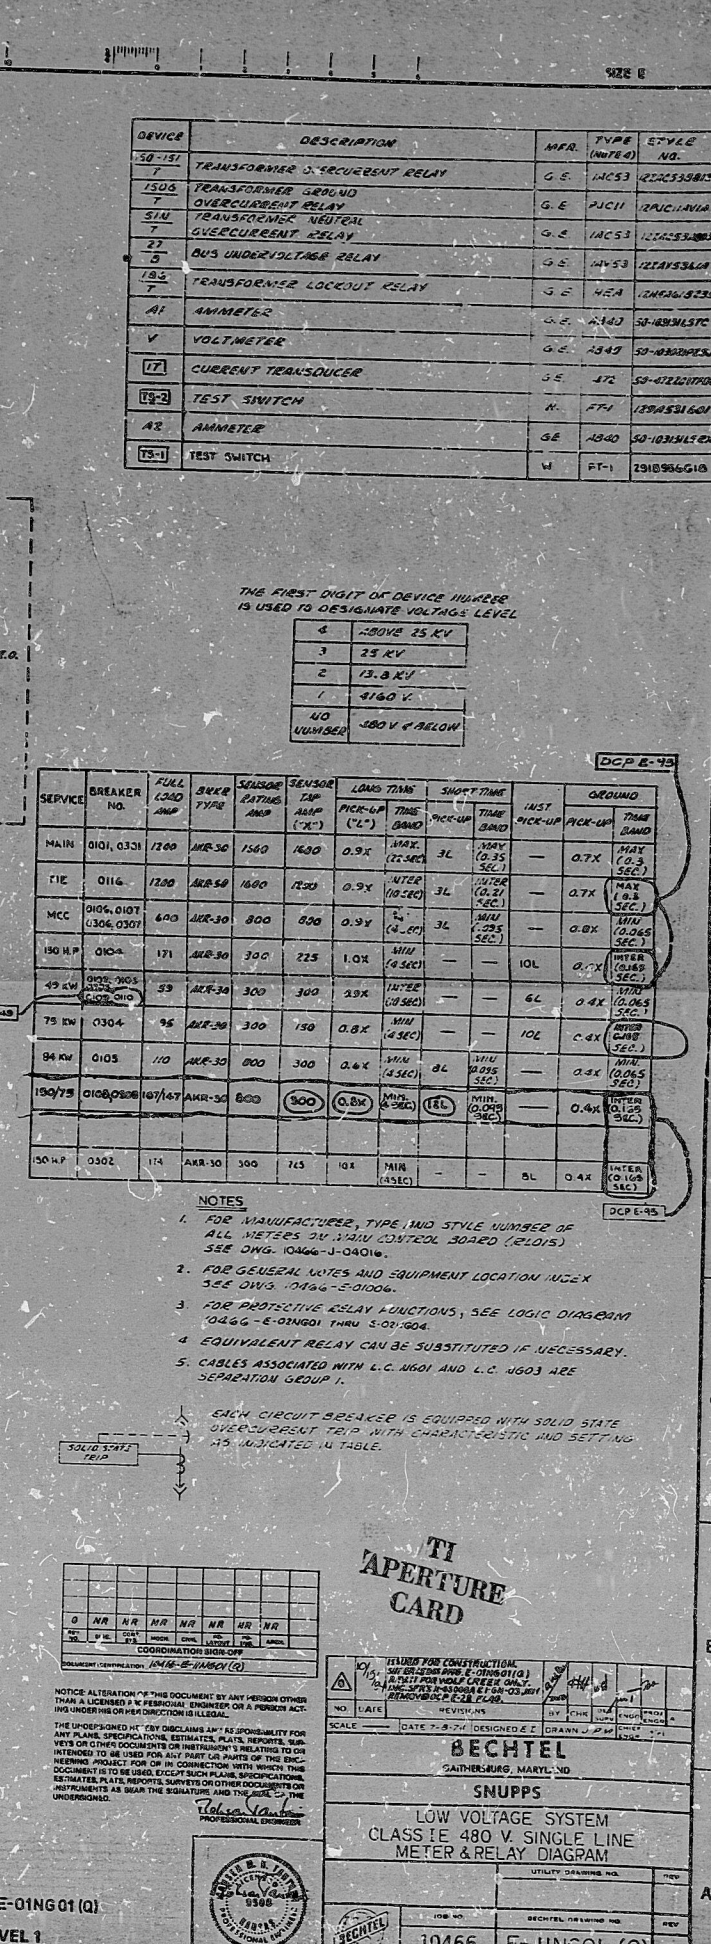

THE FIRST DIGIT OF DEVICE NUMBER
IS USED TO DESIGNATE VOLTAGE LEVEL

4	ABOVE 25 KV
3	25 KV

DCP E-75

SERVICE	BREAKER NO.	FULL LOAD AMP	BULK TYPE	SENSING RATING AMP ("X")	SENSORS CAP AMP ("X")	LONG TIME		SHORT TIME		INST PICK-UP	GROUND	
						PICK-UP ("L")	TRIP BAND	PICK-UP	TRIP BAND		PICK-UP	TRIP BAND

NOTES

4. EQUIVALENT RELAY CAN BE SUBSTITUTED IF NECESSARY.
5. CABLES ASSOCIATED WITH C.C. 1N01 AND C.C. 1N02 ARE

EACH CIRCUIT BREAKER IS EQUIPPED WITH SOLID STATE OVERCURRENT TRIP WITH CHARACTERISTIC AND SETTING AS INDICATED IN TABLE.

[illegible]






[illegible]

SUPERSEDES DWG. E-01NG 01 (Q)
REVIEW LEVEL 1

I certify that the image contained on this frame was made in the normal and regular course of business, on the date stated below and that it is an accurate reproduction of the document(s) submitted to Micrographics.

DATE 10/10/84 OPERATOR W. J. [illegible]

PDR RIDS

8506210018

