J-3135(Q)

SIZE B

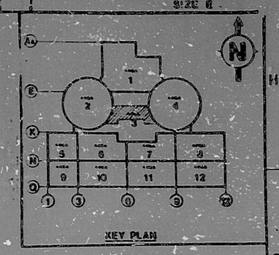

HANGER SCHEDULE

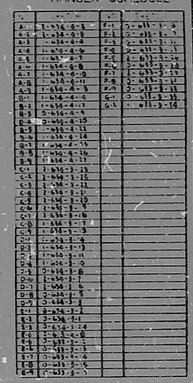

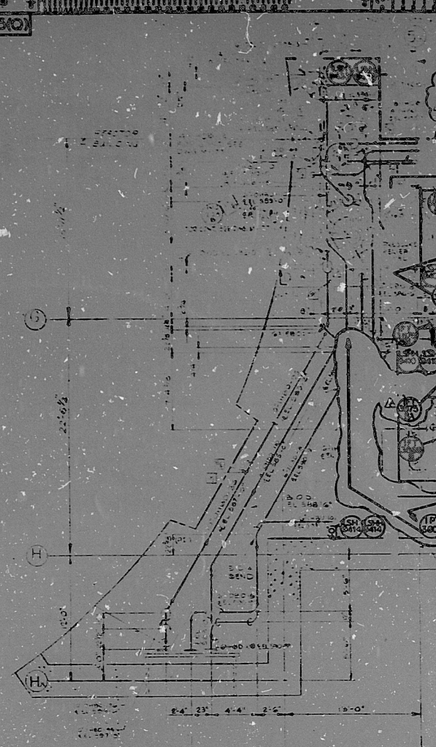

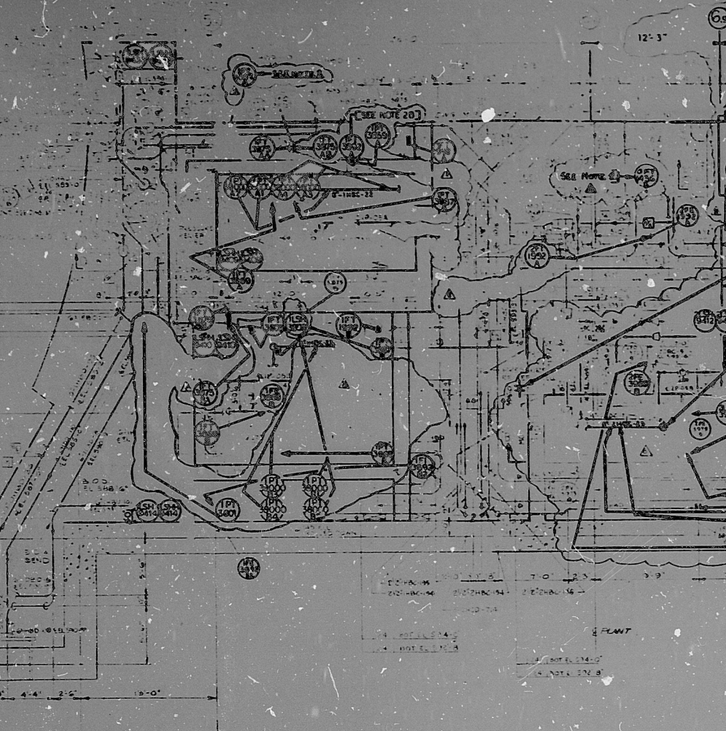

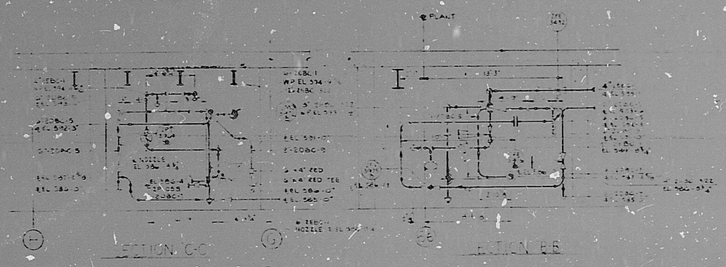

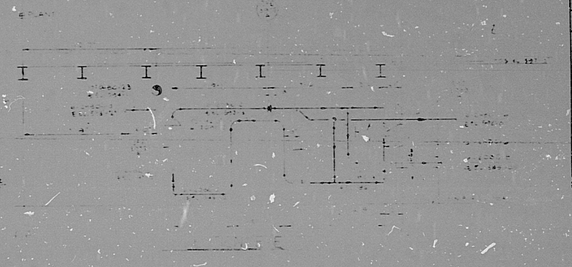

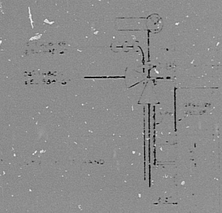

SECTION 'C-C'

SECTION 'B-B'

SECTION 'D-D'

PRC APERTURE CARD

POOR ORIGINAL

30X

SYSTEM STATUS LEDGER

SYSTEM	ISOS	ISSUED P&ID	ISSUED CONST
REACTOR BUILDING SPRAY SYSTEM	M-46 2383-3 M-46 3383-3	3-30-76	6-3-76
DECAY HEAT REMOVAL AND CORE FLOODING SYSTEM	M-46 2419-3 M-46 3419-3	6-28-76	2-27-76
AUXILIARY FEEDWATER SYSTEM	M-46 2419-3 M-46 3419-3	6-28-76	2-27-76
FIRE PROTECTION SYSTEM	M-46 2488-2 M-46 3488-2	7-6-76	12-13-76
CHILLED WATER SYS SAFEGUARDS EQUIPMENT	M-46 2453-3 M-46 3453-3	3-5-76	12-13-76
DEMINERALIZED WATER SYS	M-0071468-ST SB 41-45	3-1-76	
FUEL POOL COOLING & DECAY HEAT SUPPLY & RETURN	M-46 2649 SH 6 M-46 2454	11-19-76 3-30-76	

INSTRUMENT LOCATION DRAWING NOTES:

1. SEE DWG 7220-J-3101(Q) FOR ALL GENERAL NOTES.
2. TAP LOCATIONS FOR THESE INSTRUMENTS ARE SHOWN ON: (A) J-3136(Q), (B) J-3102(Q), (C) J-3103(Q).

9	12-17-76	REVISED AND INCORPORATED FCN J-1147		
8	11-29-76	REVISED AND INCORPORATED FCN J-631, J-635, J-1003		
7	9-28-76	REVISED AS INDICATED PER FCN J-1022		
6	8-13-76	REVISED AS INDICATED		
5	7-30-76	REVISED AS INDICATED		
4	7-9-76	REVISED AND INCORPORATED FCN J-609, AC 873		
3	6-4-76	ISSUED FOR CONSTRUCTION		

BECHTEL

MIDLAND PLANT UNITS 1 & 2
CONSUMERS POWER COMPANY

INSTRUMENT LOCATION DRAWING
AREA 3
PLAN OF EL 584'-0"

JOB NO. 7220 DRAWING NO. J-3135 (Q) REV 9

THIS DRAWING REPRODUCED FROM 7220-M-81(Q) REV. 1
USE THIS DRAWING FOR INSTRUMENT LOCATION ONLY.
FOR ALL OTHER DATA REFER TO APPLICABLE DRAWINGS.

8.5" 11" 17"

RIDS

8207210308

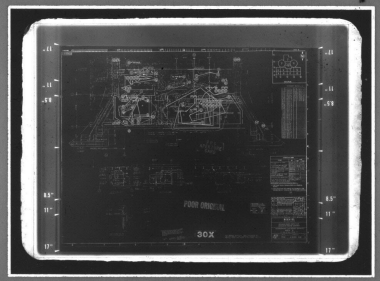

MMM 5824 — FILMSORT* Brand Aperture & Camera Cards and DUPLICARD* Brand Copy Cards — Product of 3M Company, St. Paul, Minn.