


This drawing and the design it contains are the property of BECHTEL. They are hereby loaned and on the borrower's agreement that they will not be reproduced, copied, loaned, exhibited, or used except in the manner and for the purpose intended by the lender to the borrower.

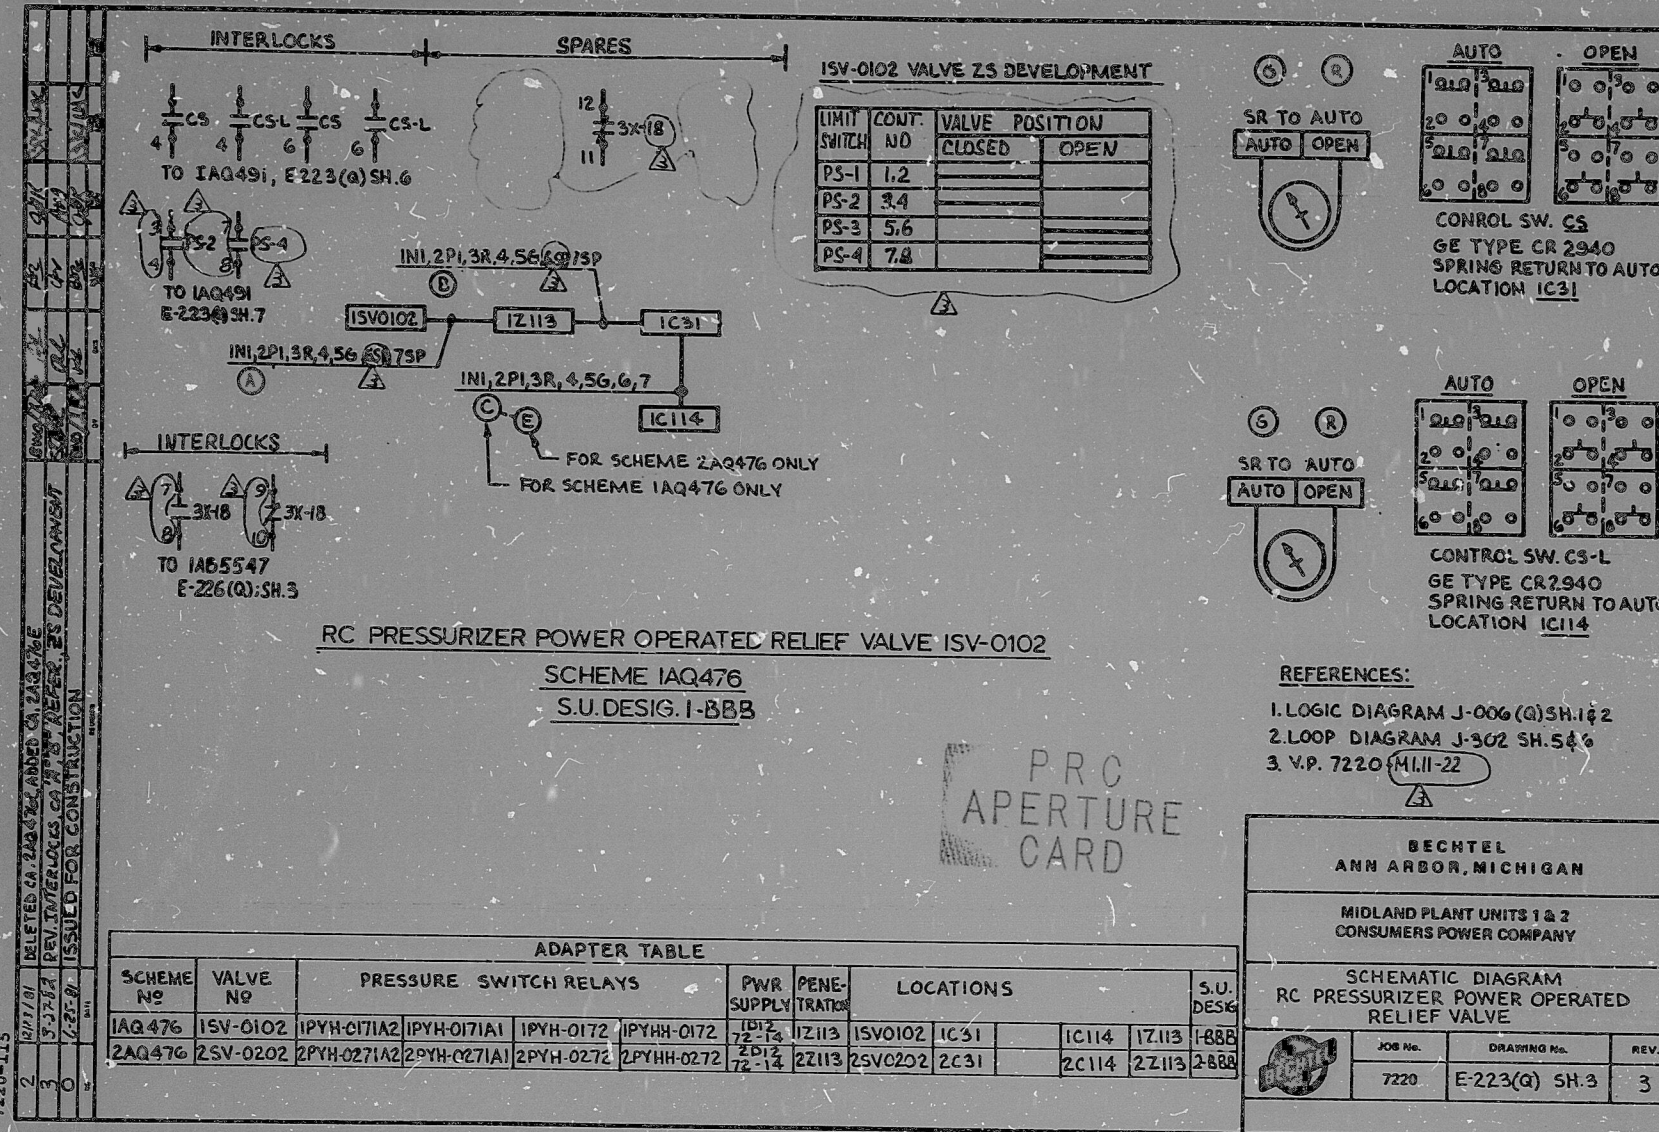

"I certify that the image contained on this frame was made in the normal and regular course of business, on the date stated below and that it is an accurate reproduction of the document submitted to the contractor for filming, by Bechtel Power Corporation."

3-31-82 *[Signature]*
DATE CAMERA OPERATOR CONTRACTOR'S SUPERVISOR OR MANAGER

16X

RIDS

8207210478

