


SUPERVISOR JUN 77 CAMERA OPERATOR

This drawing and the design it covers is the property of the Utilities which are participating in the SNUPPS Project. It is loaned on the borrower's express agreement that it will not be reproduced, copied, loaned, exhibited, or used except in the limited way and private use permitted by written consent given by the SNUPPS Utilities to the borrower.

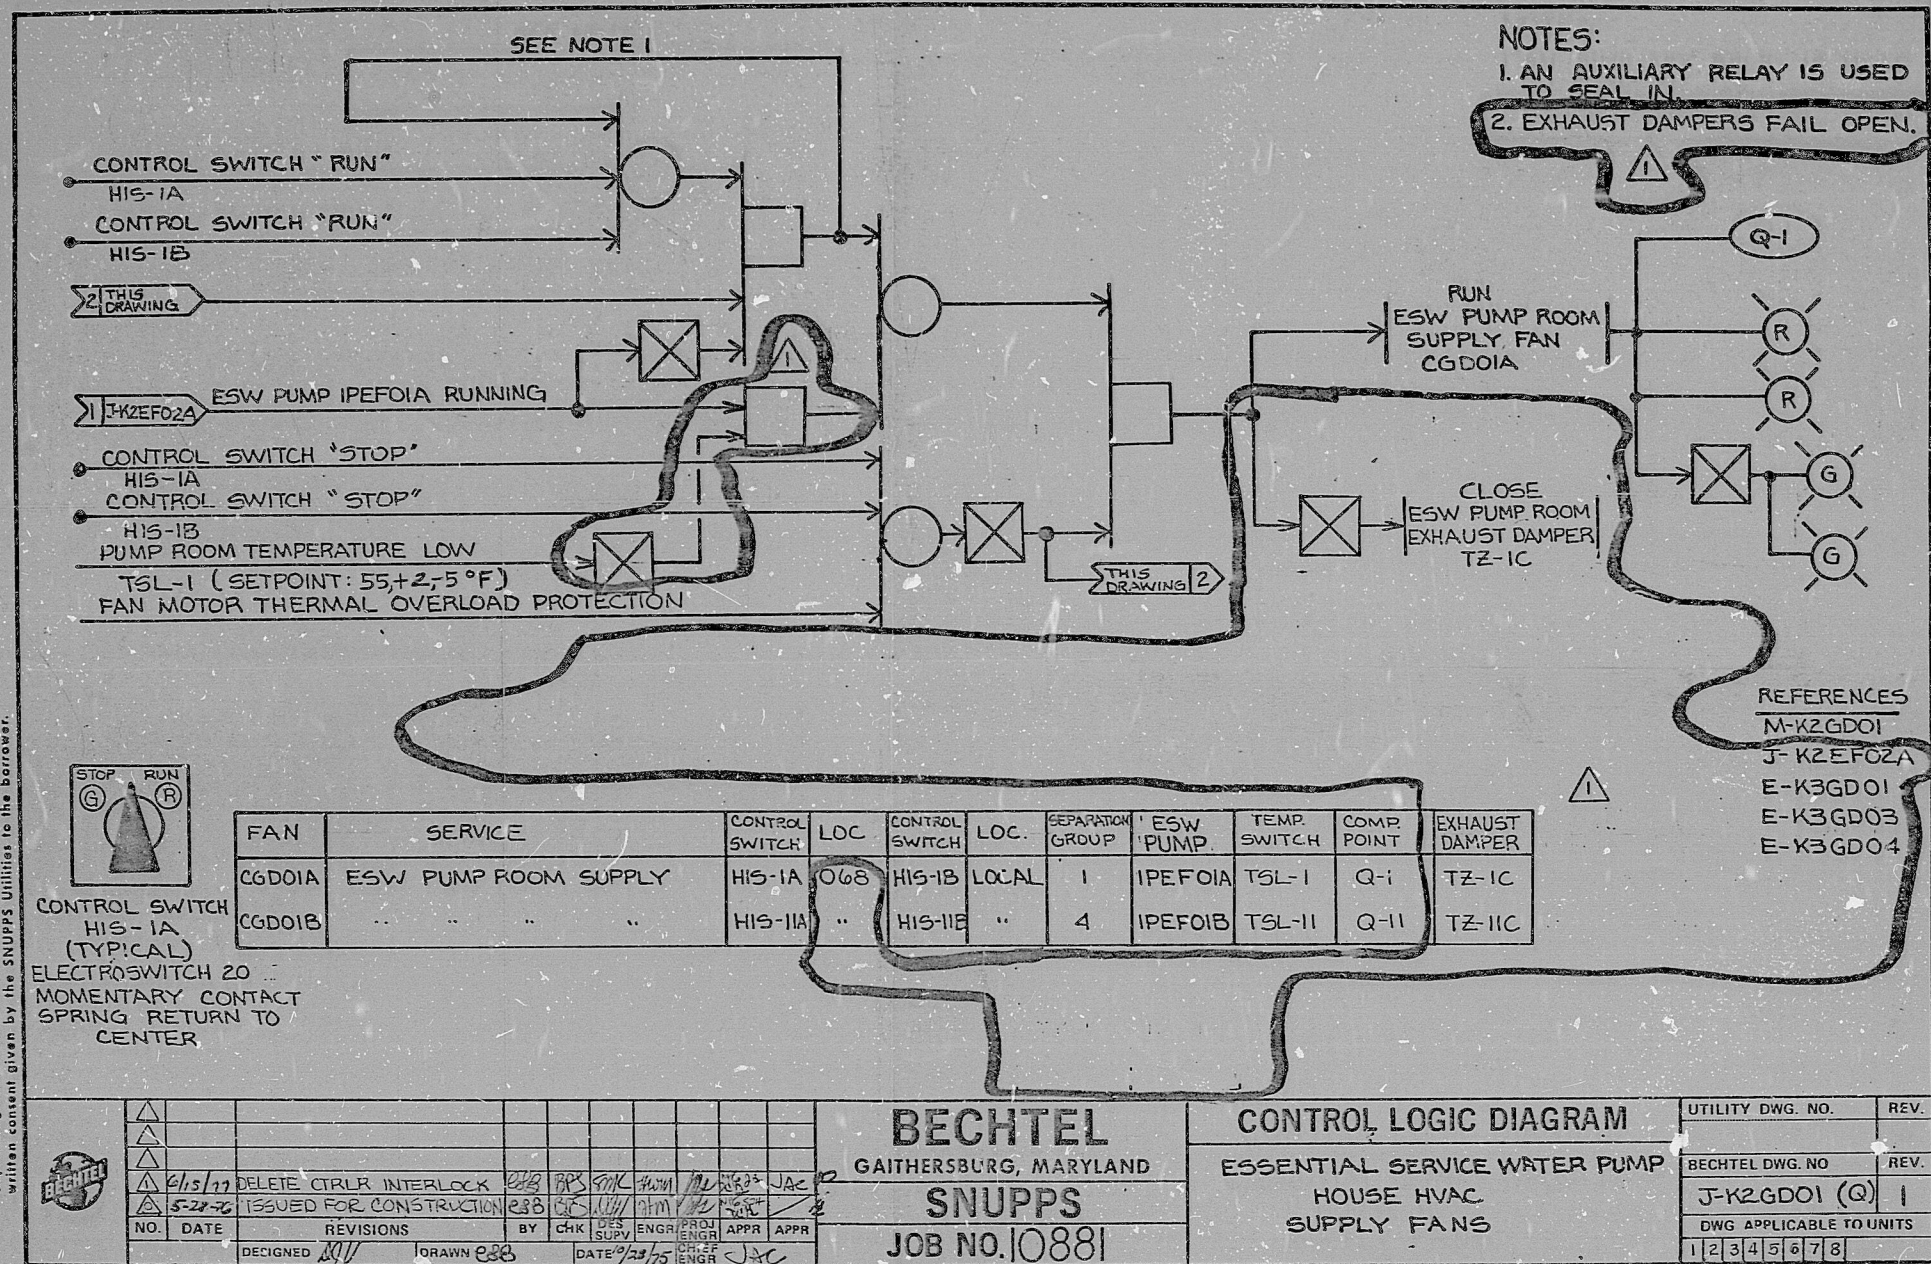

BECHTEL GAITHERSBURG, MARYLAND		CONTROL LOGIC DIAGRAM		UTILITY DWG. NO.	REV.
SNUPPS JOB NO. 10881		ESSENTIAL SERVICE WATER PUMP HOUSE HVAC SUPPLY FANS		BECHTEL DWG. NO.	REV.
DESIGNED <i>[Signature]</i>		DRAWN <i>[Signature]</i>		J-K2GDO1 (Q) 1	
DATE 6/15/77		DATE 6/15/77		DWG APPLICABLE TO UNITS	
REVISIONS		BY		1 2 3 4 5 6 7 8	
NO.		DATE		REVIEW LEVEL 2	

TERA
APERTURE
CARD

RIDS-PDR

8104080071

