
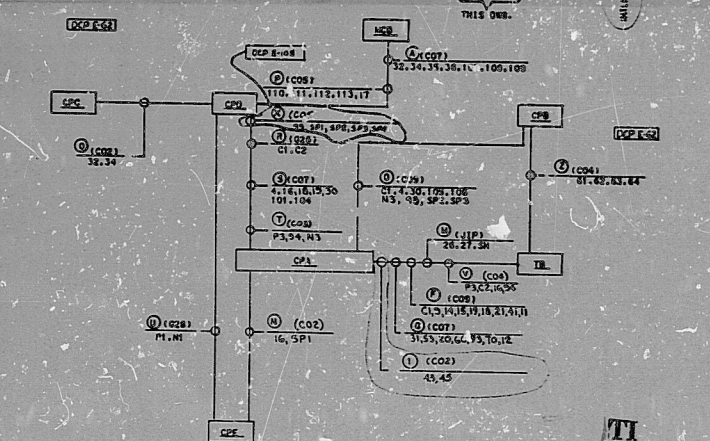
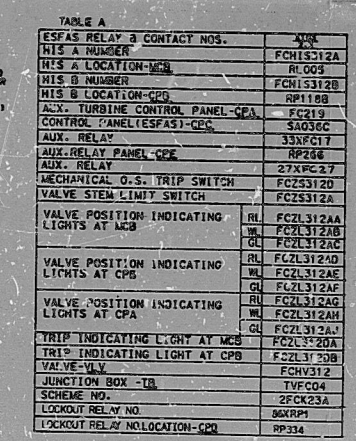



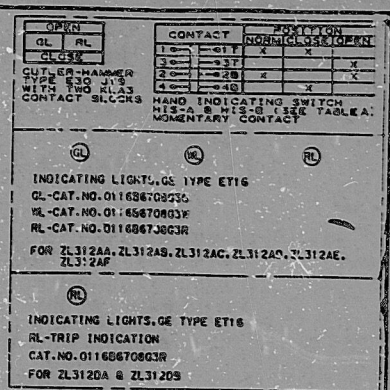


REFERENCE QWGS

M-02F02

1. FIELD TO ADJUST ROTARY SWITCH THAT SWITCHES CLOSURES BETWEEN MAIN CLOSURE AND 5-SEC. TIME INDICATED BY HANDS. WIRING M-021-015.
2. FOR LOCKOUT RELAY CONTACT DEVELOPMENT.
SEE QWGS E-03071
3. TRIP SOLENOID (SOL. 1). SEE V.P. M-021-072.
4. DELETED.
5. CONTACT CLOSURES ON TURBINE OVERSPEED. SEE V.P. QWGS M-021-073, DEVICE (TM2).
6. RAMP START LAMPS SWITCH CONTACTS WHEN VALVE IS FULLY CLOSED. SEE QWGS E-03072
7. POSITION SWITCHES ARE SHOWN AS THEY WOULD BE WITH MAIN VALVE IN THE FULL CLOSED POSITION.
8. JUMPER TO BE ADDED PRIOR TO CORE LOADING.
9. CONTACT CLOSURES ON AUX. FEEDPAST ACTUATION SIGNAL.
SEE TABLE A 8 REITER BECHTEL V.P. J-104-0018.
10. CONTACT CLOSURES AT TURBINE HIGH SPEED. SEE V.P. QWGS M-021-073, DEVICE (TM2).
11. CONTACT CLOSURES AT TURBINE LOW SPEED. SEE V.P. QWGS M-021-073, DEVICE (TM2).
12. VENDOR (TERRY CO.) DESIGNATIONS SHOWN IN PARENTHESES.

NOTES:

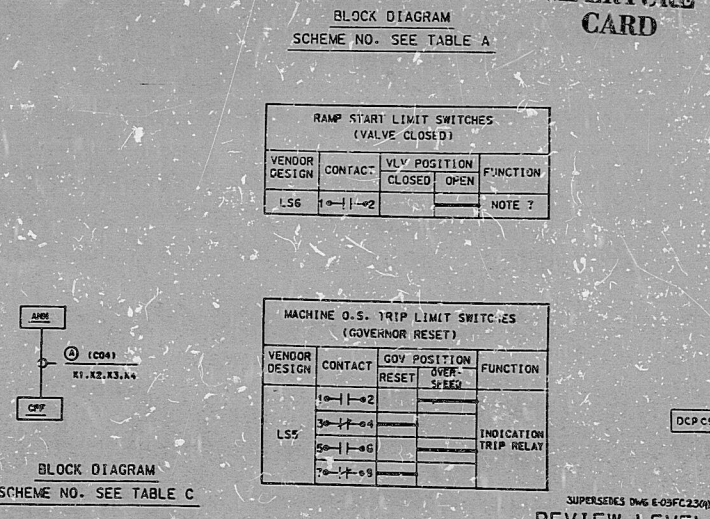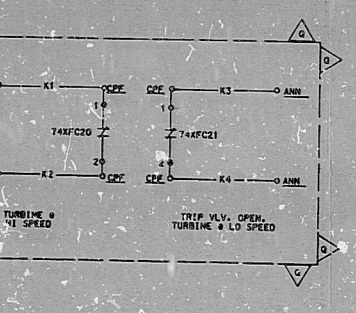[illegible][illegible]

I certify that the image contained on this frame was made in the normal and regular course of business, on the date stated below and that it is

PDR RIDs

8506260002

