


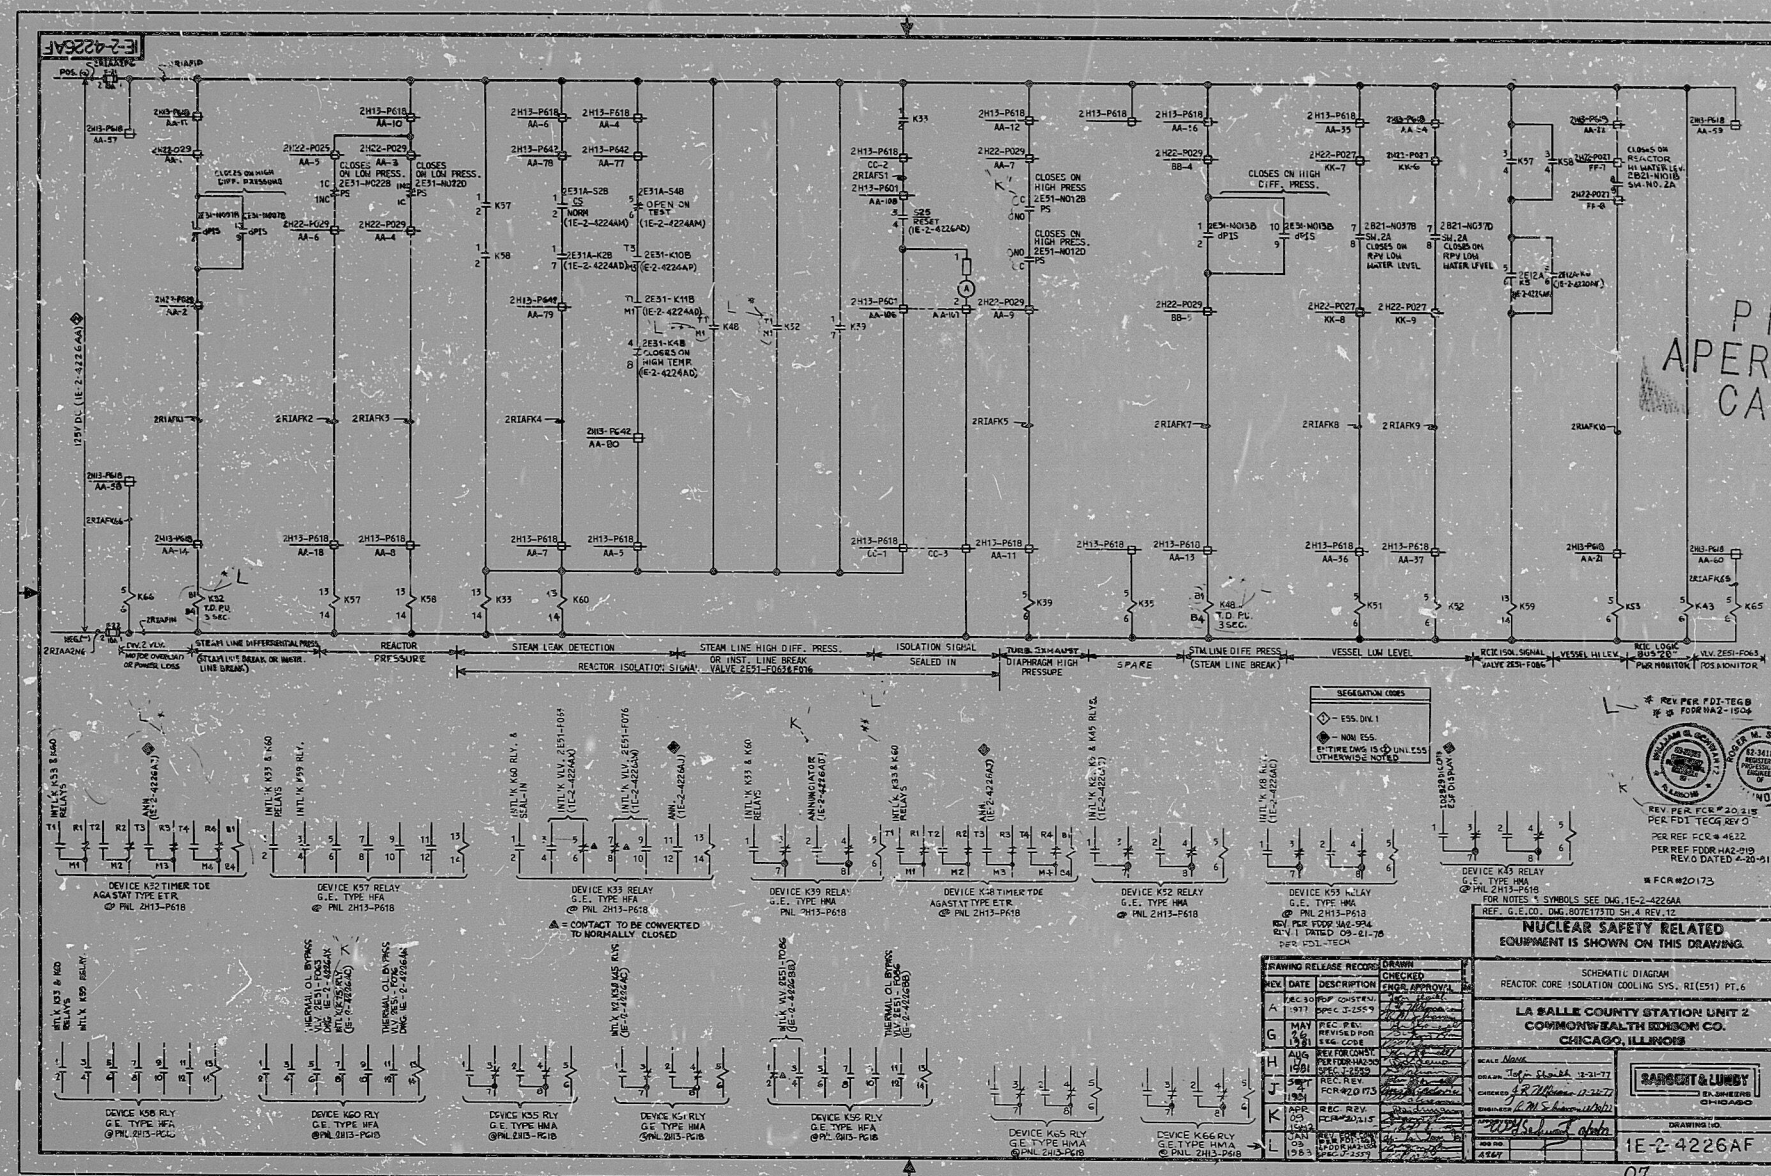

RID's

8309020257

