

This drawing and the design it covers is the property of the utilities which are participating in the SUTRS Project. It is loaned on the borrower's express agreement that it will not be reproduced, copied, loaned, exhibited, or used except in the limited way and private use permitted by written consent given by the SUTRS Utilities to the borrower.



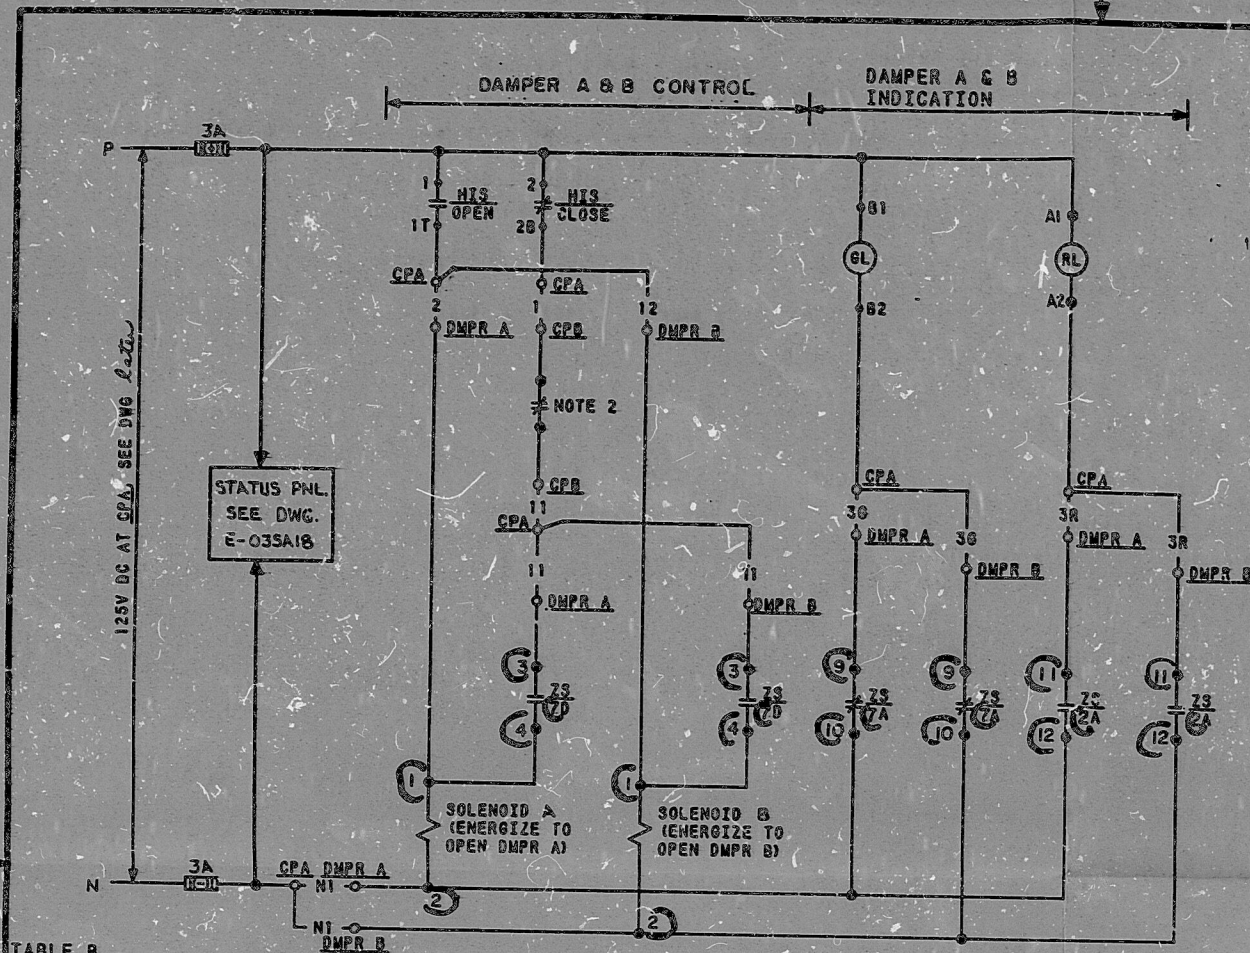


TABLE B	DMPR B	
COMPUTER REF DWG	J-106-0115	J-106-0115
COMPUTER POINT	GKZ133A	GKZ133B
COMPUTER LOC-PC	RJ160A	RJ160A
DAMPER NO.-DMPR	GKHZ133A	GKHZ133B
COMPUTER SCHEME NO.	46KR27A	46KR27B

TABLE A	
ESFAS RELAY A CONTACT NOS.	K126 12
CONTROL PANEL NO.-CPB	SA036B
HIS NUMBER-	GKH3133
HIS LOCATION-CPA	RP068
DAMPER NO.-DMPR B	GKH21338
DAMPER NO.-DMPR A	GKH2133A
SCHEME NO.	4GKK27A

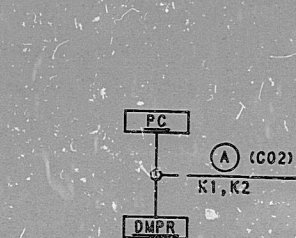

BLOCK DIAGRAM
SCHEME NO.-SEE TABLE B

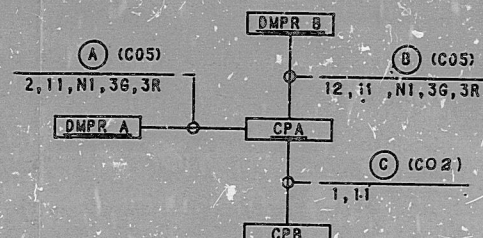

BLOCK DIAGRAM
SCHEME NO.-SEE TABLE A

OPEN	
GL	RL
CLOSE	

CONTACT	POSITION		
	NORM	CLOSE	OPEN
1—11—1T			X
3—11—3T			X
2—11—2B	X		X
4—11—4B	X		X

HAND INDICATING SWITCH
HIS-3E TABLE A
MOMENTARY CONTACT

		LIMIT SWITCH CONTACT DEVELOPMENT				
		DAMPER POSITION				FUNCTION
		PALE CLOSE	OPEN LIMIT	CLOSE LIMIT	PALE CLOSE	
ZS	ROTOR					RED LIGHT
	COIL					SPARE
	STOP					SPARE
	START					NOTE 3
	OPEN					REAL-IN
	PALE					SPARE
	STOP					COMPUTER
	START					GREEN LIGHT
	CLOSE					
	PALE					
	STOP					
	START					

SOLID BAR INDICATES CONTACT CLOSED

REFERENCE DWGS:
M-02GK04
J-02GK24

3. FOR CABLE PULL TO STATUS PANEL
SEE DWG. E-035A20
2. OPENS ON CRVTS SIGNAL SEE TABLE A FOR
RELAY & CONTACT NOS. & REFER BECHTEL
V.P. NO. J-104-0042
1. DAMPERS SHOWN IN FULL
CLOSED POSITION.
- TI

NOTES:

TI
APERTURE
CARD

△	VOIDED										
△	WORKS LIMIT IN CONTACT DEV.	PA	SH	PAR	EL	NR					
△	WORKS IN ROYS 2	PA	SH	PAR	EL	NR					
△	NEW CK. SLK DIAG.	PA	SH	PAR	EL	NR					
△	ISSUED FOR CONSTRUCTION	PA	SH	PAR	EL	NR					
NO.	DATE	REVISION	BY	CHK	DESIGN	APP	ENGR	PROJ	CRSN		
SCALE	~	DESIGNED	DLG	DRAWN	CAD	JAIL	ENGR				
BECHTEL											
GAITHERSBURG, MARYLAND											
SNUPPS											
SCHEMATIC DIAGRAM											
CHASE & TANK AREA ISOLATION											
DAMPERS											
						UTILITY DRAWING NO.	REV.				
						JOB NO.	BECHTEL DRAWING NO.		REV.		
						10486	E-056K27 (Q)		3		
PRINTING APPLICABLE TO UNITS						1 2 3 4 5 6 7 8 9 10					

REVIEW LEVEL 3

① SUPERVISOR *A. L. ...* SEP 79 CAMERA OPERATOR *B. K. ...*

10X

PDR RIDS

8506260168

