


This drawing and the design it covers is the property of the Utilities which are participating in the SNUPPS project. It is loaned on the borrower's express agreement that it will not be reproduced, copied, loaned, exhibited, or used except in the limited way and for the purposes permitted by written consent given by the SNUPPS Utilities of the borrower.

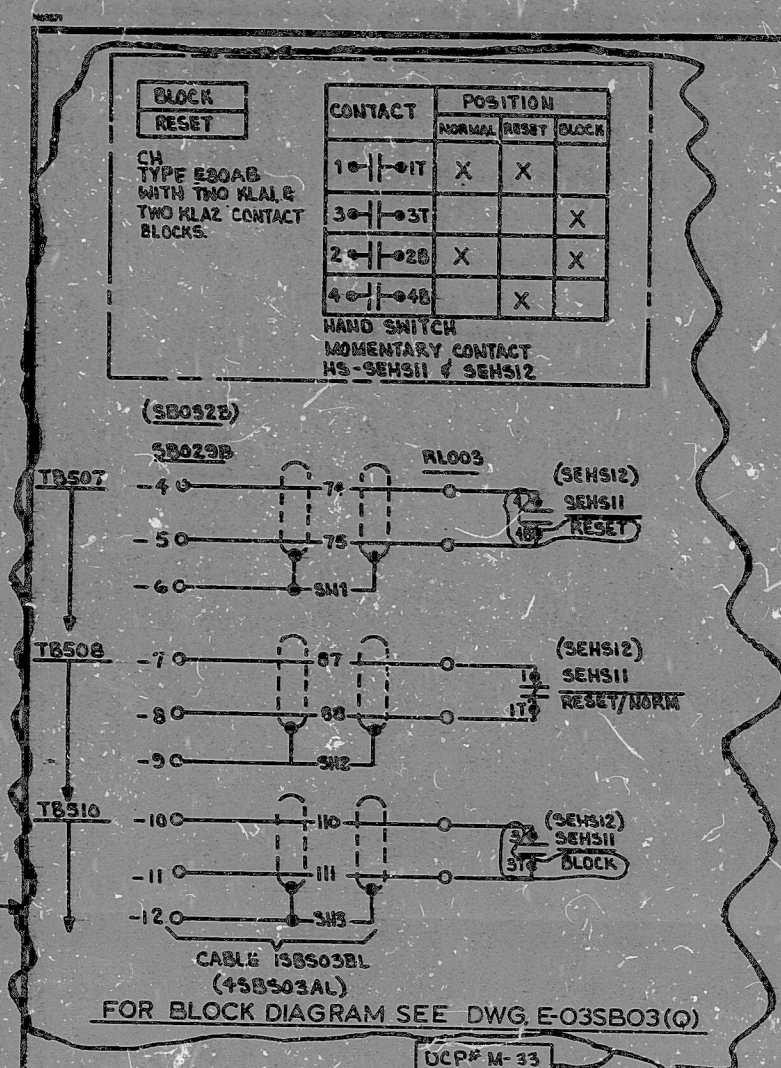

TI  
APERTURE  
CARD

1. DESIGNATIONS NOT IN PARENTHESIS APPLY TO  
SER. GROUP 1. DESIGNATIONS IN PARENTHESIS  
APPLY TO SER. GROUP 4.

NOTES:

|   |          |                |       |                       |    |                      |    |                  |    |                  |    |
|---|----------|----------------|-------|-----------------------|----|----------------------|----|------------------|----|------------------|----|
| ISSUED FOR CONST.                                                                                        |          | SUPERSEDES DWG |       | E-03SB19(Q) REV 1 FOR |    | WOLF-CRICK ONLY INC. |    | IDC PCN 6-146-56 |    | E-03SB19(Q)-1-01 |    |
| DATE   | DESIGNED | BY             | CHECK | DATE                  | BY | DATE                 | BY | DATE             | BY | DATE             | BY |
| SCALE   | DESIGNED | BY             | CHECK | DATE                  | BY | DATE                 | BY | DATE             | BY | DATE             | BY |
| <b>BECHTEL</b><br>GAITHERSBURG, MARYLAND<br><b>SNUPPS</b><br>SCHEMATIC DIAGRAM<br>CONTROL BOARD SWITCHES |          |                |       |                       |    |                      |    |                  |    |                  |    |
| UTILITY DRAWING NO.                                                                                      |          |                |       |                       |    | REV.                 |    |                  |    |                  |    |
| 10400   |          |                |       |                       |    | E-13SB19(Q)          |    |                  |    |                  |    |
| DRAWING APPLICABLE TO UNIT                                                                               |          |                |       |                       |    | 17 x 22              |    |                  |    |                  |    |

SUPERSEDES DWG E-03SB19(Q)  
REVIEW LEVEL 2

I certify that the image contained on this frame was made in the normal  
and regular course of business, on the date stated below and that it is  
an accurate reproduction of the document(s) submitted to Micrographics.  
DATE 8/12/84 OPERATOR *Mike B. Kelly*

16X



PDR RIDS

8506270021

