


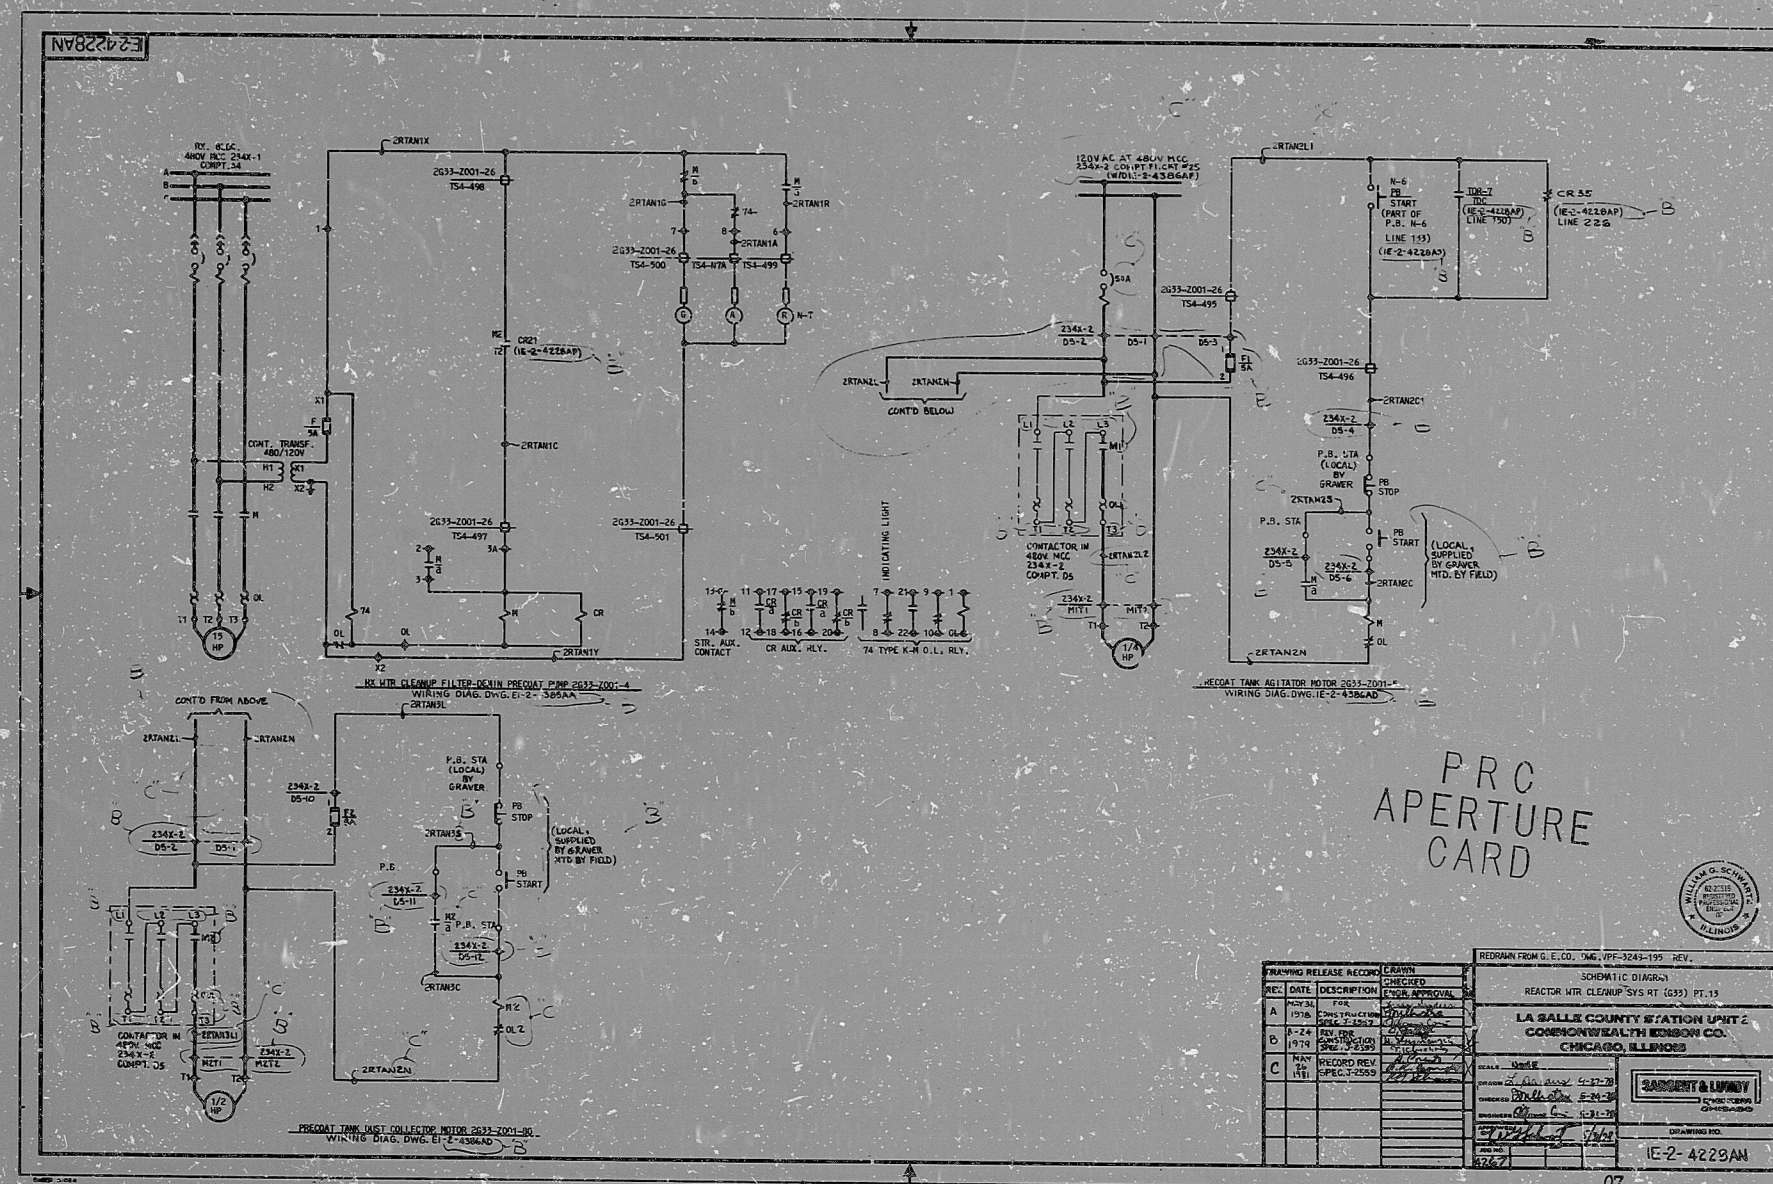



11/15/59

8309060059

