


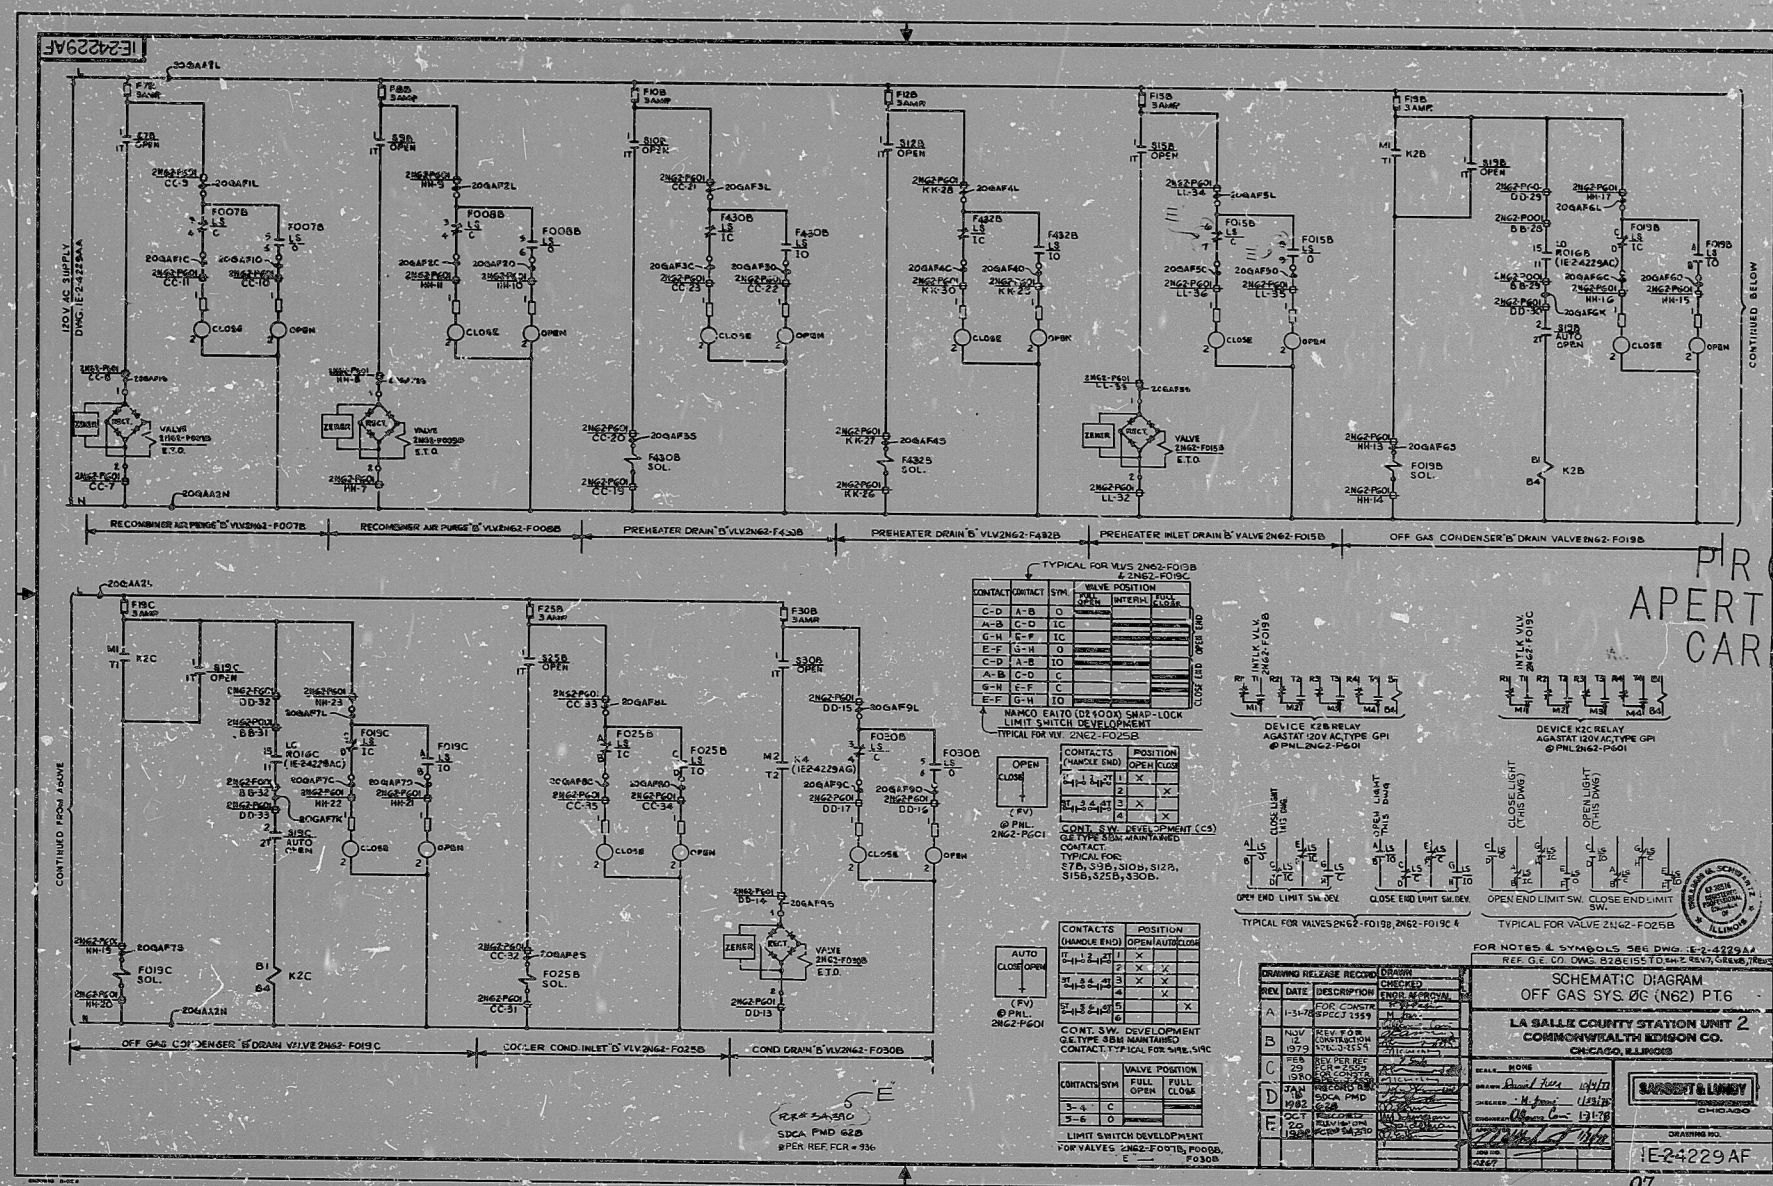

RIDS

8309060081

