


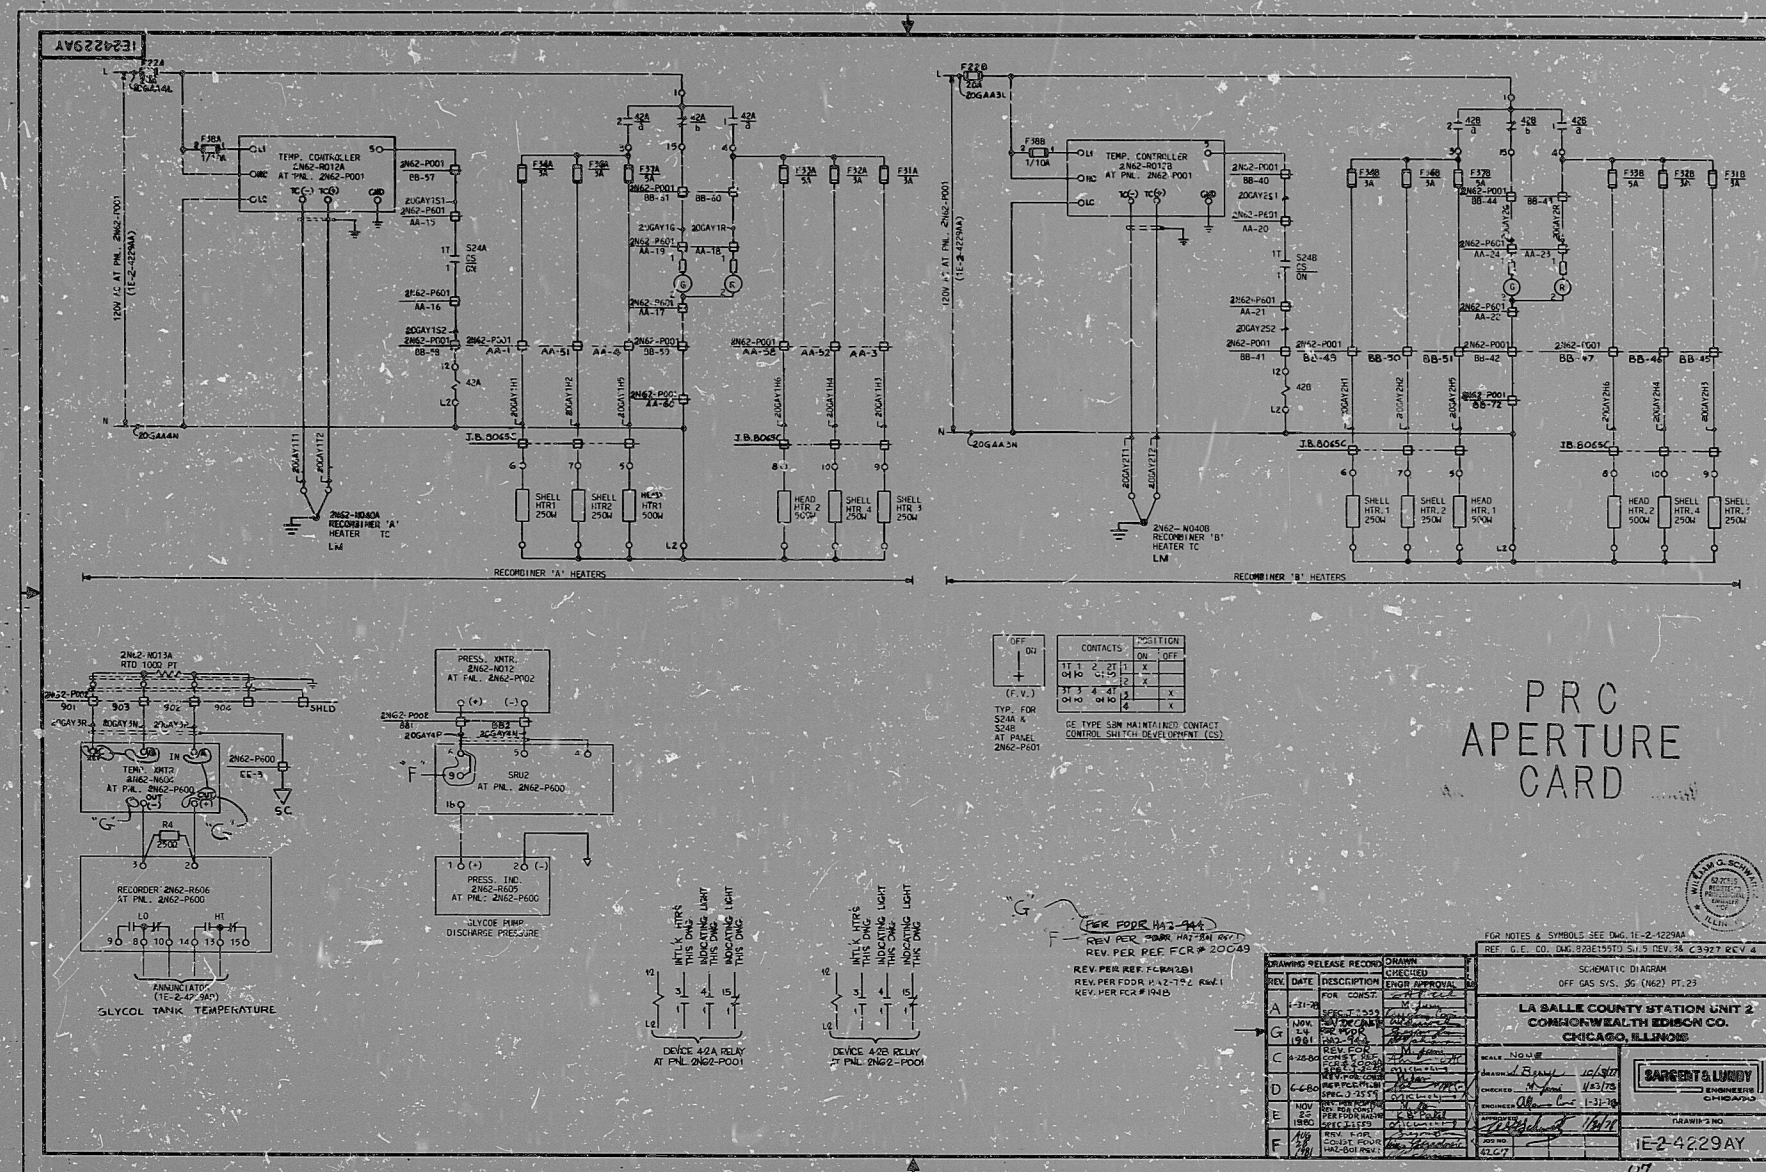

RIDS

8309060114

