LOU-1564 G-161 SHEET 1 OF 2

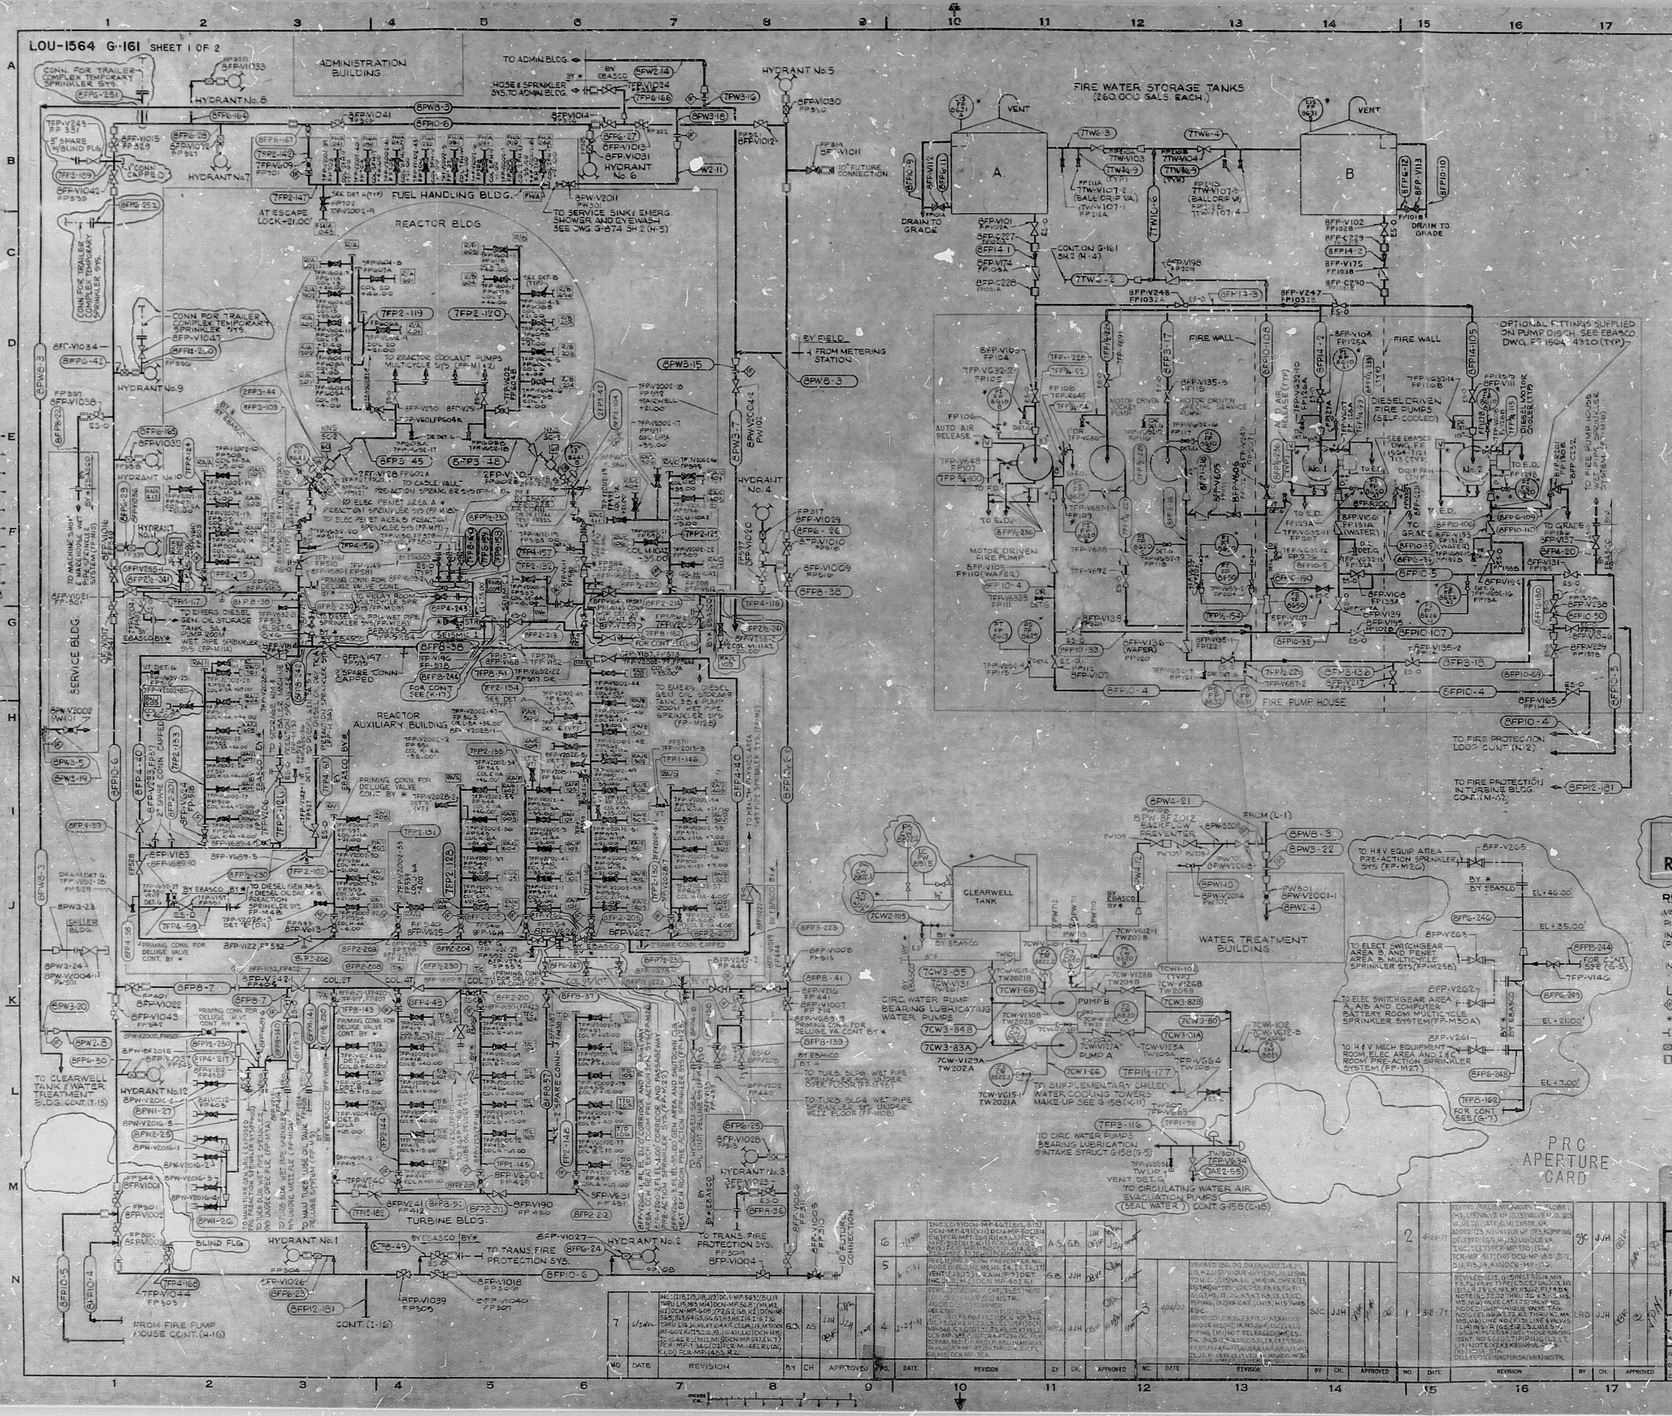

RIDS

8207290238

 

MMM 5824 — FILMSORT* Brand Aperture & Camera Cards and DUPLICARD* Brand Copy Cards — Product of 3M Company, St. Paul, Minn.