




RIDS

8309060177

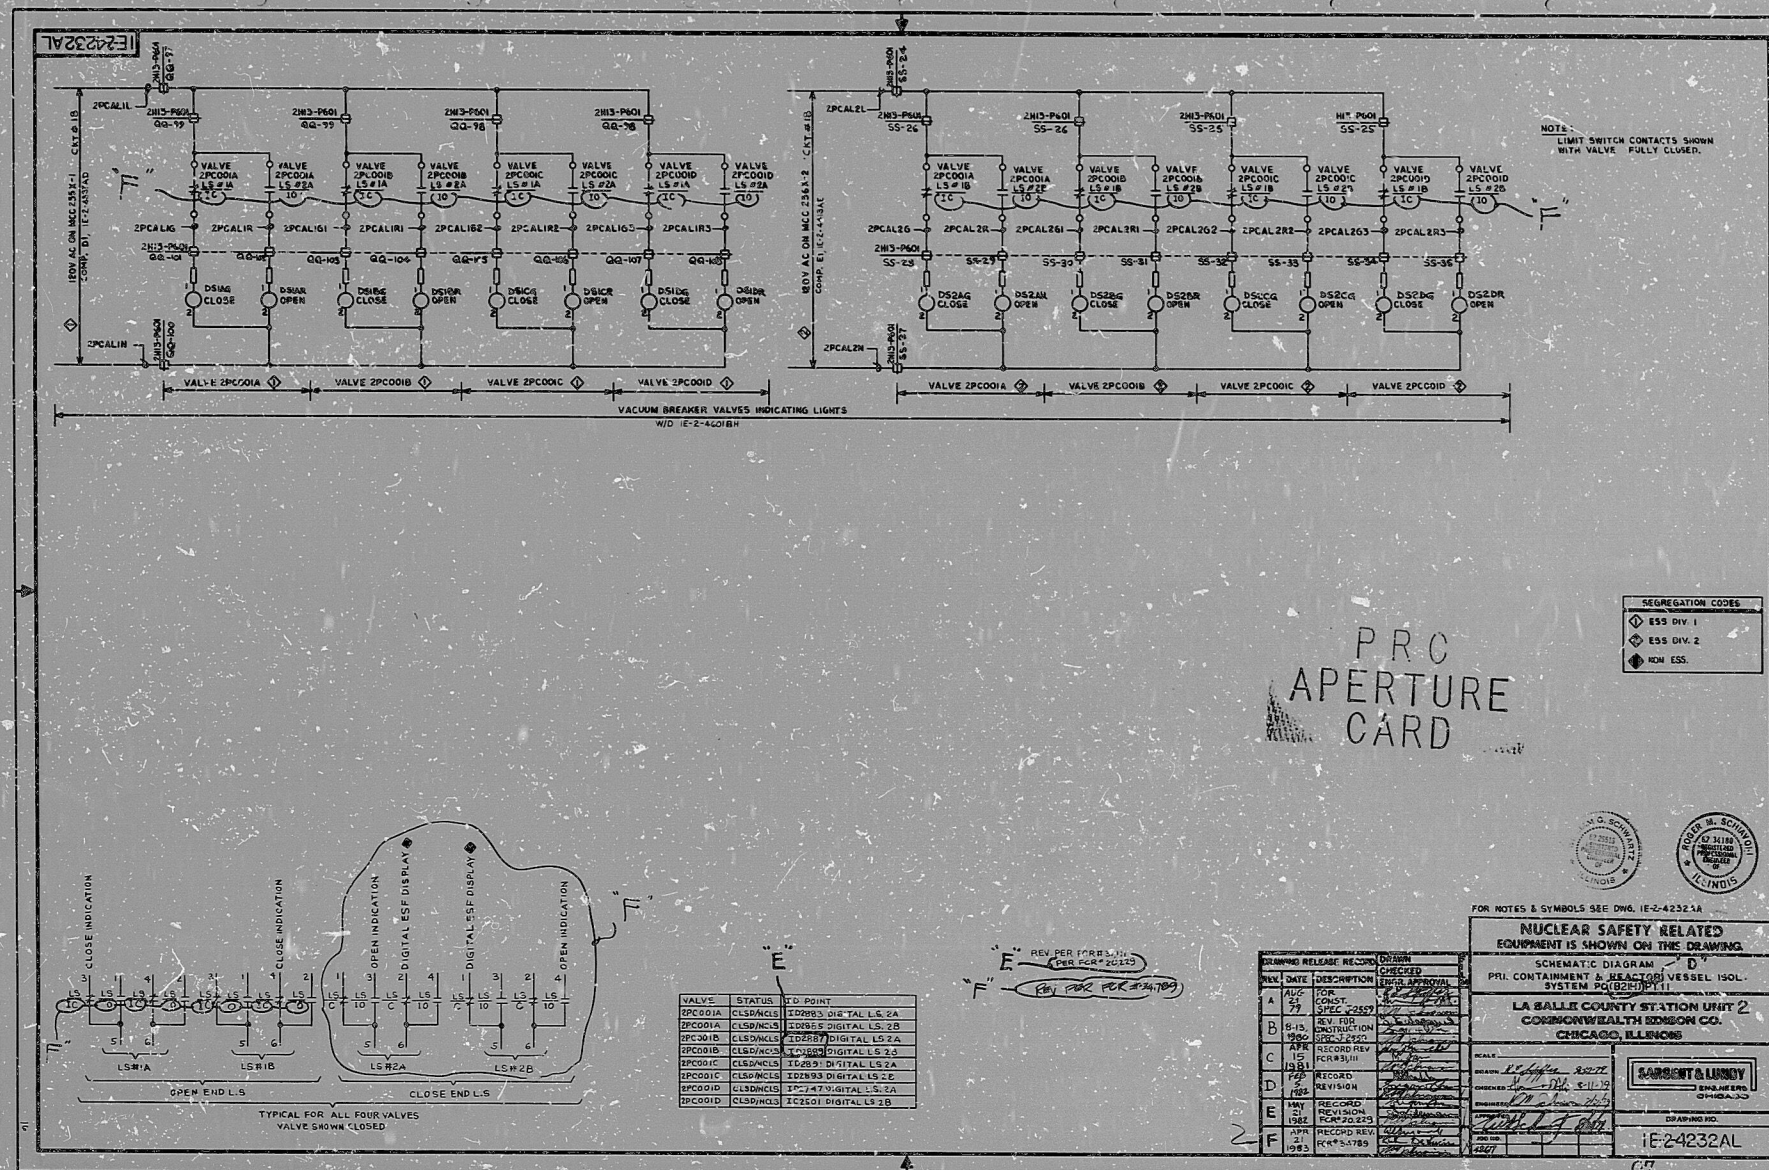