
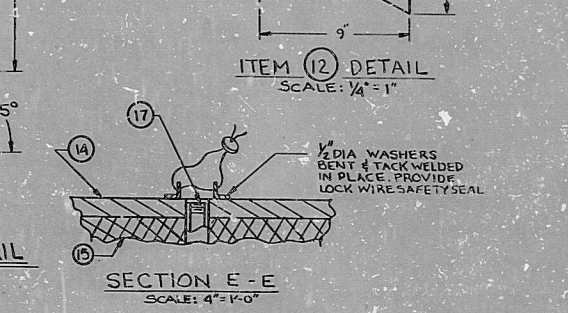
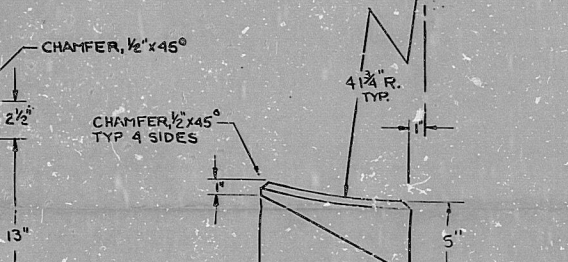
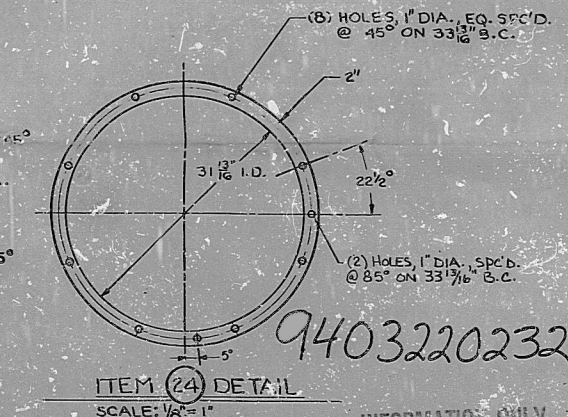
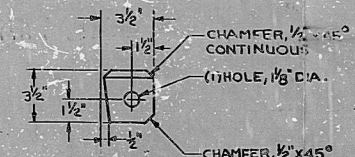
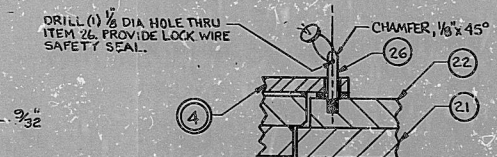
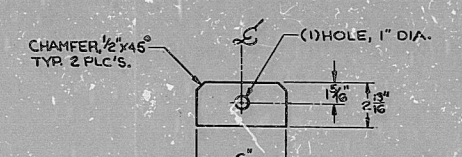
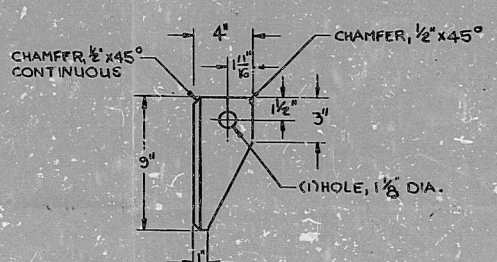
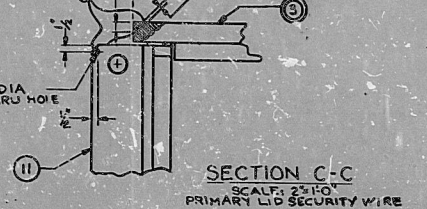
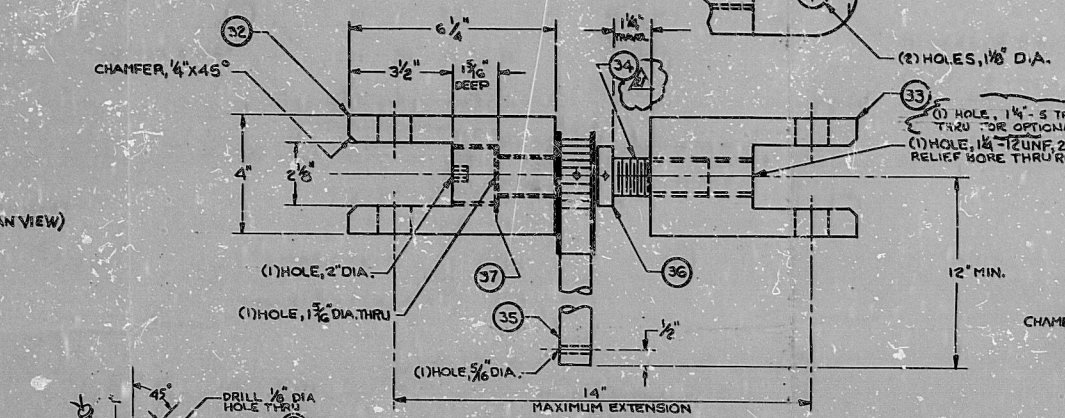
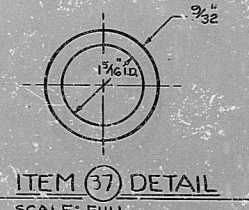
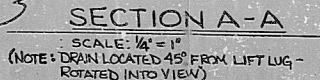
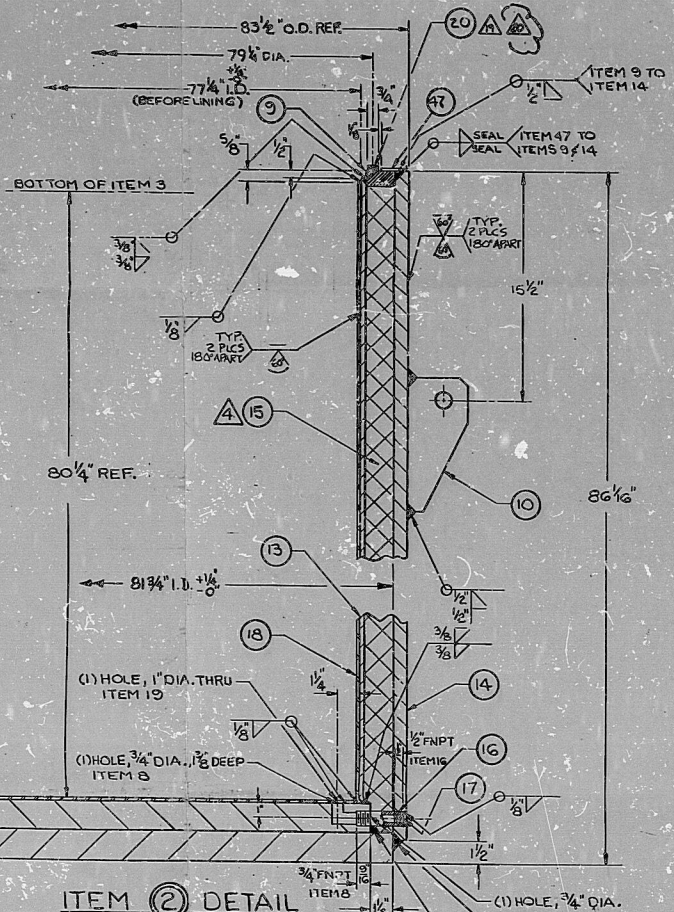
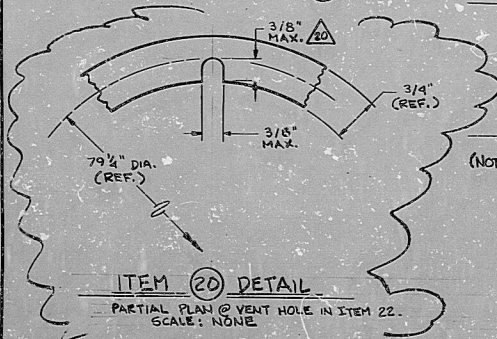
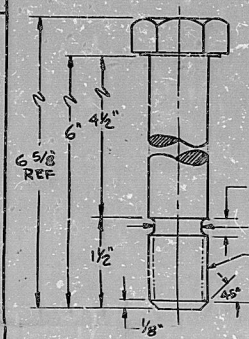
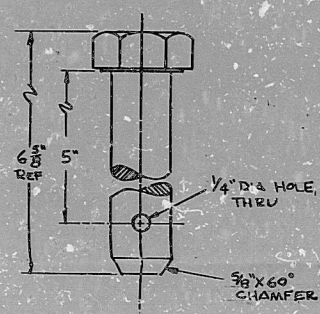
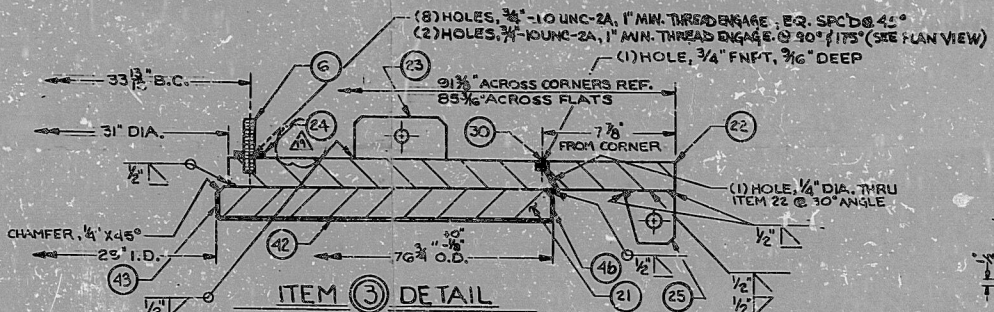


STD-02-077

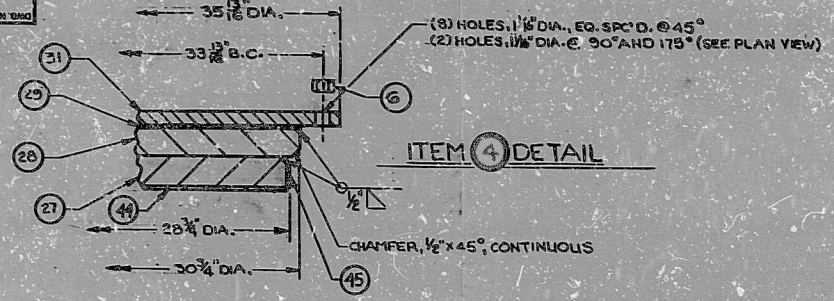

REV	DESCRIPTION	DATE
1	INITIAL RELEASE	10-1-87

DATE: 3-18-87	CHECKED BY: [Signature]	DATE: 2-6-87	RESP: [Signature]
PROJ: 14-215	DATE: 2-19-87	DATE: 2-19-87	DATE: 2-19-87
DRAWN BY: R.A. MUIRHEAD			
TOLERANCES UNLESS NOTED: FRACTIONS 1/16\"/>			

9403220232

14-215 CASK ASSEMBLY

STD-02-077

9

PDR RIDS

9403220232

