


M-12LF03 (Q)

M-12LF03 (Q)

This drawing and the design it covers is the property of the utility which was participating in the SNUPPS Project. It is loaned to the licensee's representative agent. It is not to be reproduced, copied, loaned, exhibited, or used except in the limited way and for the limited purpose intended by the licensee. It is to be returned to the licensee upon completion of the project.

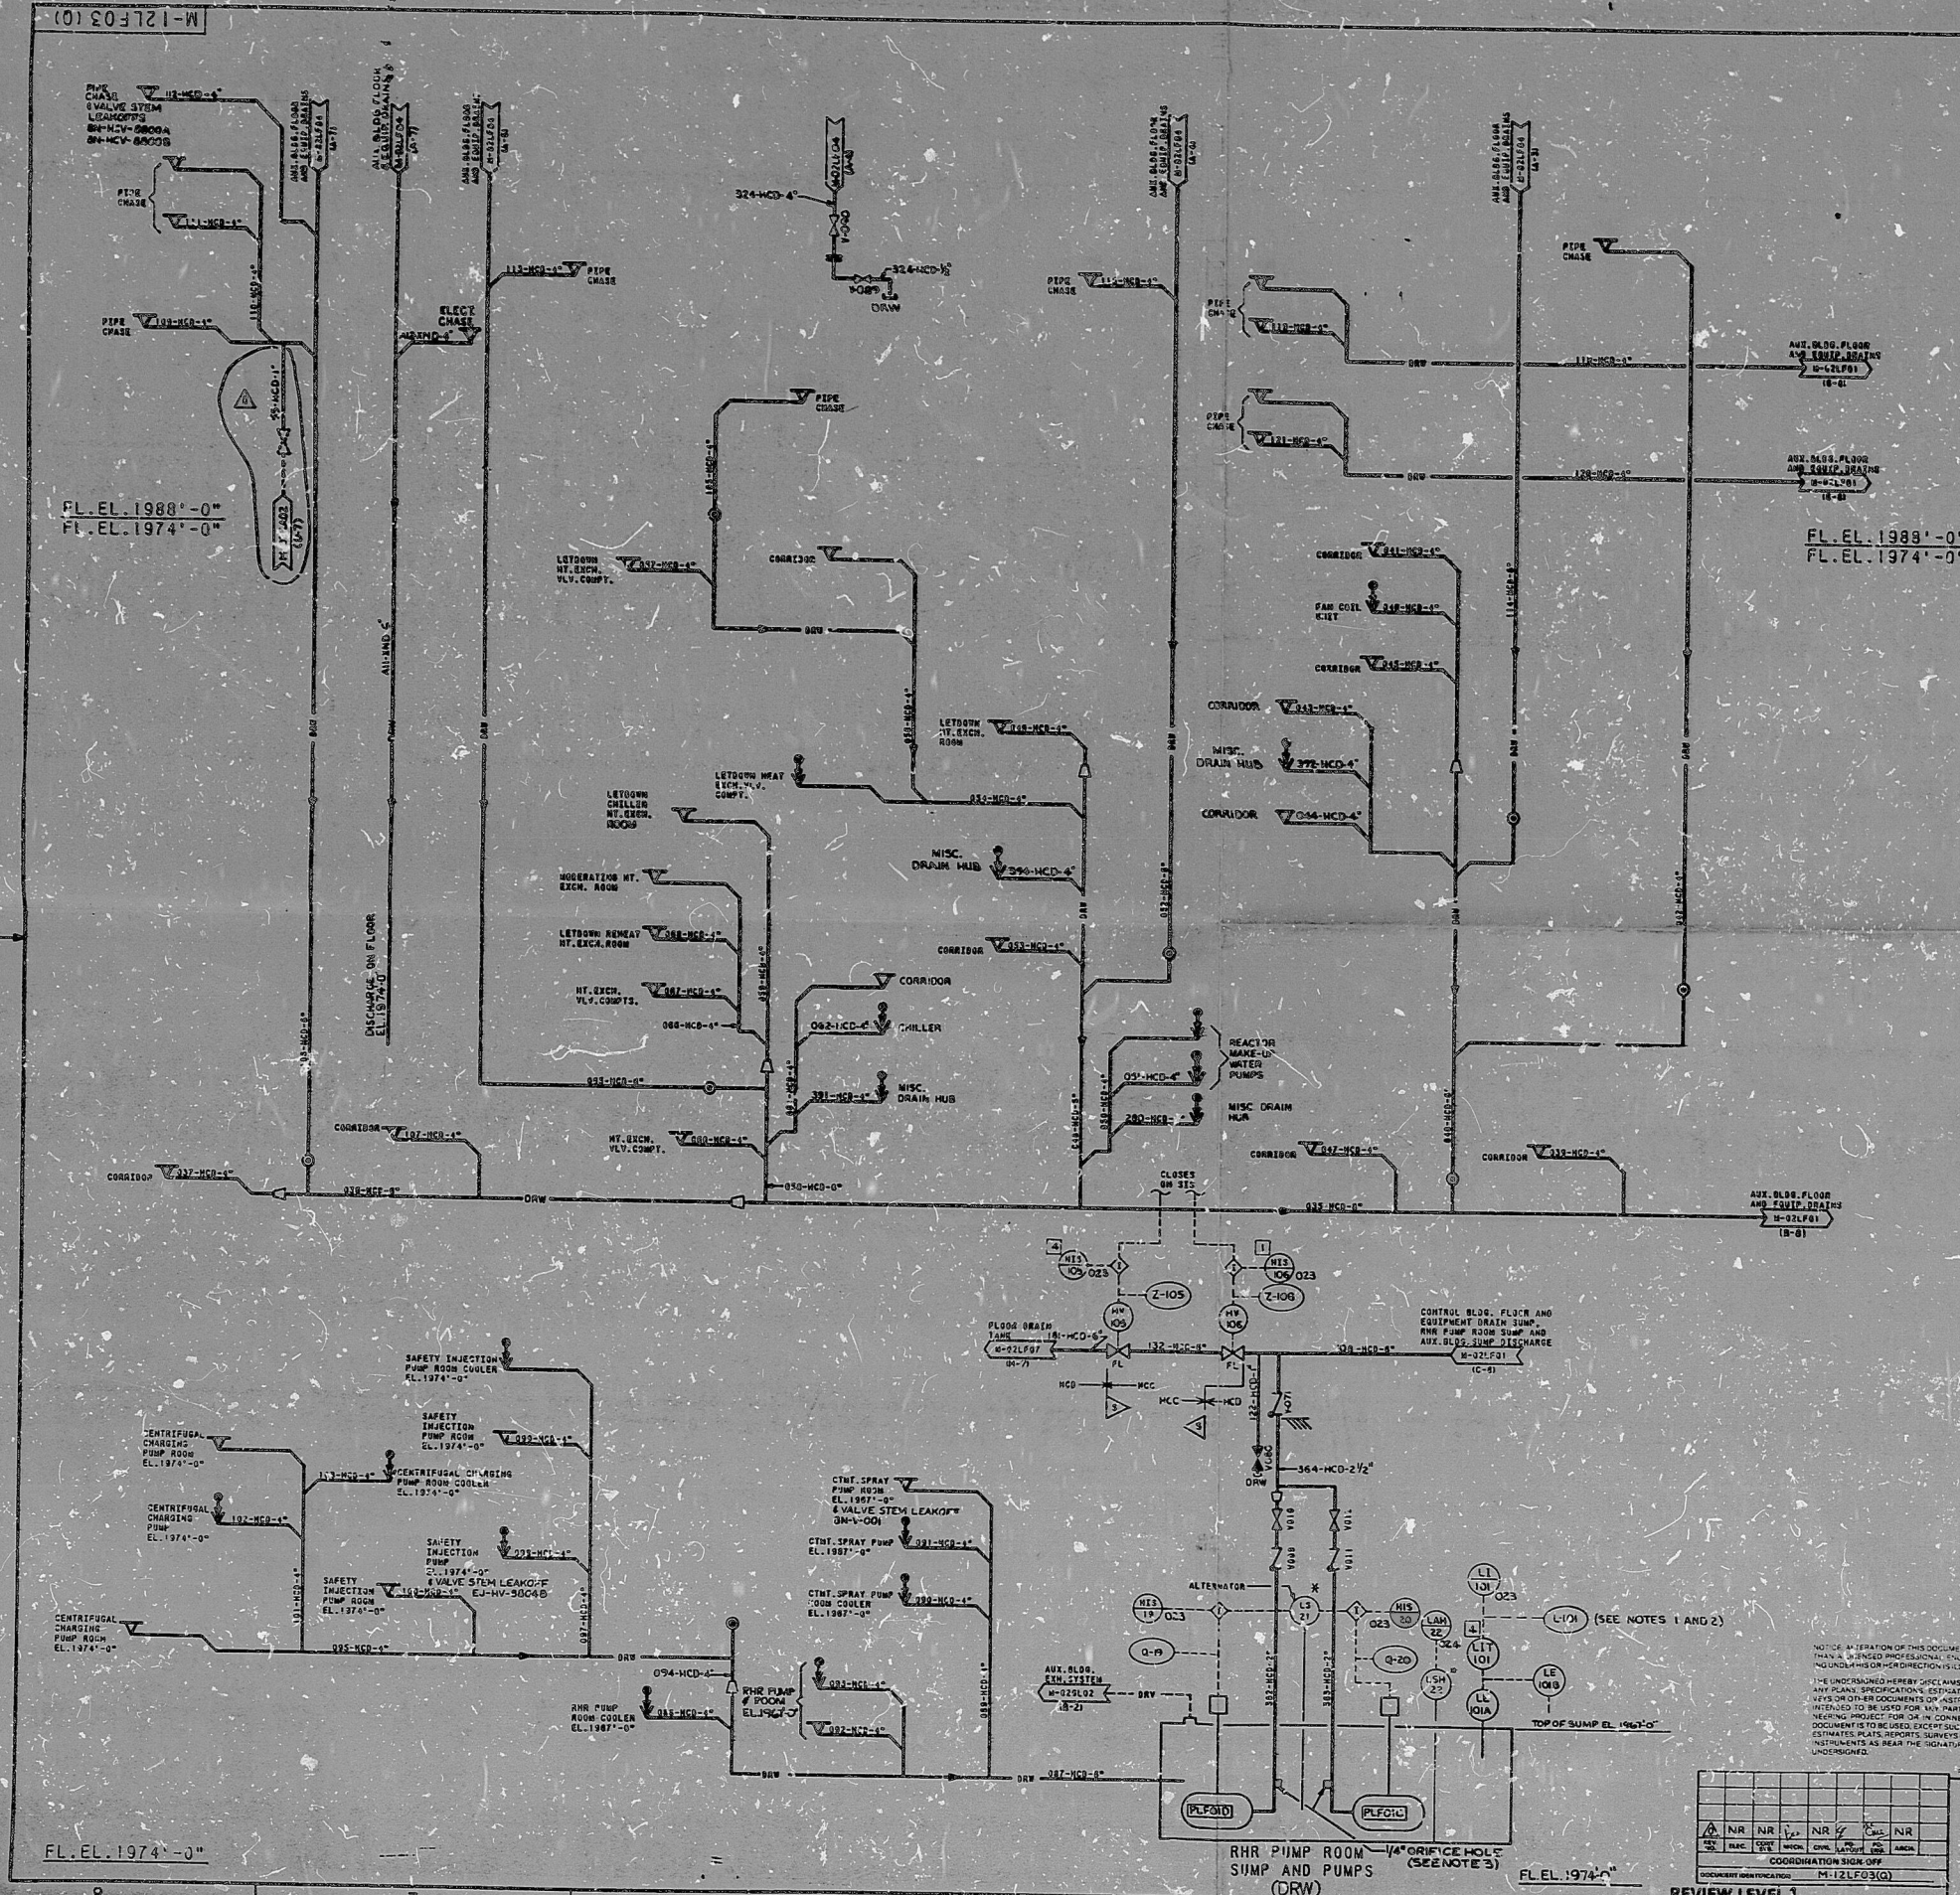



PDR RIDS

8507010213

