


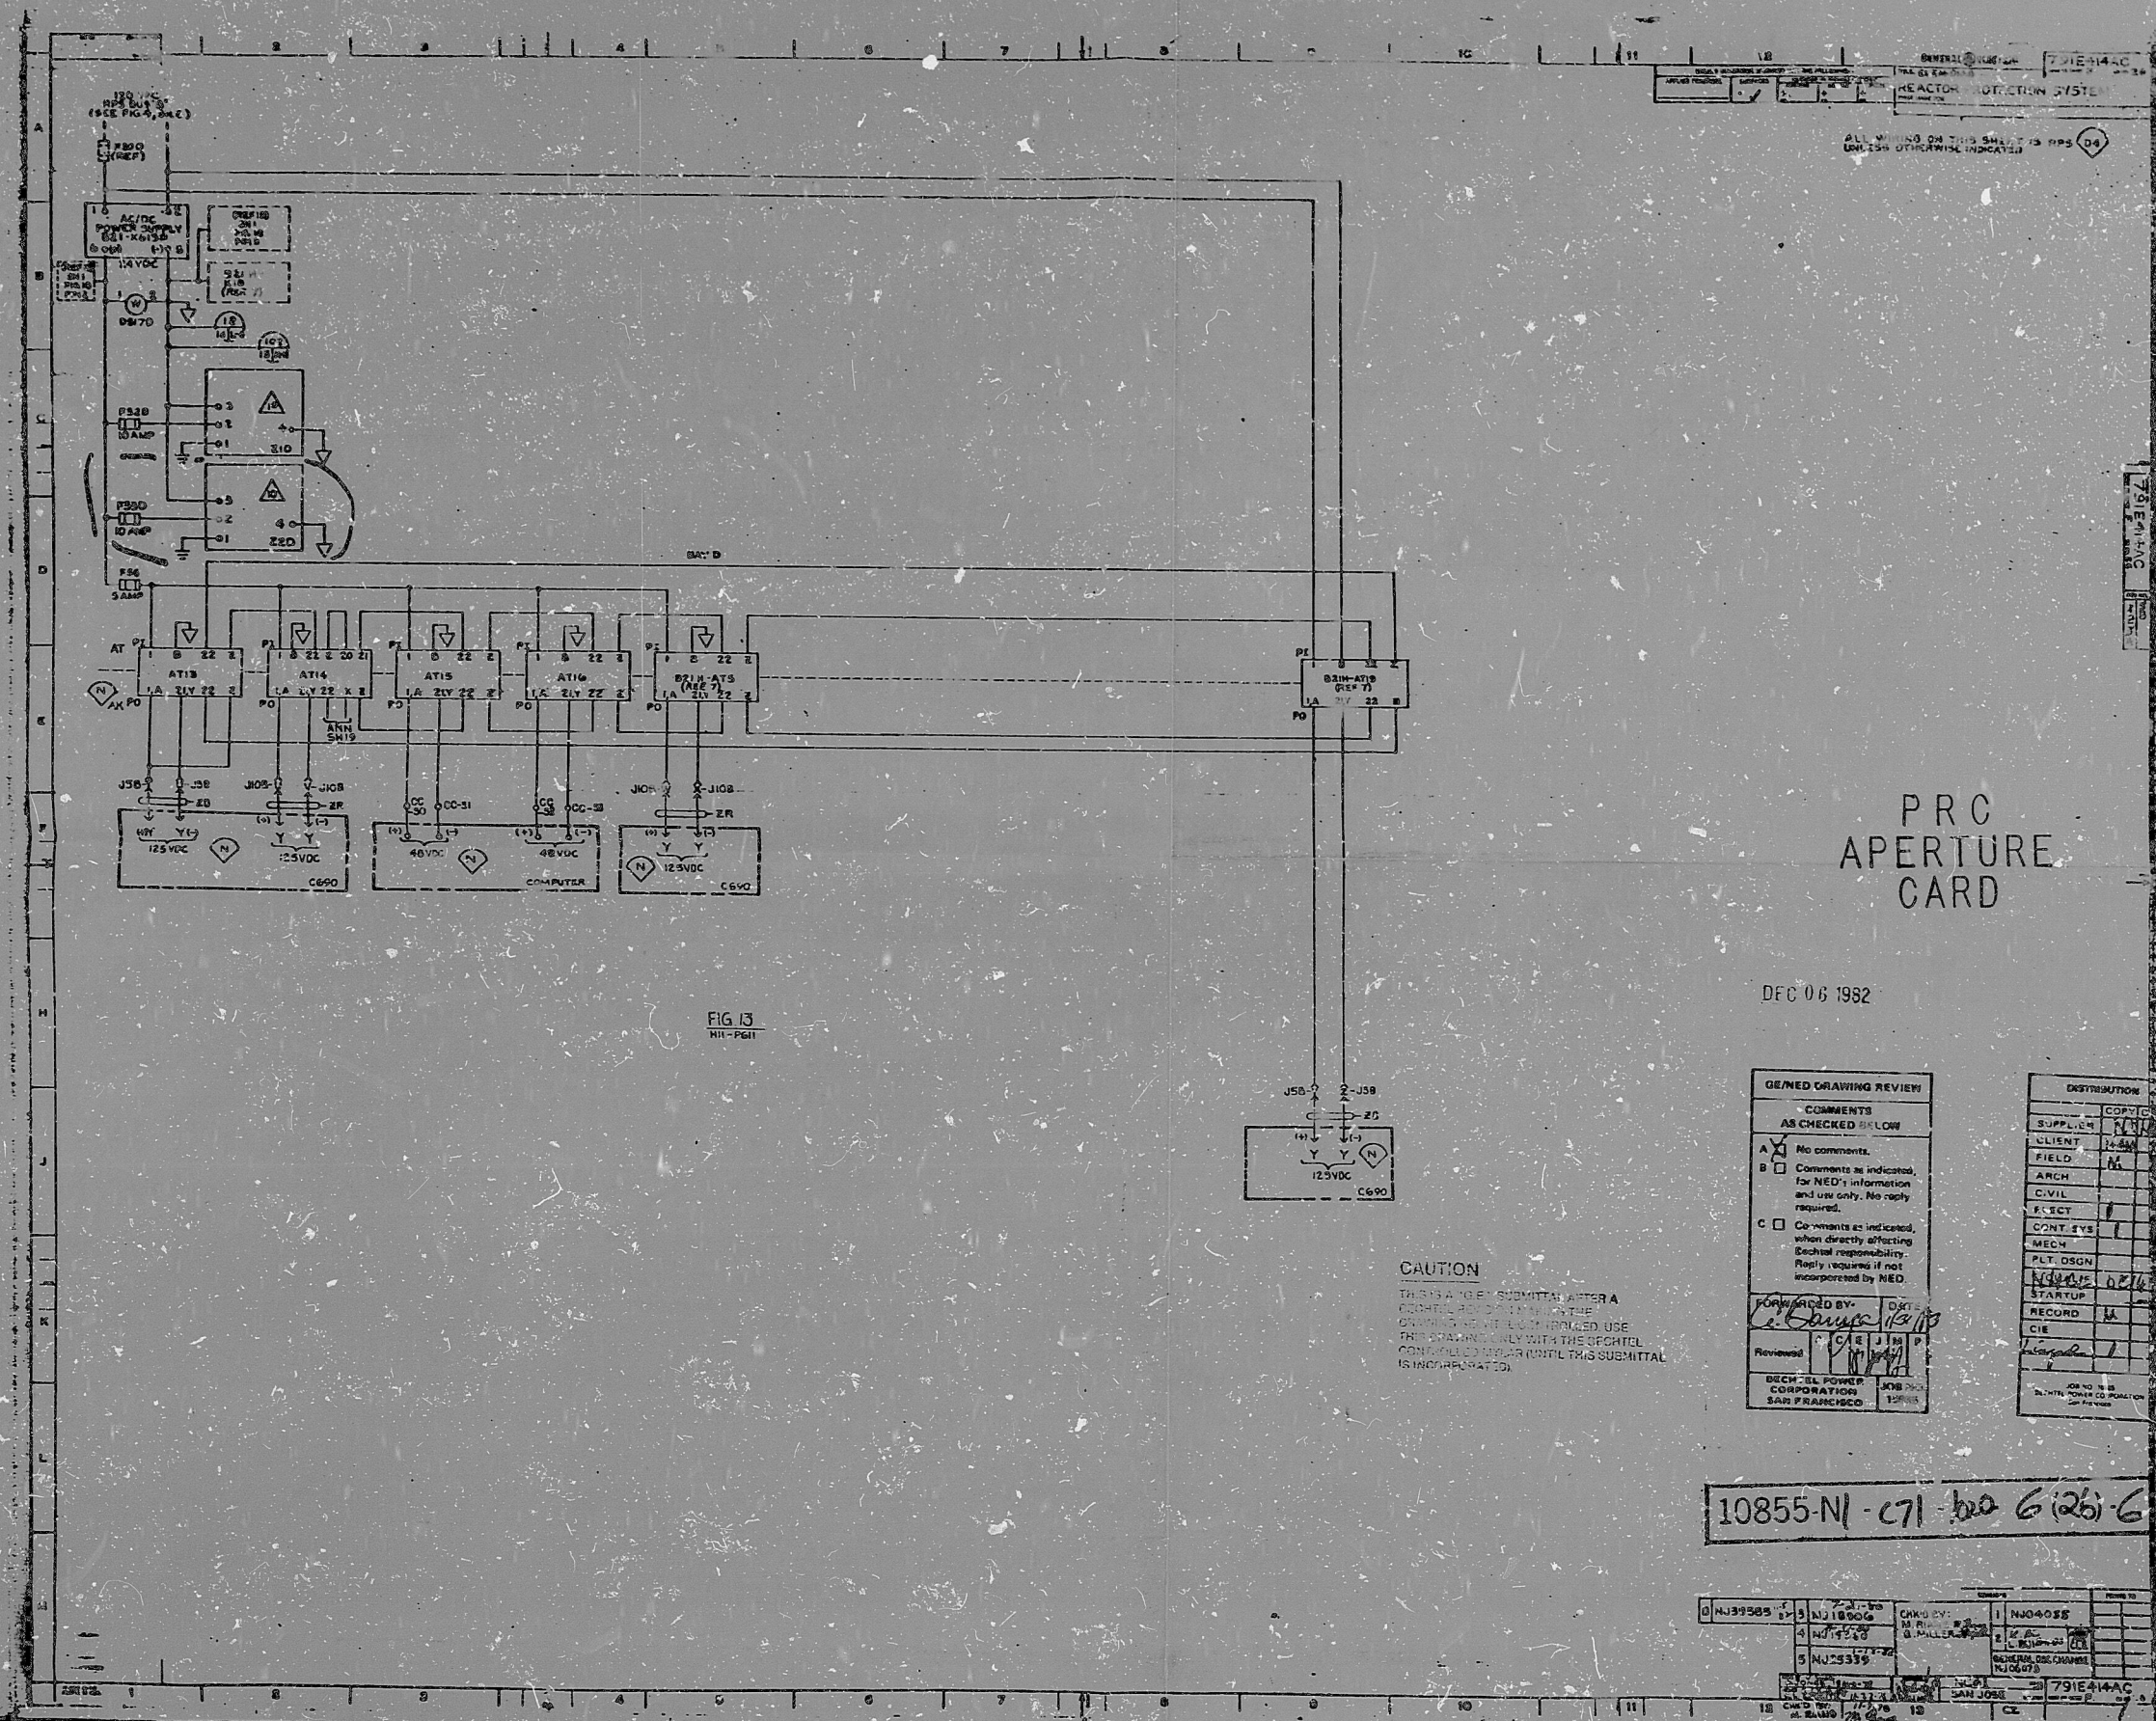

PRC
APERTURE
CARD

DFC 06 1982

CAUTION

THIS IS A "G" SUBMITTAL AFTER A
CHECKED REVISION MARK IN THE
DRAWING IS NOT CONTROLLED. USE
THIS DRAWING ONLY WITH THE CHECKED
CONTROLLED MYLAR (UNTIL THIS SUBMITTAL
IS INCORPORATED).

GE/MED DRAWING REVIEW	
COMMENTS AS CHECKED BY <u> </u>	
A ☒	No comments.
B ☐	Comments as indicated for NEE's information and use only. No reply required.
C ☐	Comments as indicated, when directly affecting Residual responsibility. Reply required if not incorporated by NED.
FORWARDED BY: <u>E. G. Gans</u>	DATE <u>1/14</u>
Reviewed: <u> </u>	<u> </u>
DECM-TEL POWER CORPORATION SAN FRANCISCO	
JOB NO. <u> </u> 12/19/64	

DISTRIBUTION	
SUPPLIER	COPY
CLIENT	1-4
FIELD	1
ARCH	1
CIVIL	1
ELECT	1
CONT. SYS	1
MECH	1
PLT. DSGN	1
STARTUP	1
RECORD	1
CIE	1

FOR NO. 188
 DELTA-TOWER CONSTRUCTION
 SAN FRANCISCO

10855-NI - (7) - HQ 6(26) - C

[] NJ39385		2-11-68 3 NJ18006		CASH DIV. G. MILLER		1 NJ40455	
		5 NJ19549				1 NJ18104	
		5 NJ23339				GENERAL COS. CHAMBER NJ06078	
18		CASH DIV. at SAUO		18		791E4MAC SAN JOSE CE	

RIDS

8309090064

