


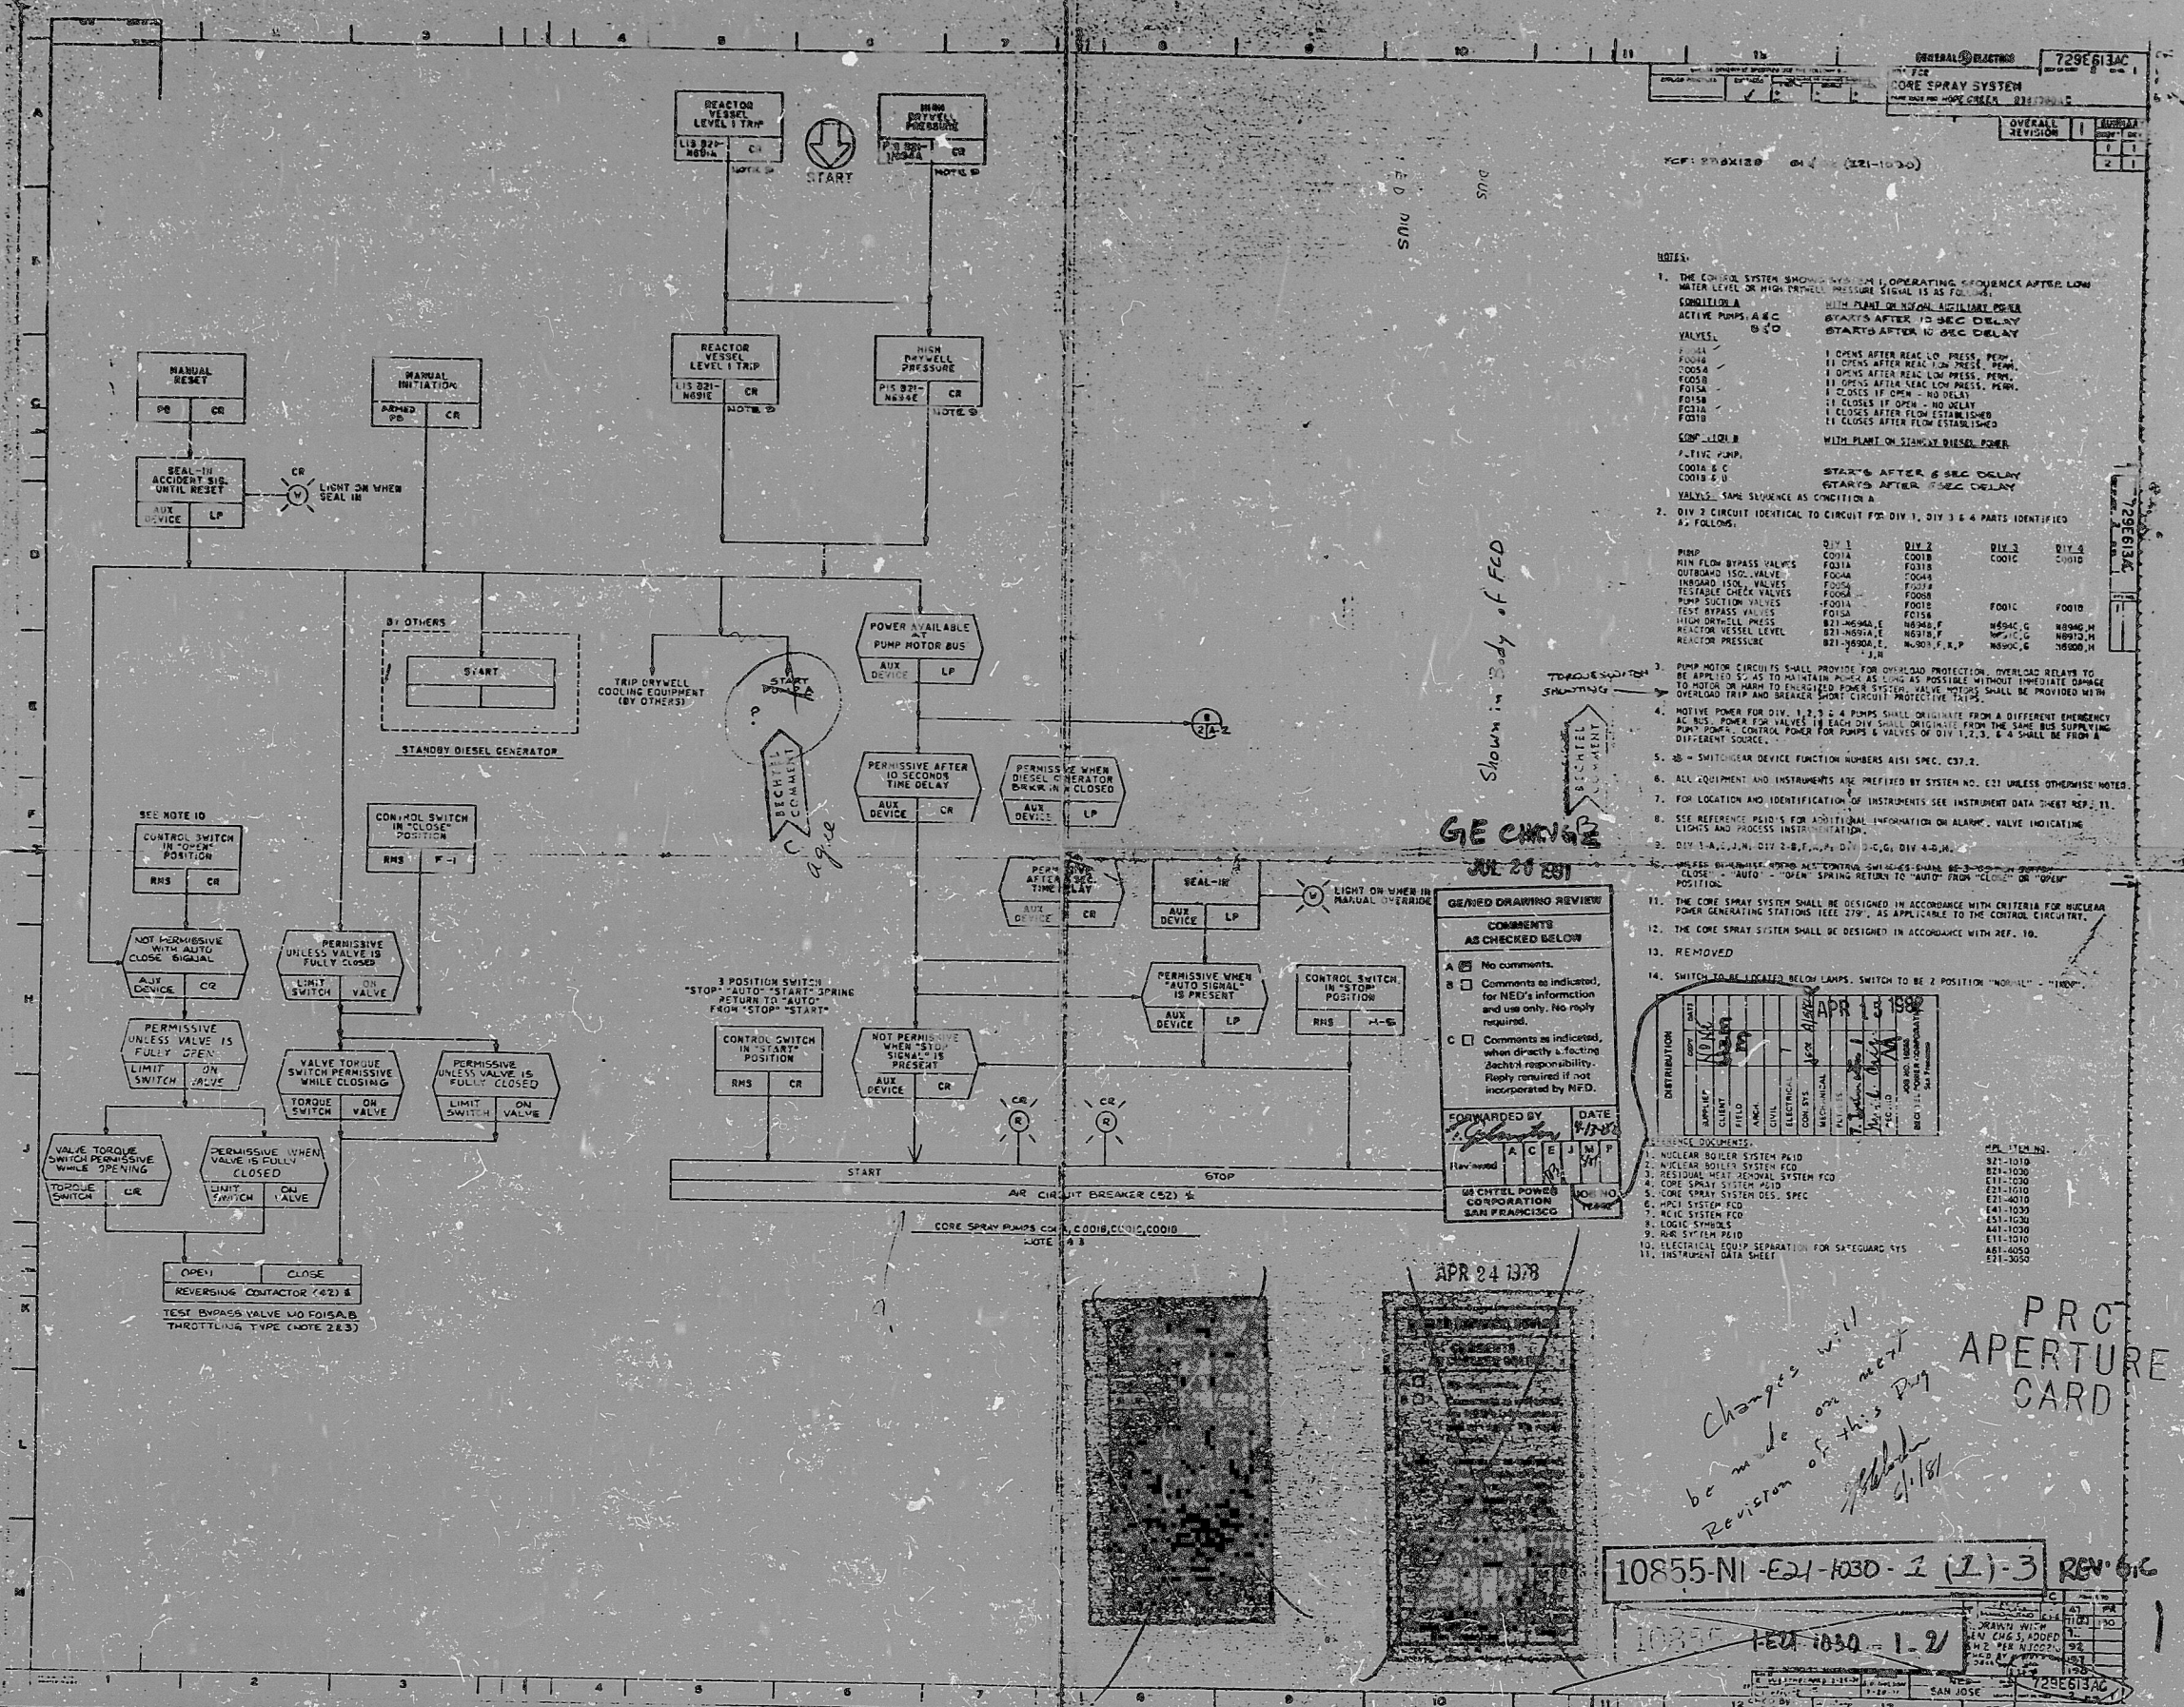

Changes will
be made on next
Revision of this Proj
J. J. [Signature]
9/18/81

PROC
APERTURE
CARD

10855-NI-E21-1030-2 (1)-3 REV. 61C

[illegible]

RIDS

8309090066

