


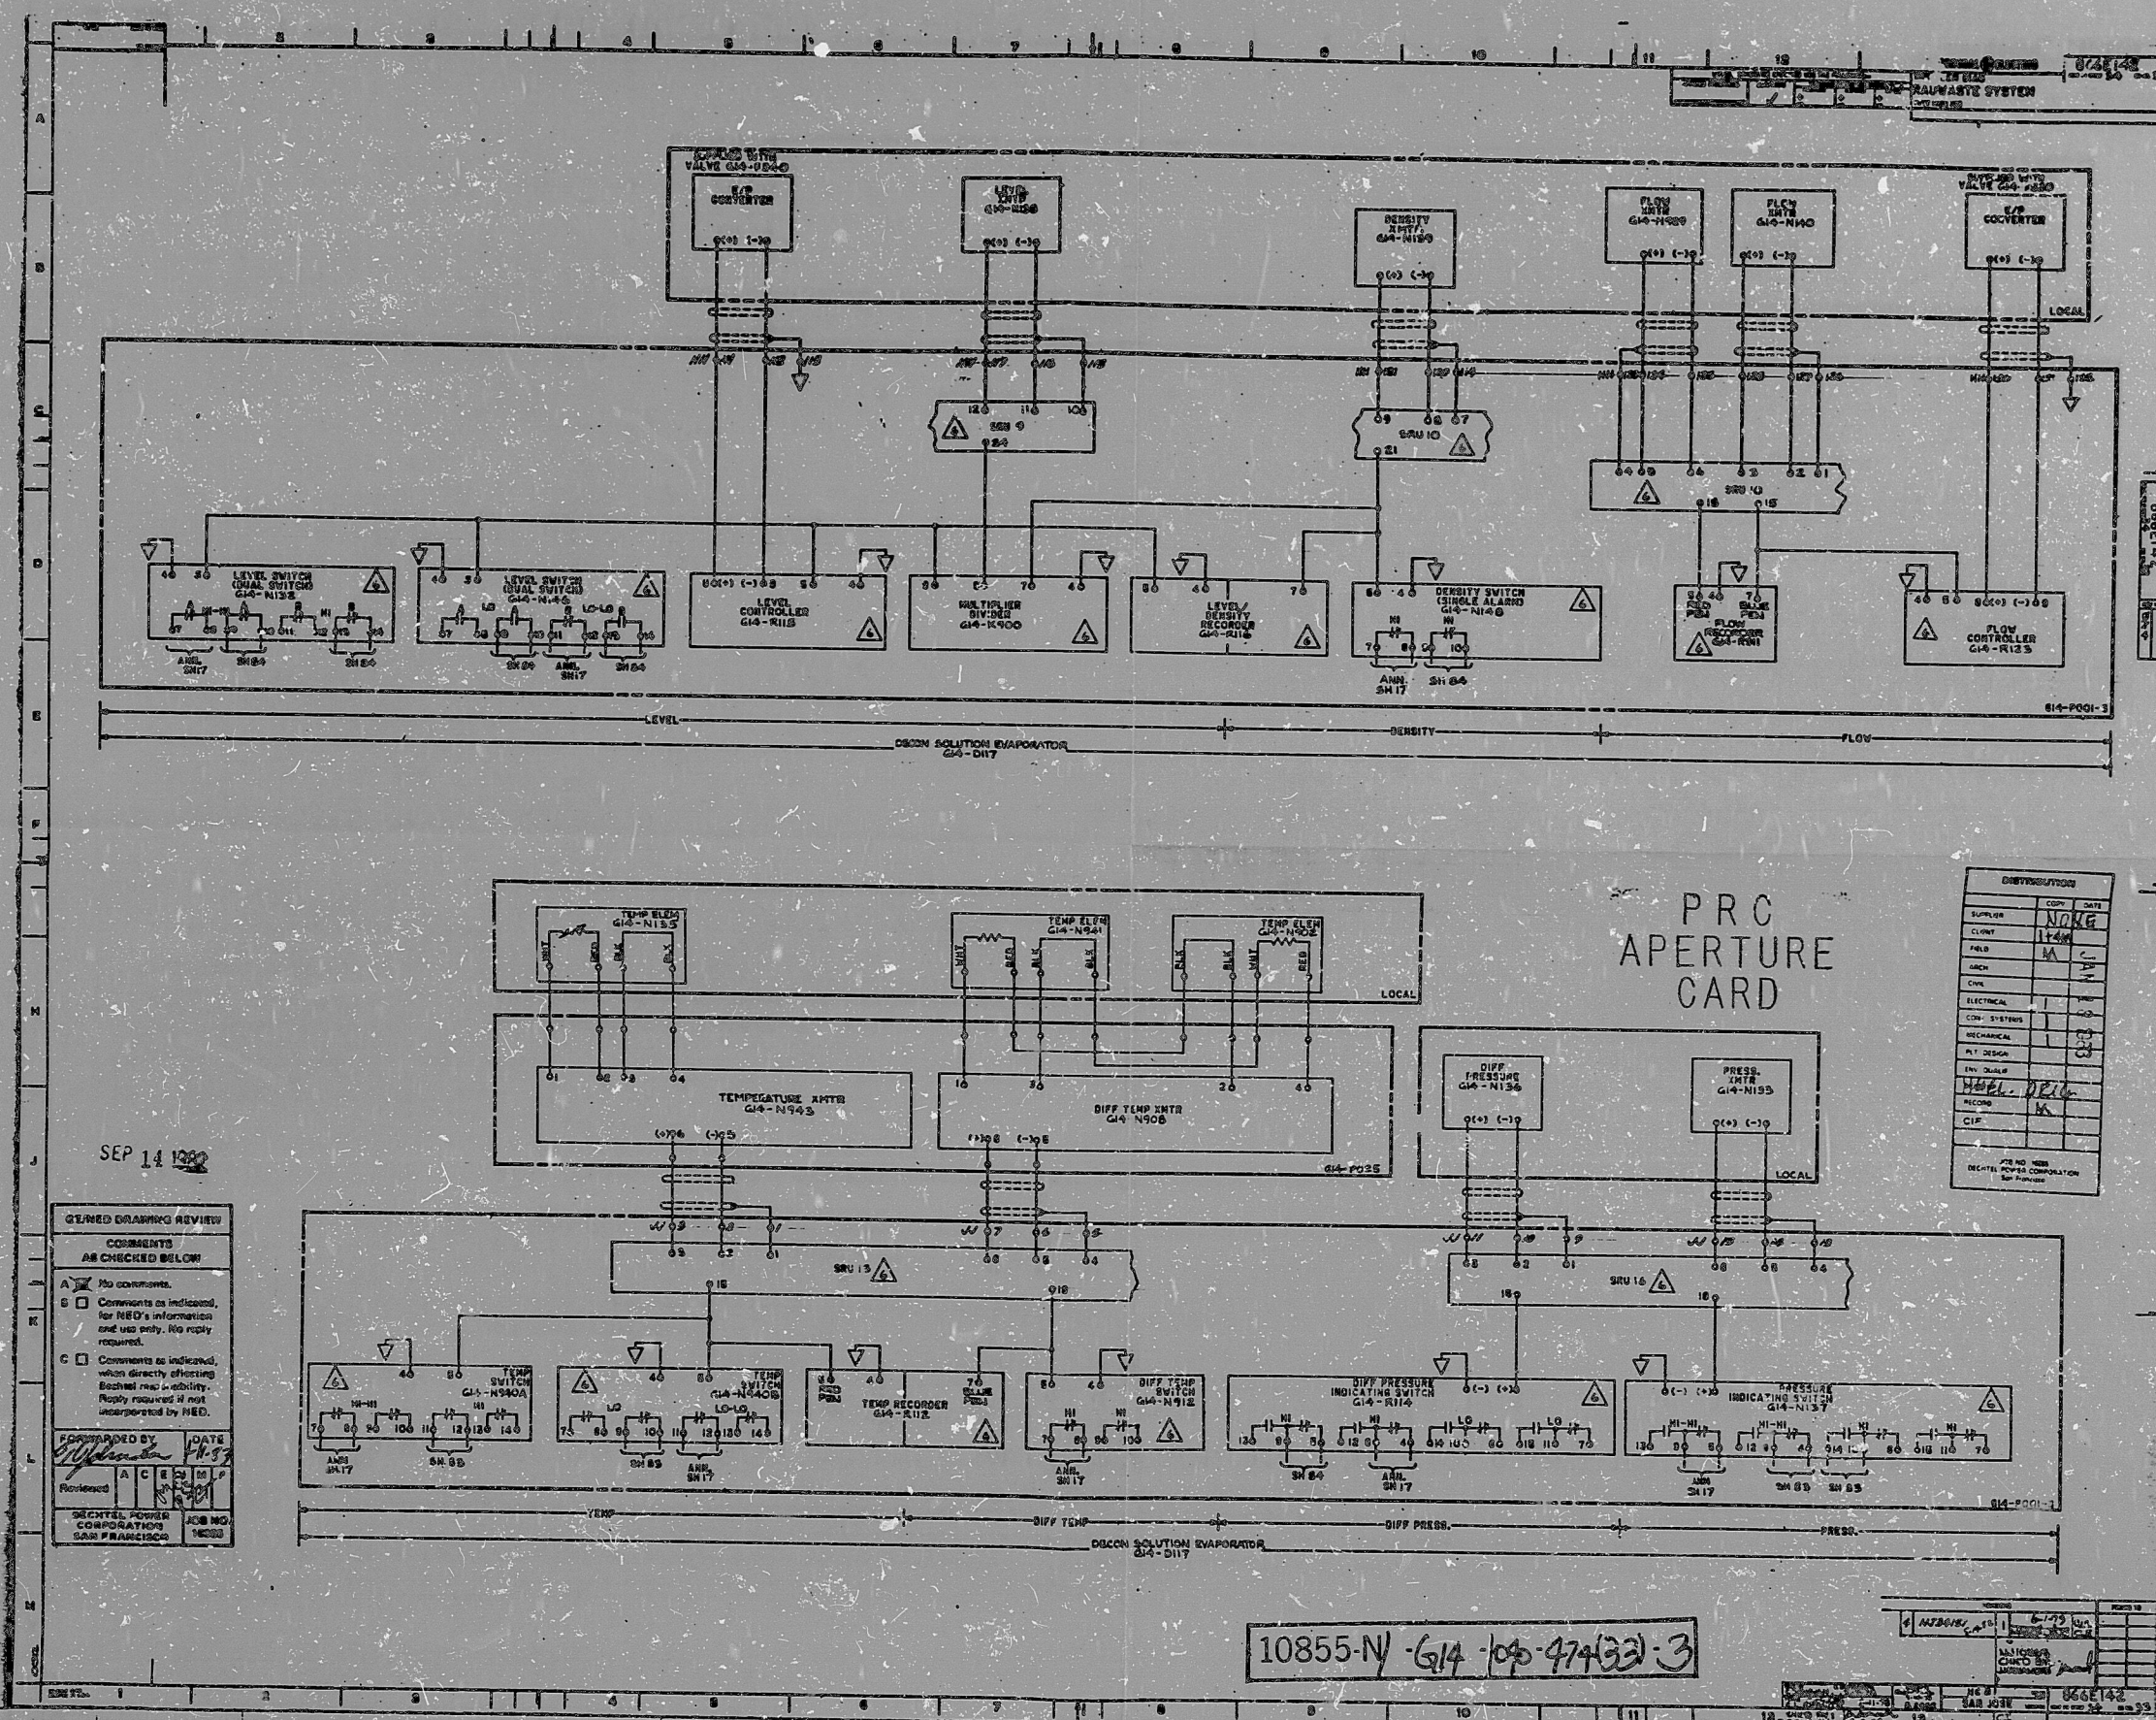

SEP 14 1966

GEN'D DRAWING REVIEW
COMMENTS
AS CHECKED BELOW
A. ☒ No comments.
B. ☐ Comments as indicated, for NED's information and no reply required.
C. ☐ Comments as indicated, when directly affecting Bachel map activity. Reply required if not incorporated by NED.
FORWARDED BY: *[Signature]* DATE: *[Date]*
REVIEWED BY: *[Signature]* DATE: *[Date]*
BACHEL POWER CORPORATION SAN FRANCISCO

PRC
APERTURE
CARD

DISTRIBUTION		
SUPPLIER	COMP.	DATE
CLINT	NONE	
FIELD	1/4/66	
ARCH	1/4/66	
CHN		
ELECTRICAL		
CON. SYSTEMS		
MECHANICAL		
PLT. DESIGN		
ENV. DESIGN		
RECORD		
CIP		
RECEIVED HERE RECEIVED POWER CORPORATION San Francisco		

10855-N G14 09-97433-3

10855-N	G14	09-97433-3
DATE	SEP 14 1966	
BY	<i>[Signature]</i>	
CHECKED BY	<i>[Signature]</i>	
APPROVED BY	<i>[Signature]</i>	

KIDS

8309090150

