




PDR RIDS

9406220128

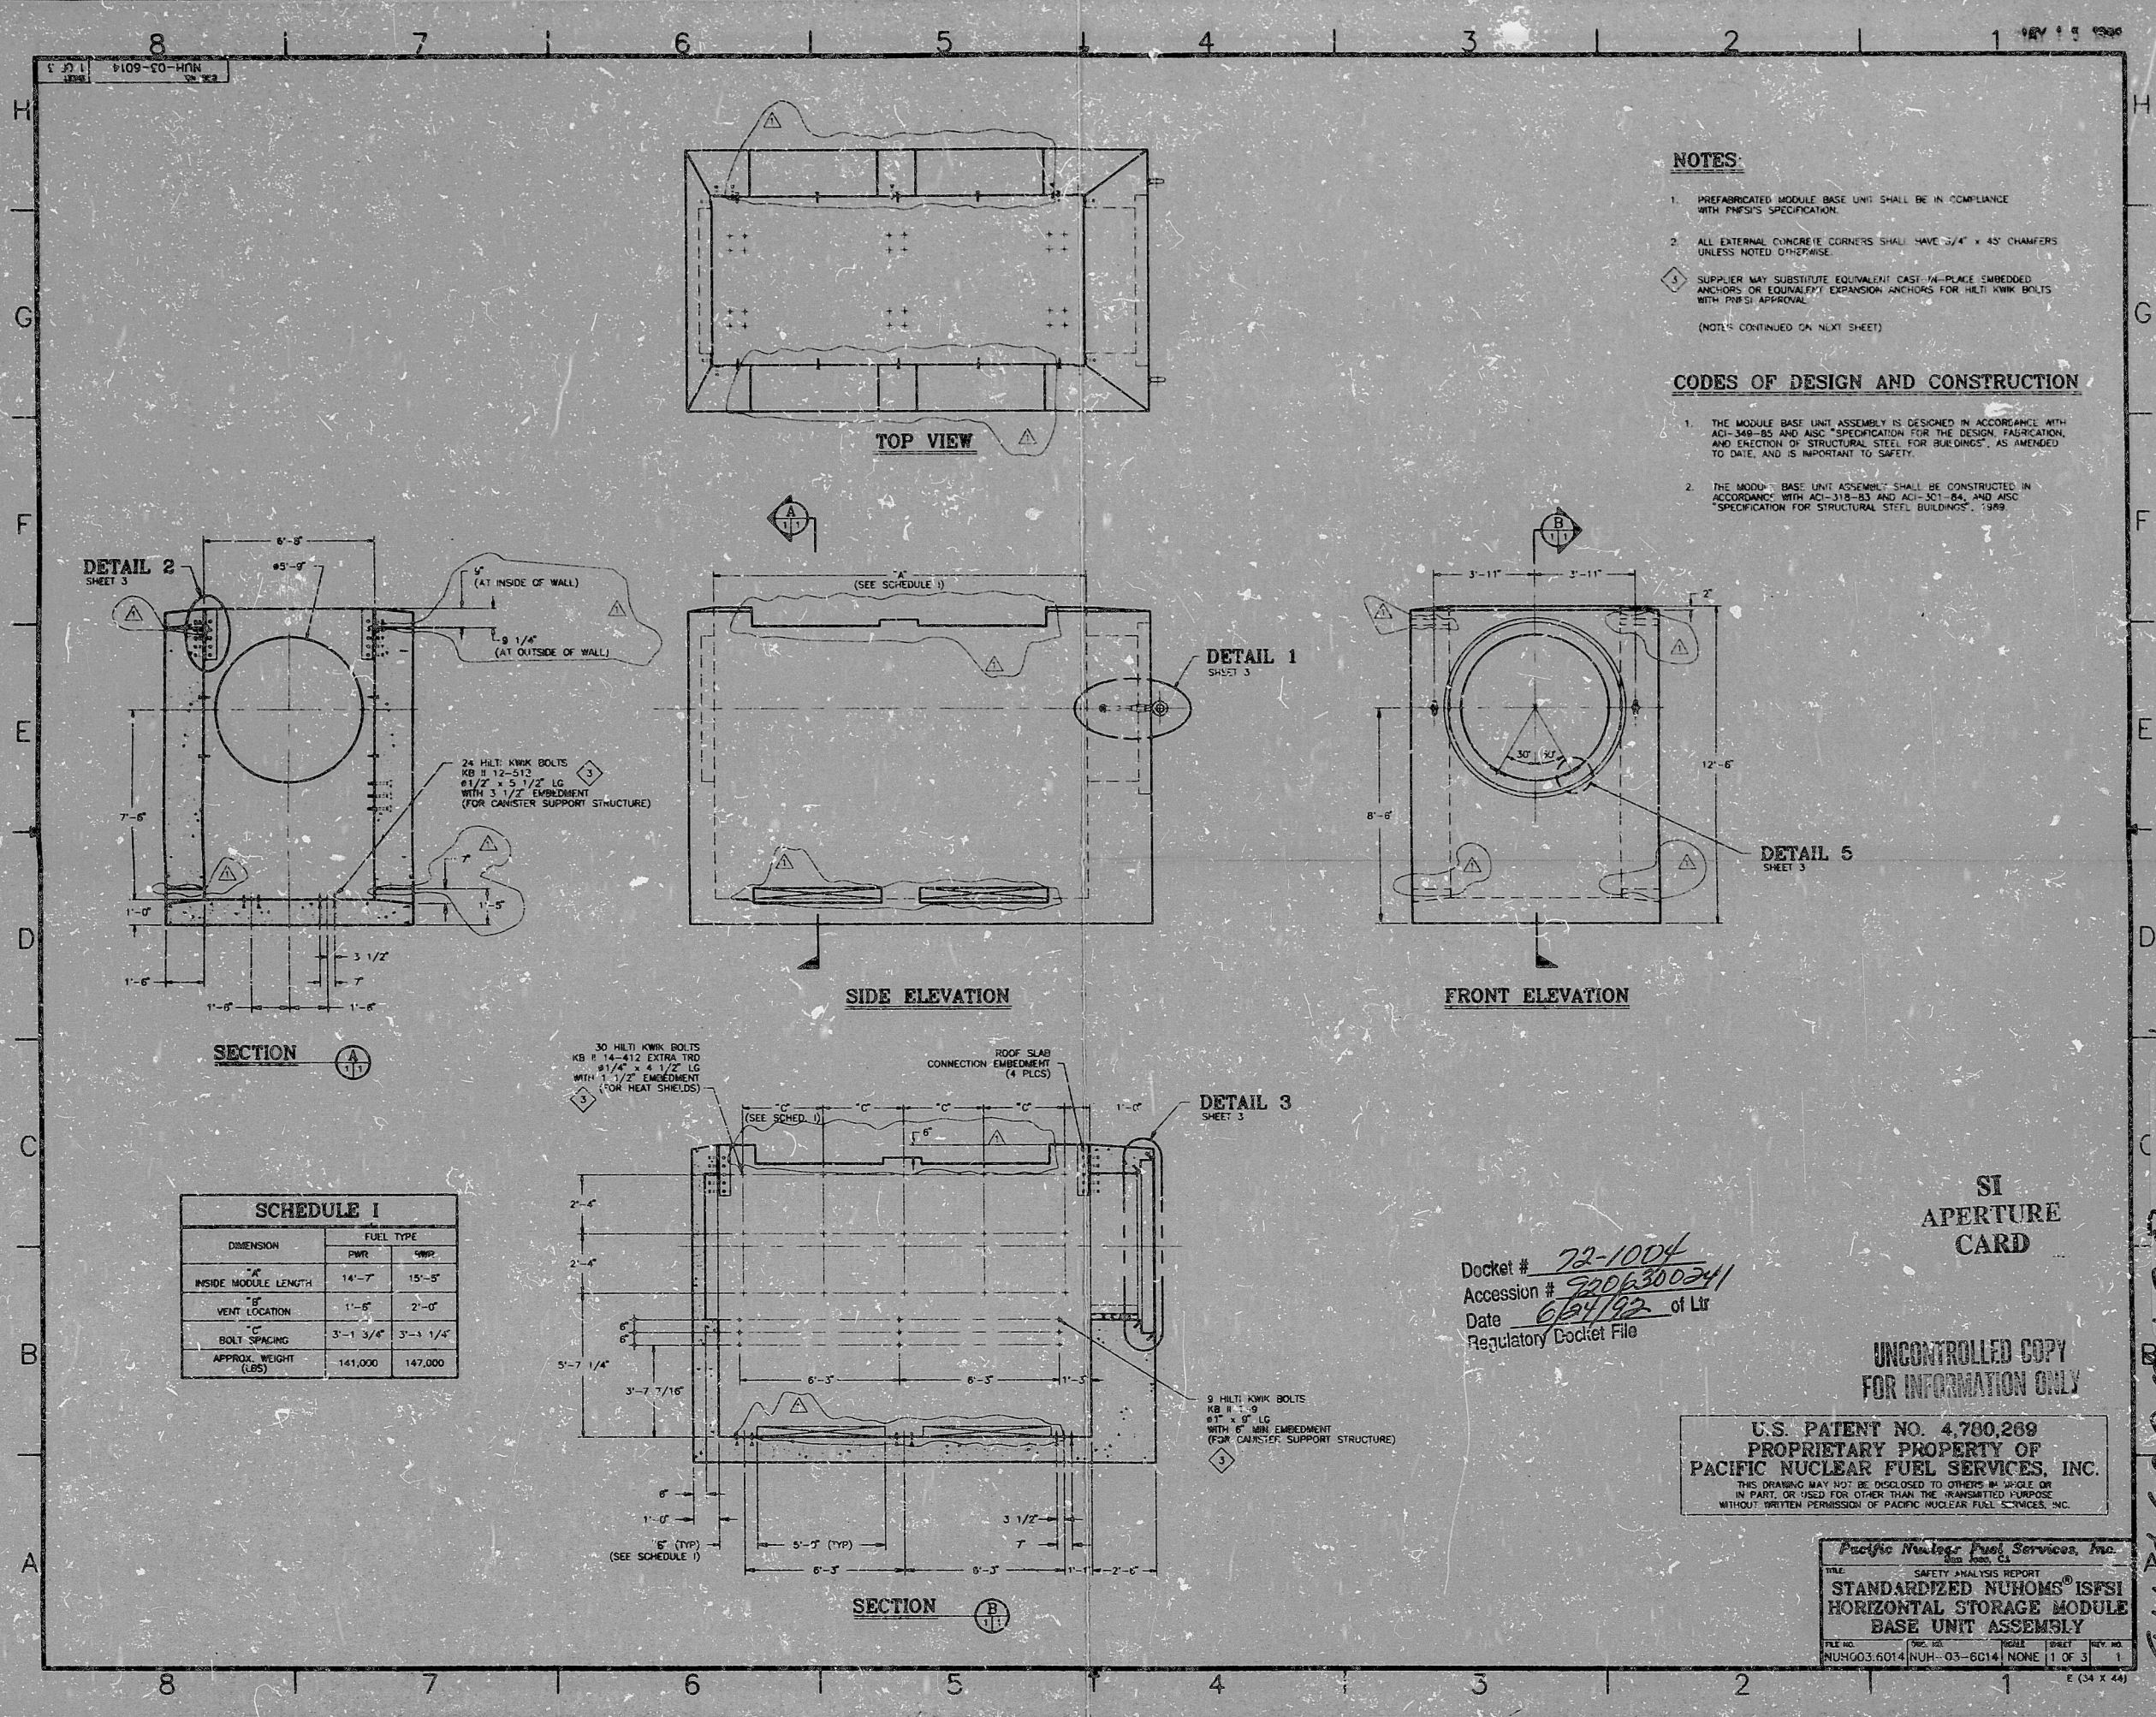