


237127A-E-240

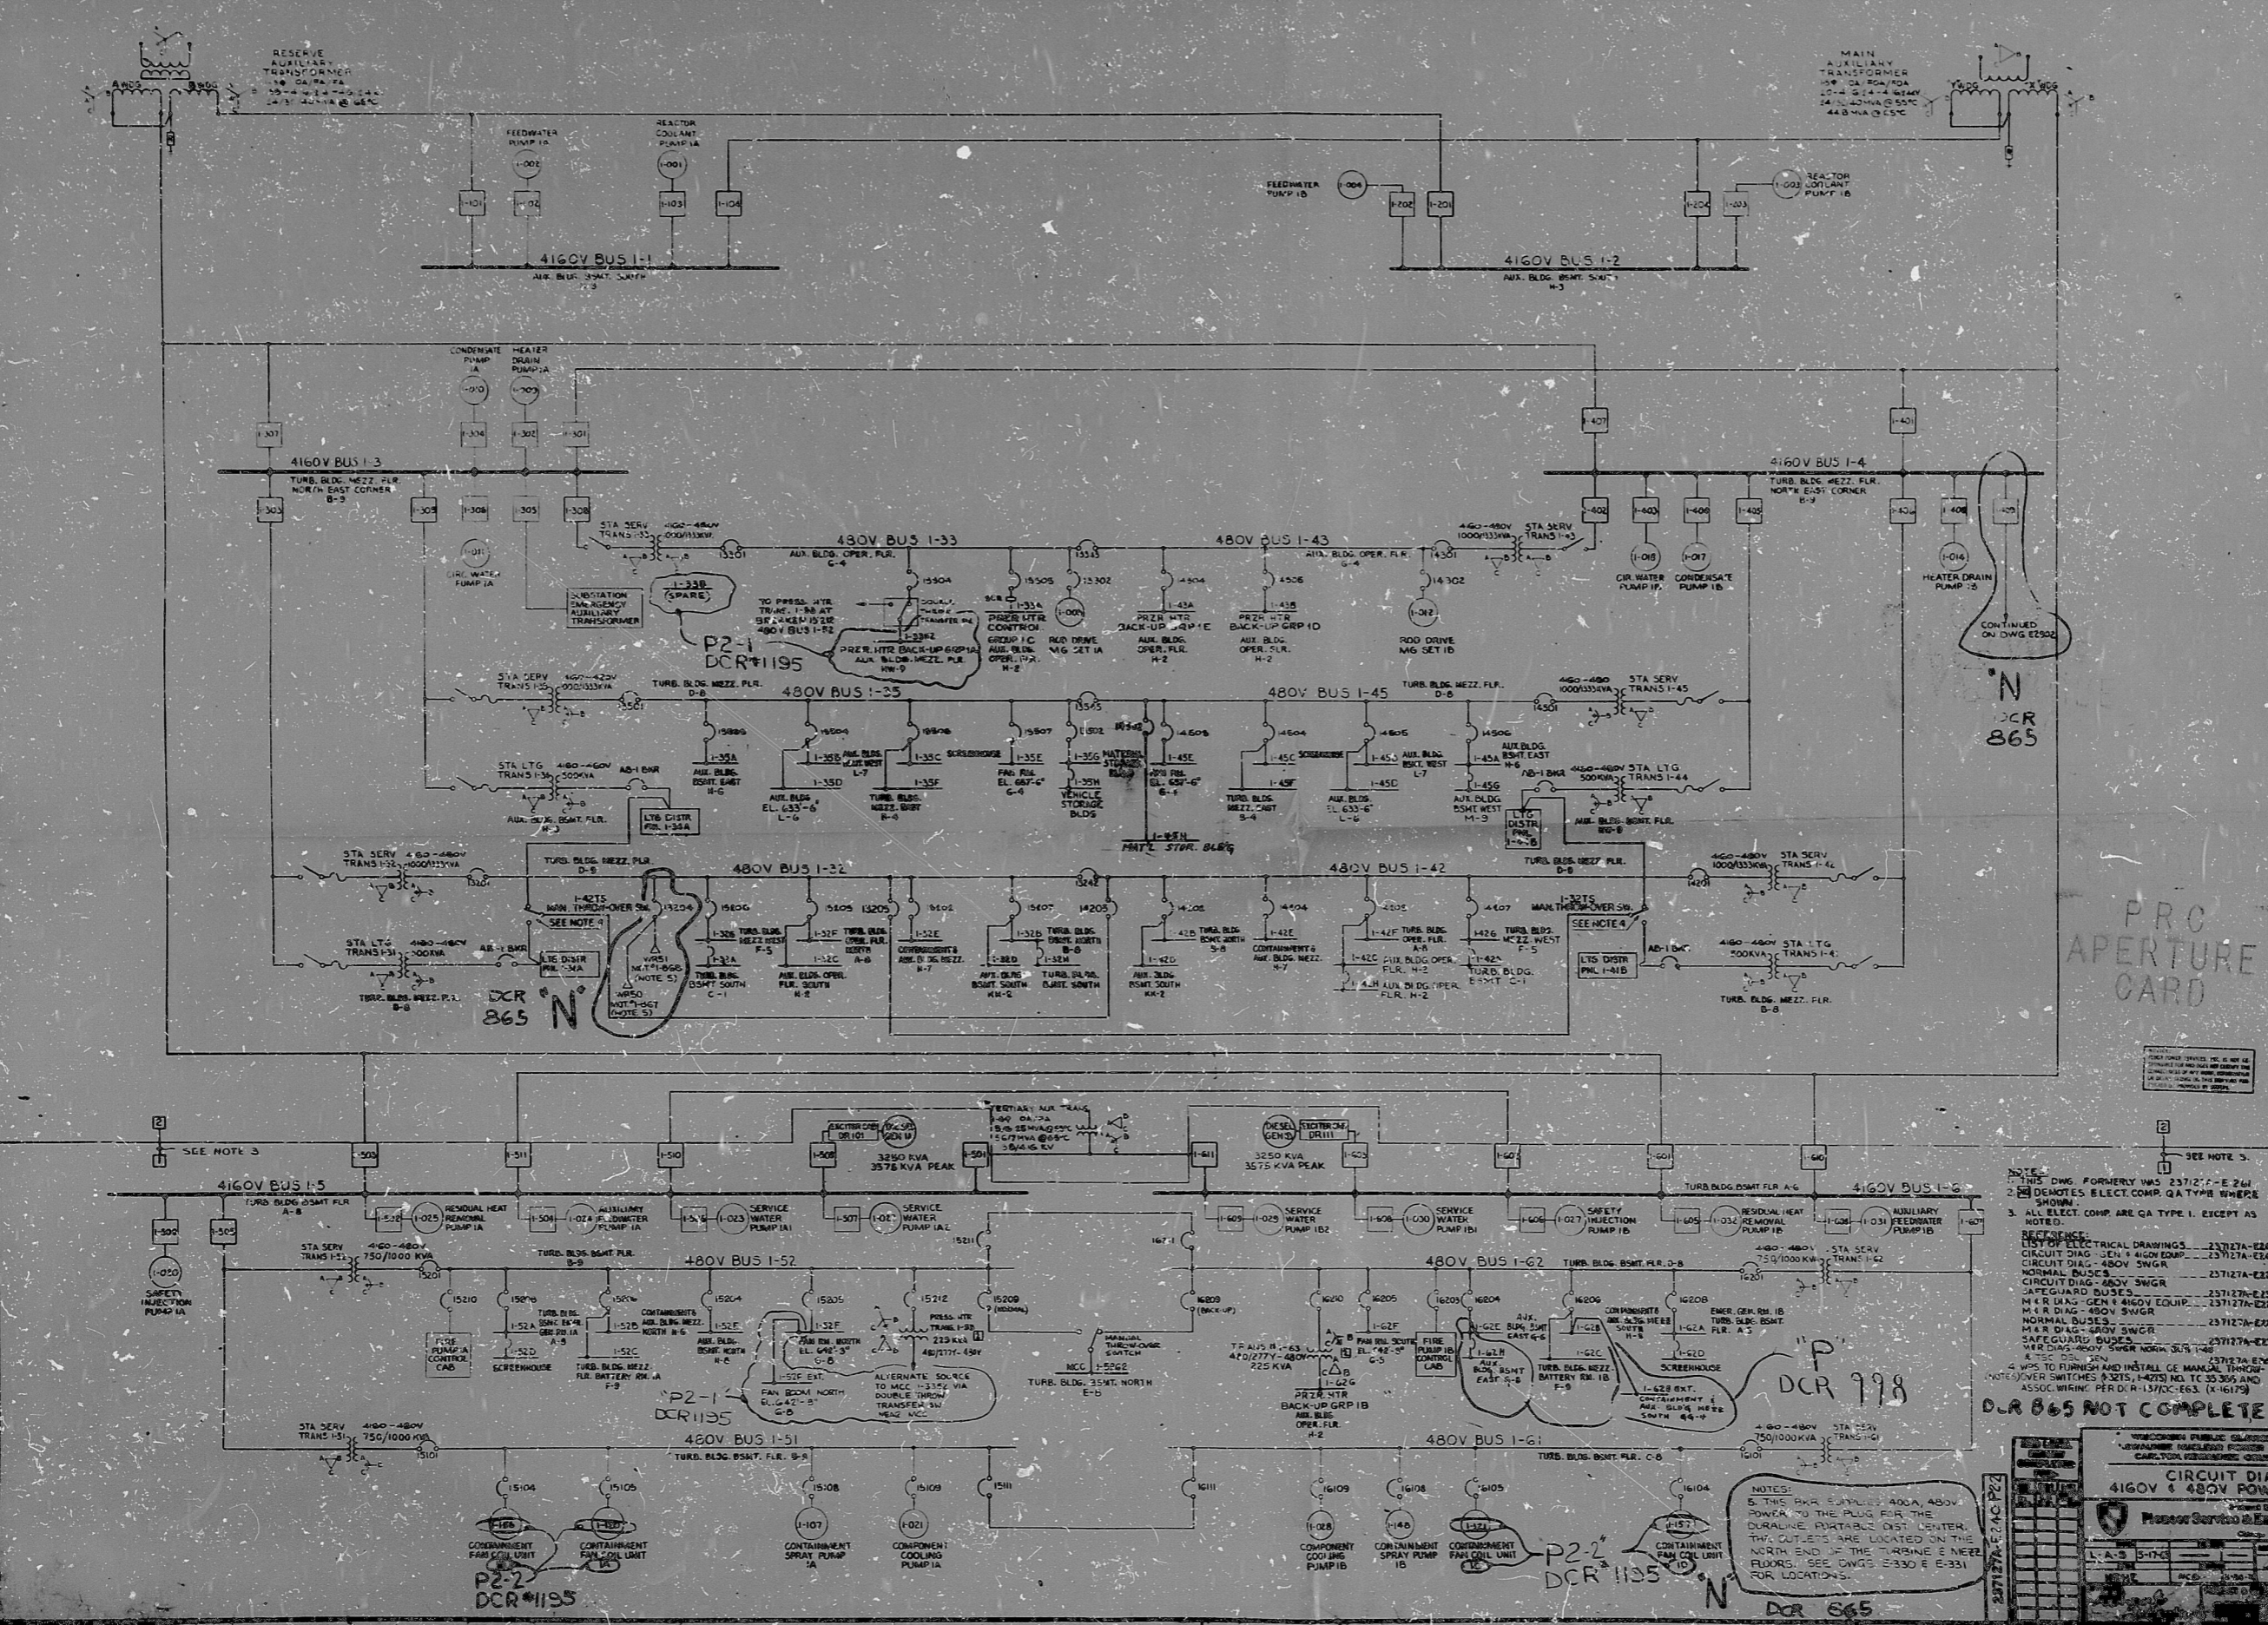


NOTES:

- ALL ELECT. COMP. ARE GA. TYPE 1, EXCEPT AS NOTED



N
DCR 865

PRO APERTURE CARD





237127A-E-240

CIRCUIT DIAGRAM
410V & 480V POWER SOURCES







8309120498

RIDS

8309120498

