
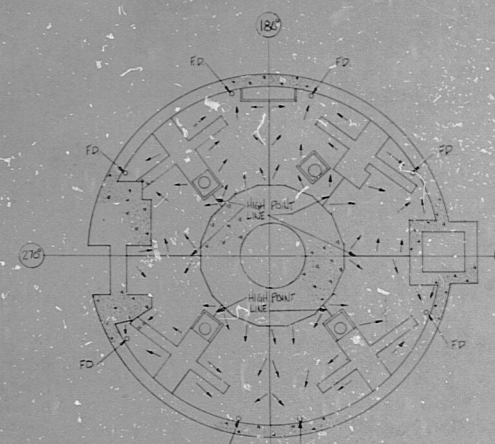
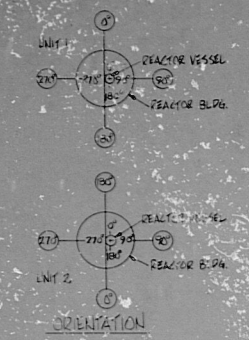
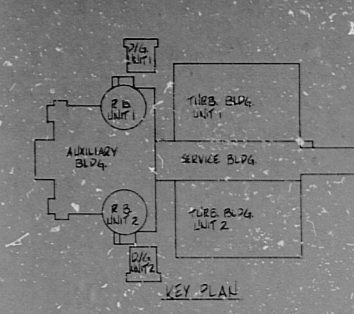



1 2 3 4 5 6 7 8 9 10 11 12 13 14

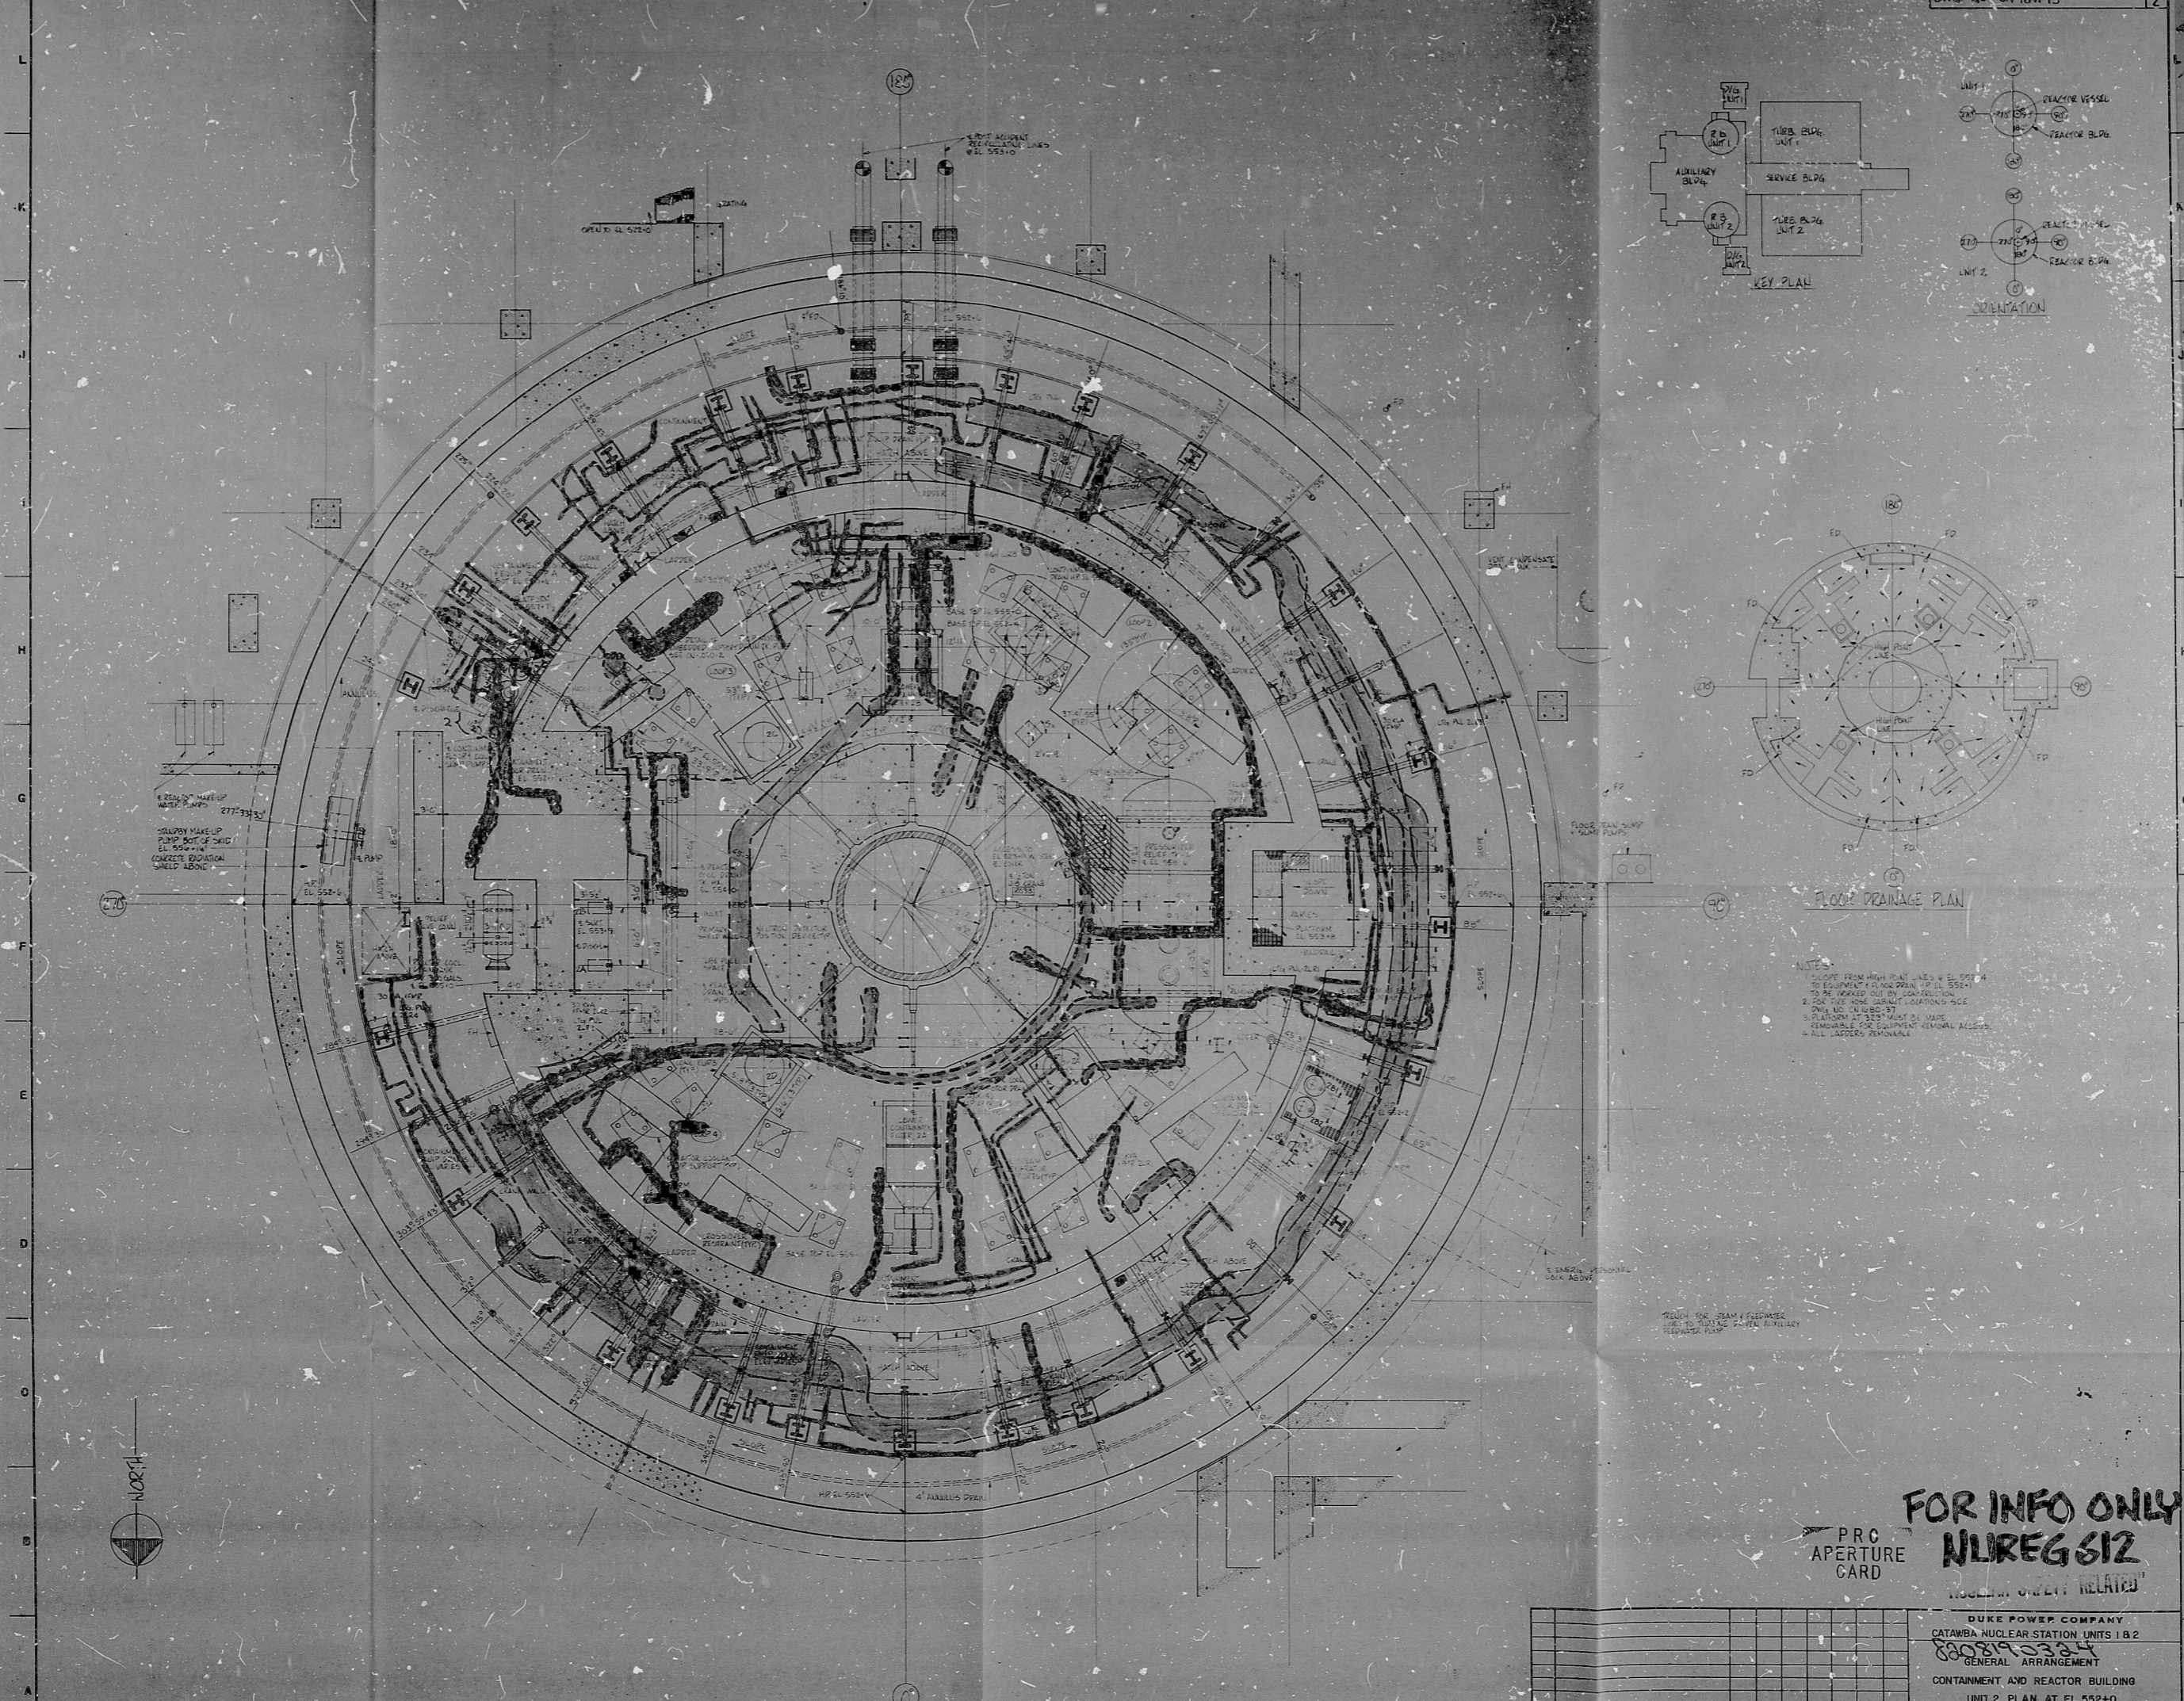

FLOOR DRAINAGE PLAN

NOTE:  
 3. PLATFORM AT 325' MUST BE MADE REMOVABLE FOR EQUIPMENT REMOVAL ACCESS.  
 4. ALL LADDERS REMOVABLE.

NOTE: FOR STEAM FEEDWATER LINE TO SURVIVE GENERAL AUXILIARY FEEDWATER PUMP

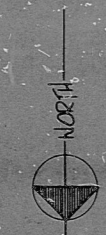

**FOR INFO ONLY**  
**NUREG 612**  
 NUCLEAR SAFETY RELATED

DUKE POWER COMPANY	
CATAWBA NUCLEAR STATION UNITS 1 & 2	
8008190324	
GENERAL ARRANGEMENT	
CONTAINMENT AND REACTOR BUILDING	
UNIT 2 PLAN AT EL. 552+0	
2	RELEASED TO CONSTRUCTION FOR EQUIPMENT ORIENTATION
1	DESIGNED BY: [Signature]
1	CHECKED BY: [Signature]
1	APPROVED BY: [Signature]



RIDS

8208190324

