




TERM BLOCK TYPICAL (SEE NOTE #1)

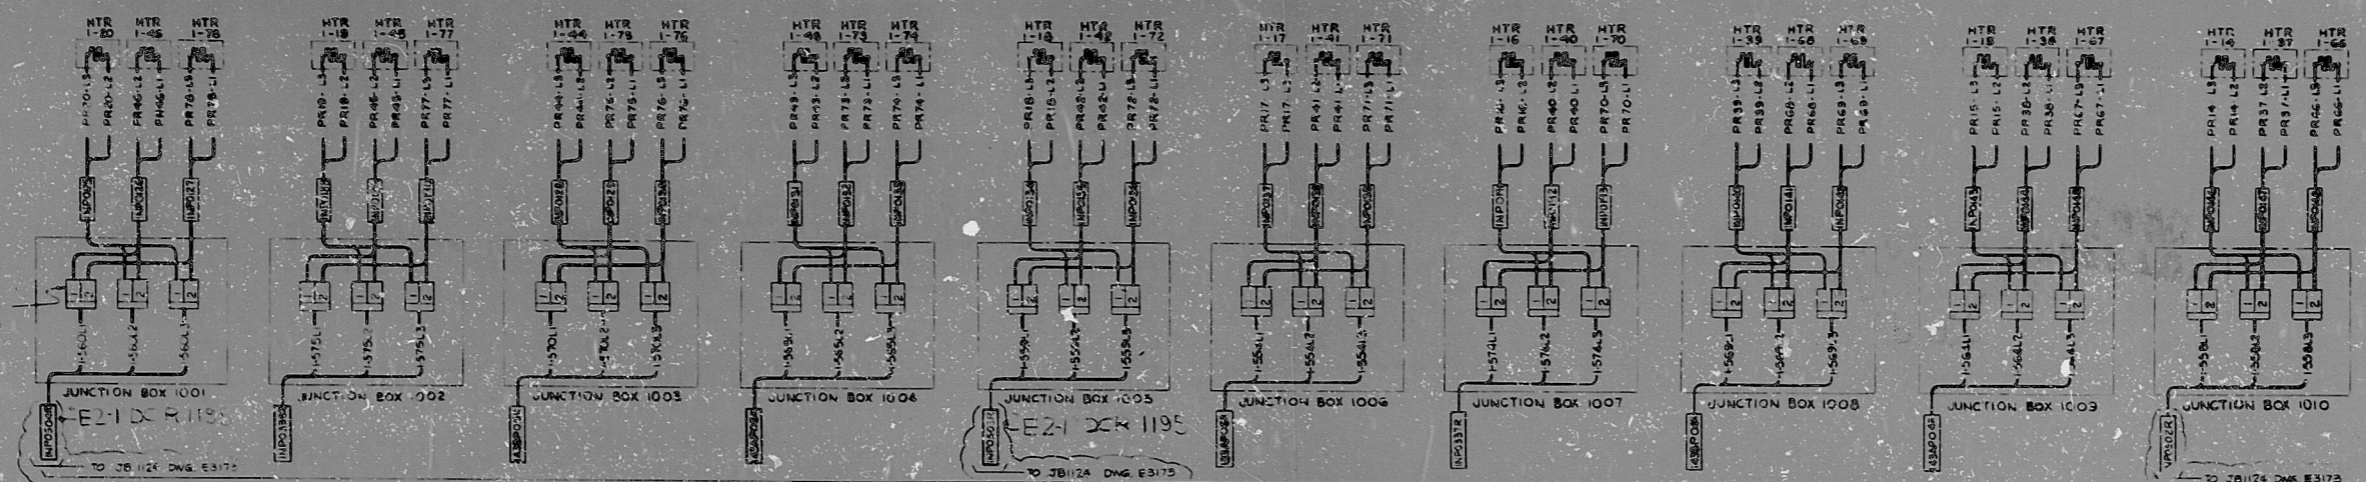


TO JUNCTION BOX JB1137 - DWG 237127A-E520 - FOR LOCATION SEE DWG 237127A-E363

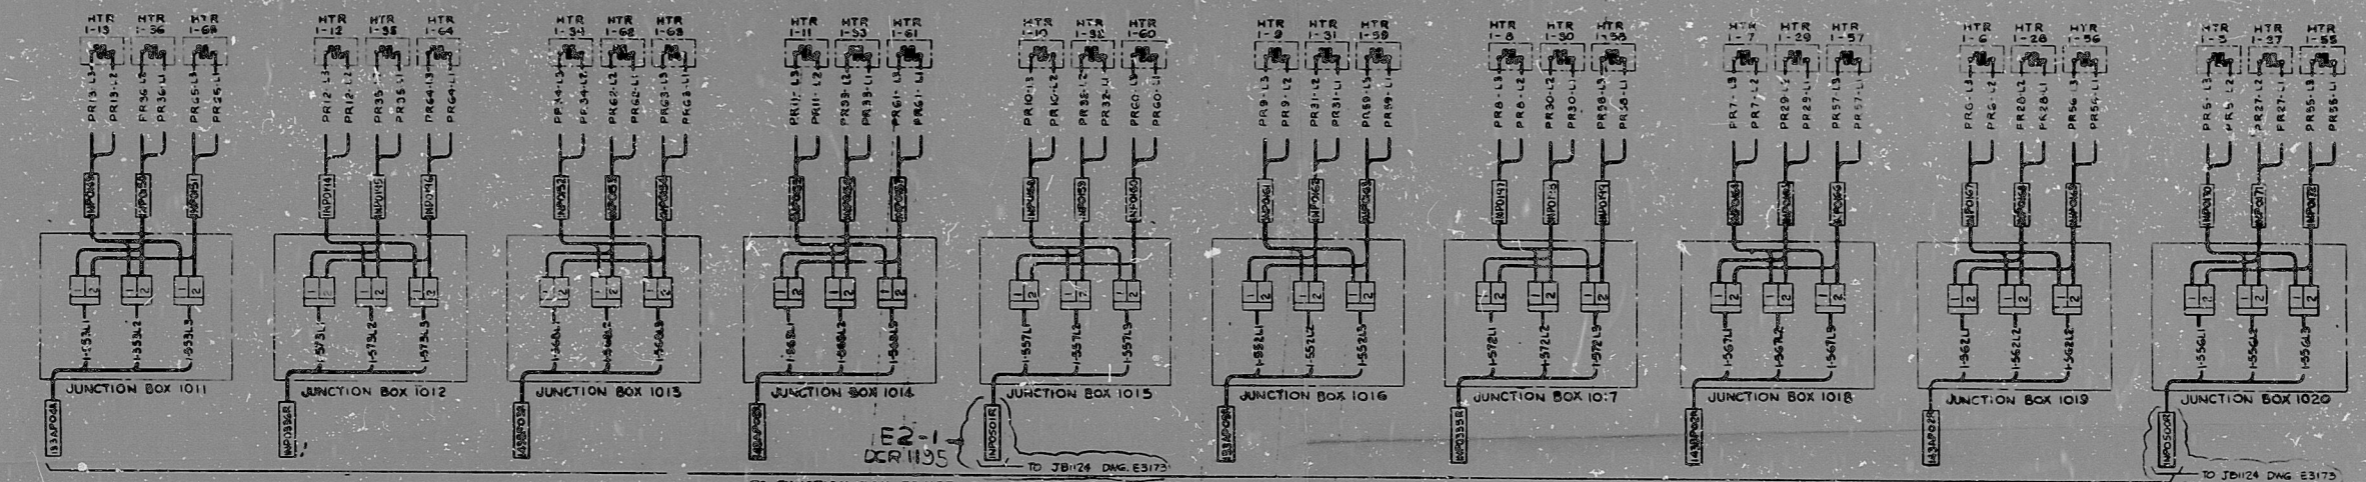

TO JUNCTION BOX JB1137 - DWG 237127A-E520 - FOR LOCATION SEE DWG 237127A-E363

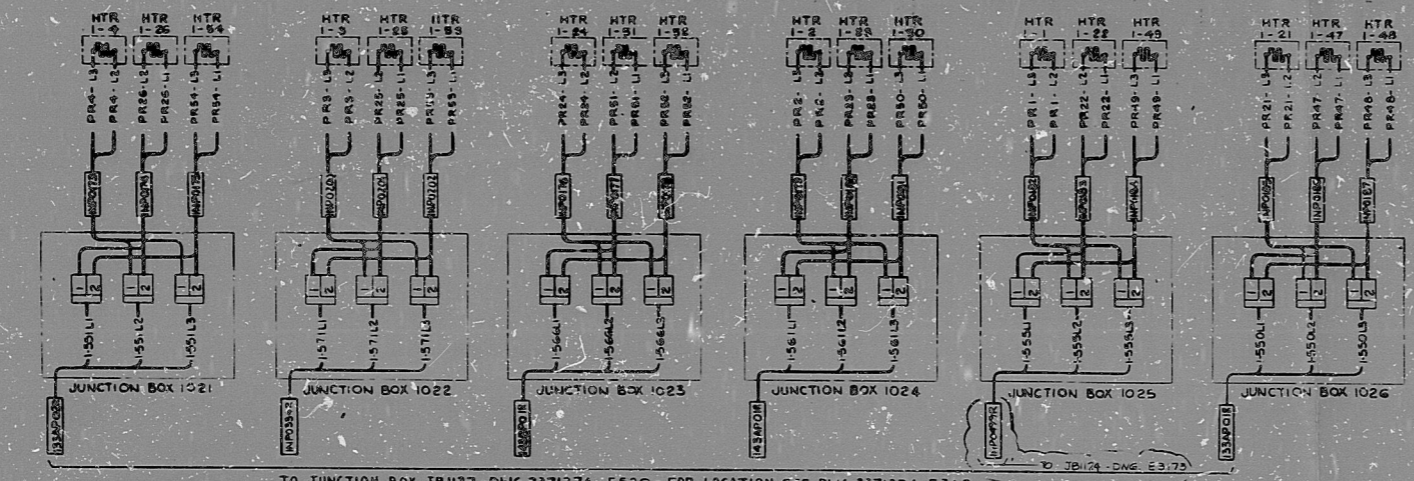


TO JUNCTION BOX JB1137 - DWG 237127A-E520 - FOR LOCATION SEE DWG 237127A-E363

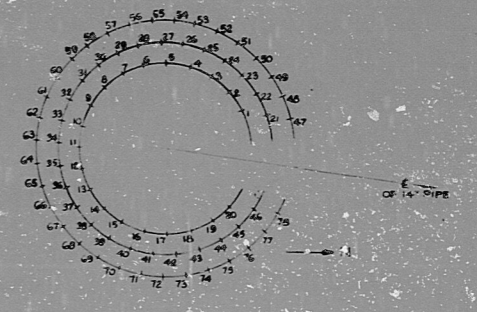

PLAN VIEW OF PRESSURIZER HEATER ARRANGEMENT (LOOKING DOWN FROM TOP)
FOR REFERENCE SEE NUMBERING SEQUENCE OF HTRS AS SHOWN ON WESTINGHOUSE DWG #446190 (SK-10-25)

PRESSURIZER HTRS CONT CAB RD114
(K-100-1643)
FOR LOCATION SEE DWG E301 E830

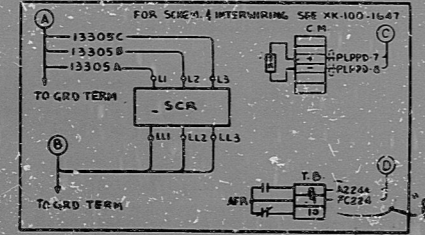

- A - 133P04 TO 480V SWGR BKR #13305 DWG # 237127A-E520
- B - 133P01 TO MCC I-331 DWG # 237127A-E600
- C - MI10362 TO CONTROL RACK PR-105 (L1PP) DWG 237127A-E492
- D - INC350 TO ANN PNL RR152 DWG 237127A-E744

- NOTES:
1. ELECT CONTRACTOR SHALL FURNISH ALL TERM BLOCKS-TIPO BLOCK CAT. # 4 - DE KFR BY APPLIED RESINS CORP.
 2. ATTACHMENT CABLE WIRE TERMINATIONS TO HTRS SHALL BE BURNDY-HYLUS TYPE YAW-L
 3. GROUND CONDUCTOR PROVIDED ON ALL POWER CABLES SHALL BE CONNECTED TO JUNCTION BOX FRAME BY ELECTRICAL CONTRACTOR.
 4. ELECT CONTRACTOR (E-263) SHALL USE LOCKWASHERS ON ALL TERMINAL CONNECTIONS.

- REFERENCES:
- REFERENCE LIST OF ELECTRICAL DWGS 237127A-E200
 - TERMINAL & JUNCTION BOX TABULATION 237127A-E364

REVISIONS

NO.	DATE	DESCRIPTION
1	10/11/67	ISSUED FOR CONSTRUCTION

237127A-E621


WISCONSIN PUBLIC SERVICE CORPORATION

EXTERNAL CONNECTIONS - PRZR HTRS
MCC 1-33A, 1-33B, 1-43A, 1-43B & 1-62B

Pioneer Service & Engineering Co.

237127A-E621-EZ1

8309120521

RIDS

8309120521

