


This drawing and the design it covers is the property of the utilities which are participating in the SNUPPS Project. It is loaned to the borrower's express agreement that it will not be reproduced, copied, loaned, exhibited, or used except in the limited way and private use permitted by the written consent given by the SNUPPS Utilitites to the borrower.

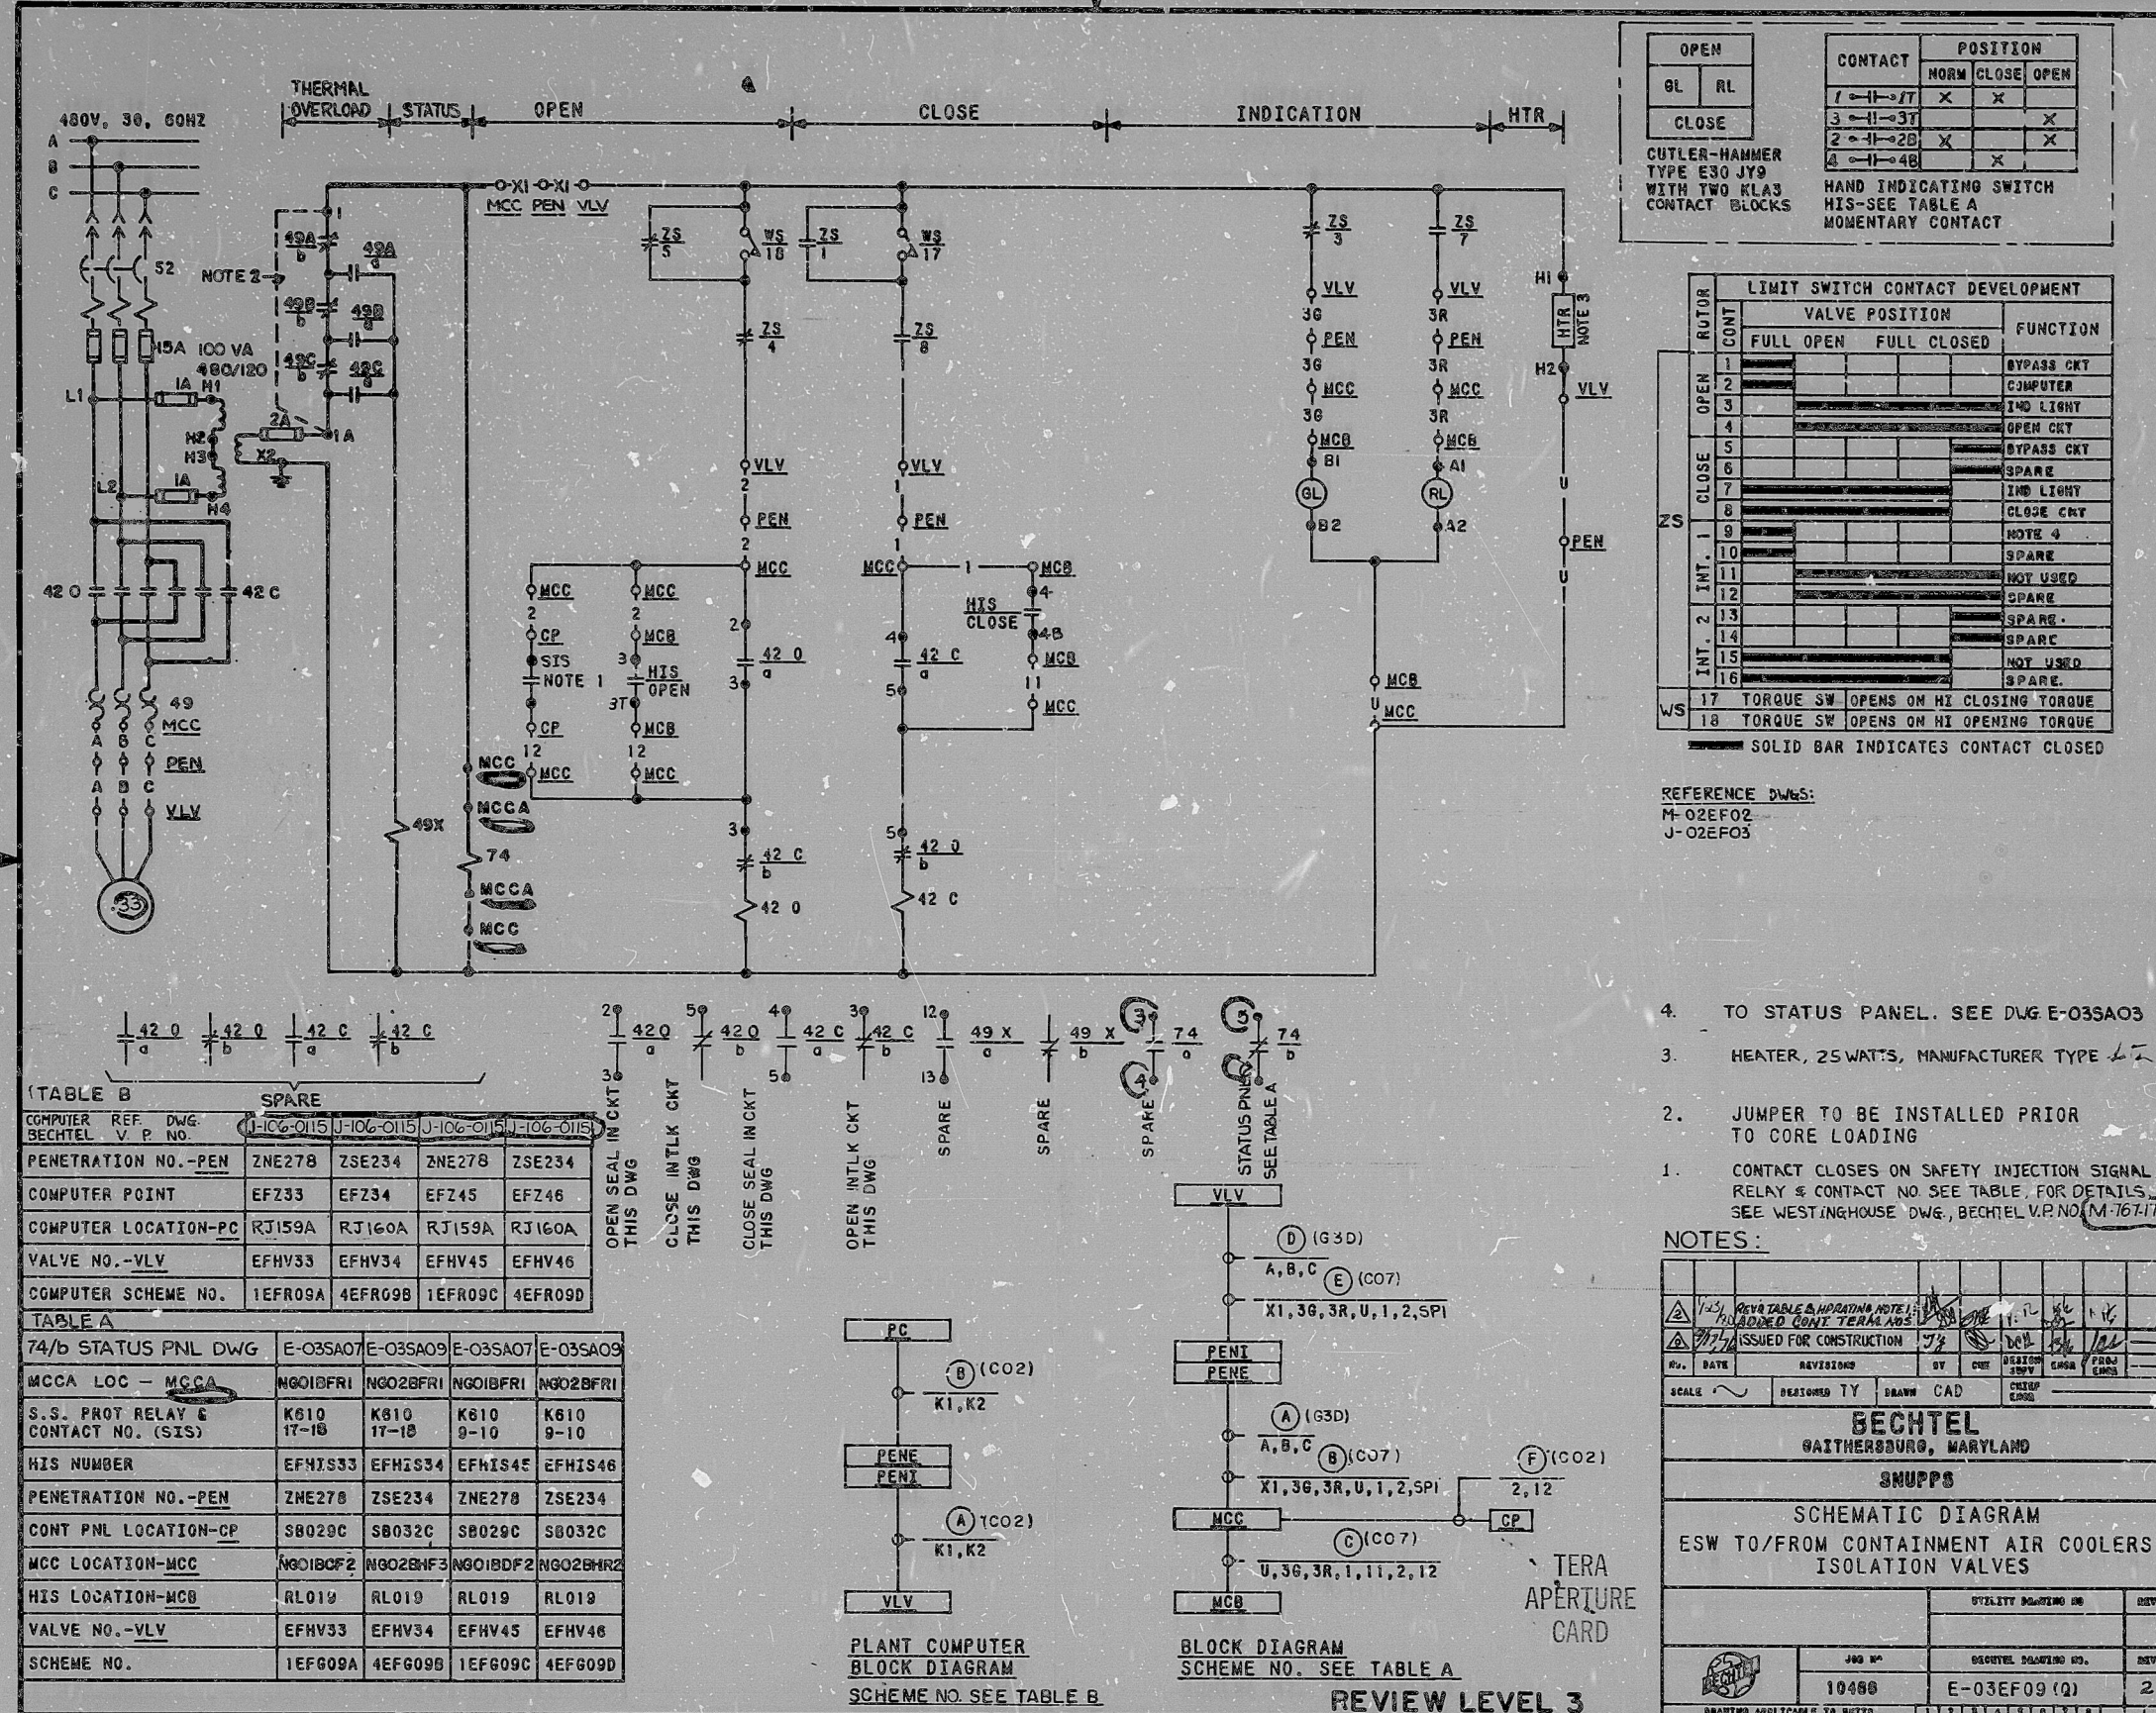

RIDS-POR

8104090702

