

NOTE
FOR GENERAL NOTES AND PREFERENCE DRAWINGS SEE DWG NV1260


SECTION P-P

SECTION Q-Q


PRO APERTURE CARD

NOTE: ALL DUCTWORK AND PIPING UP-CONT DWG NV1263 DN-CONT DWG NV1265

PLAN EL 794-6

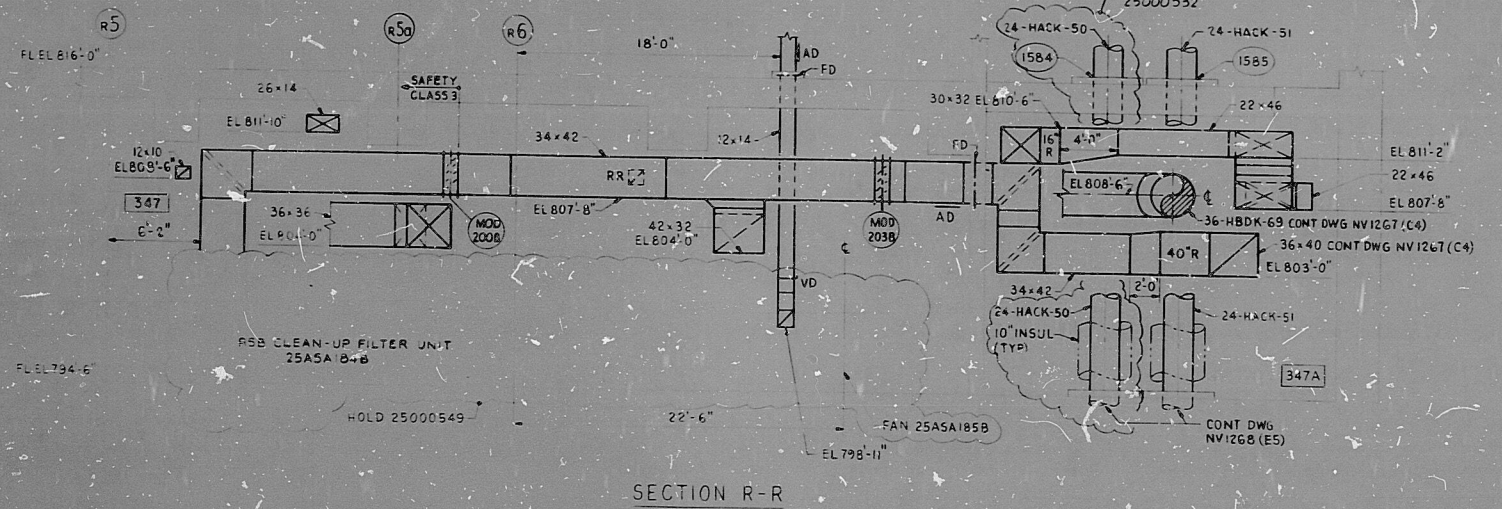

SECTION R-R

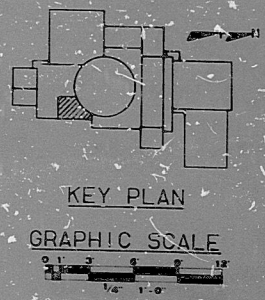

NUCLEAR SAFETY RELATED

REVISION	DATE	BY	CHKD	APP'D	DESCRIPTION
0					RELEASED FOR PROJECT USE



PLAN EL 794-6 & SECTIONS	REV 0
DWG. NO. NV1264	REV. NO. 0

RIDS

809030121

