
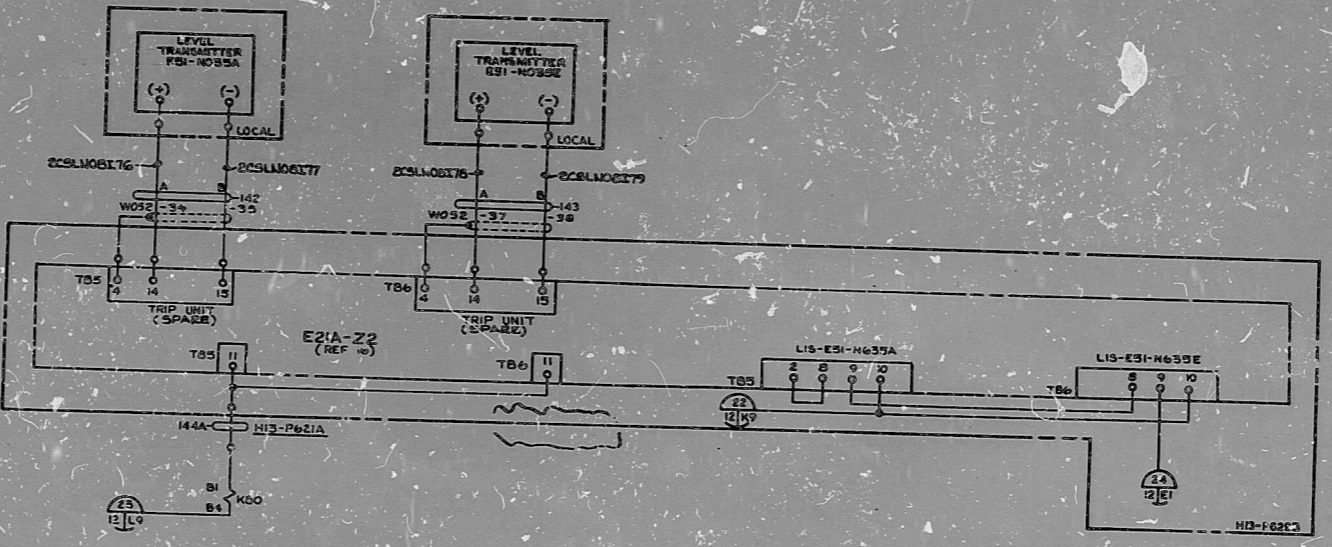
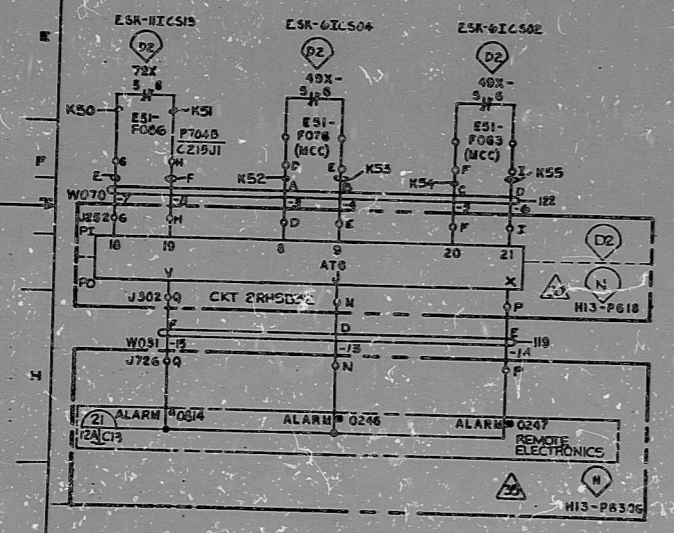
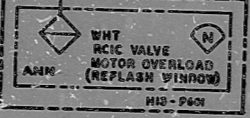


ALL WIRING UNLESS OTHERWISE SPECIFIED ON THIS SHEET

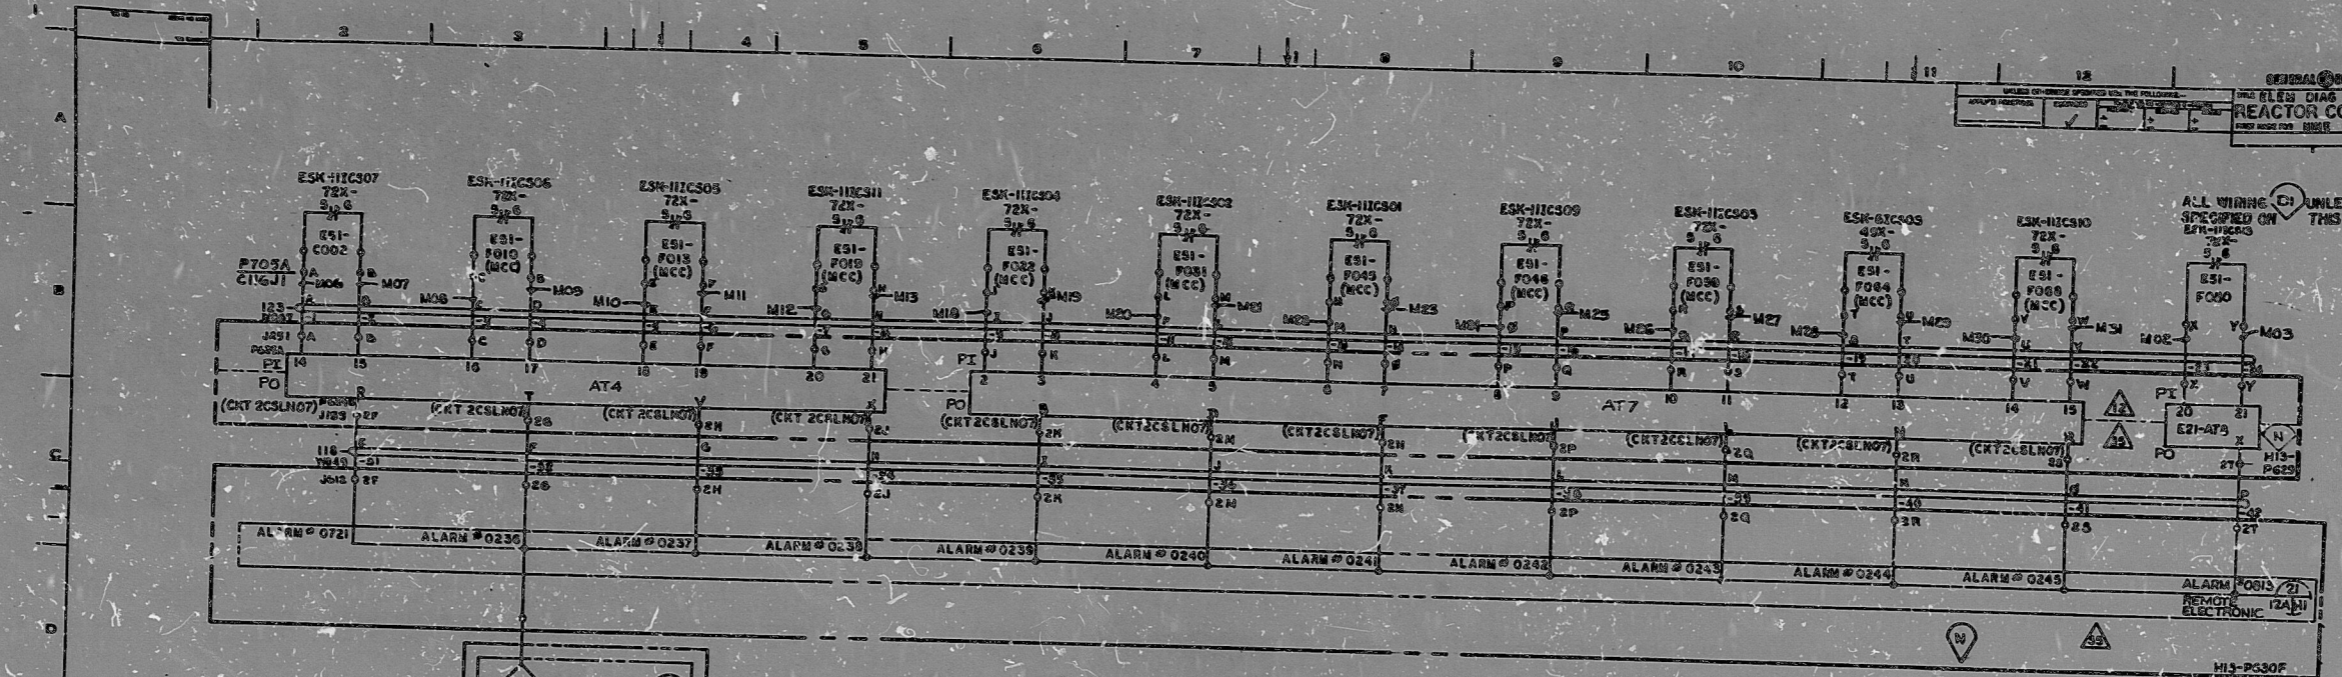

TI  
APERTURE  
CARD

LINE CODE: 115, 119, 122, 125  
113, 143, 144

8507230461


PDR RIDS

8507230461

