


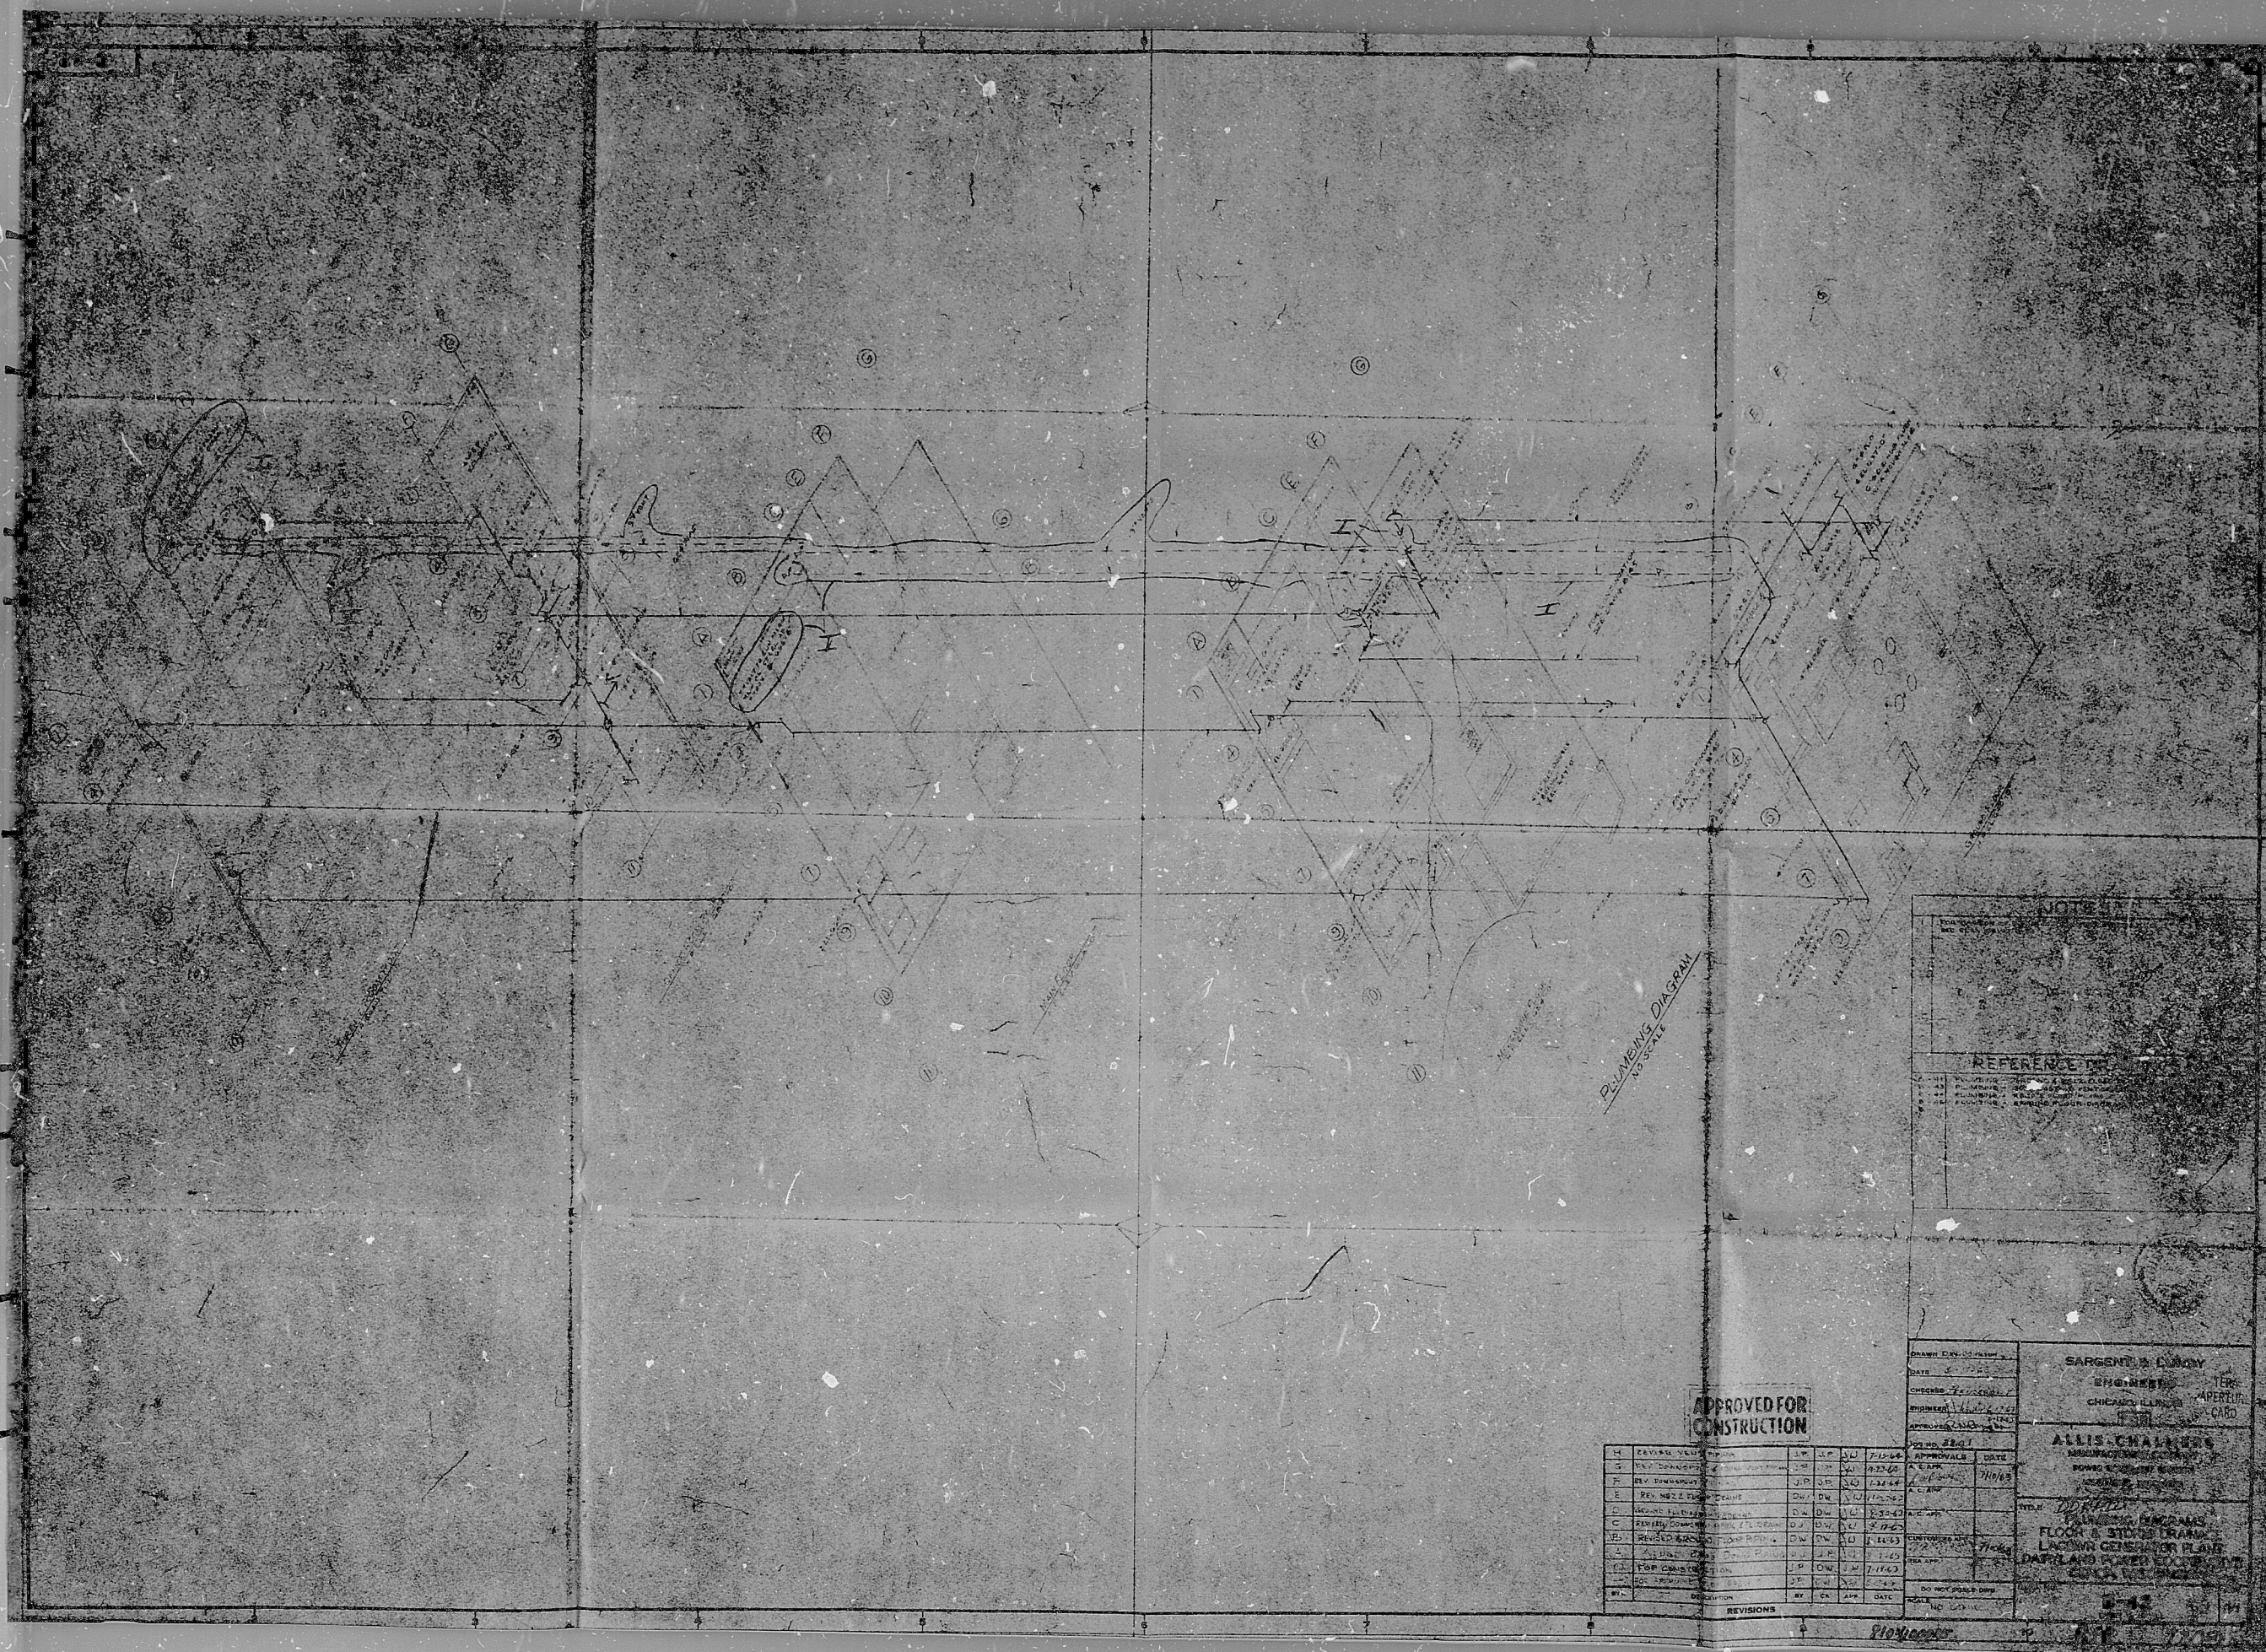


BY	DESCRIPTION	BY
REVISIONS		

DRAWN ONE TO ORDER	
SEA APP.	
DO NOT FOLD OVER	
SCALE NO. 100000	

SARGENT & Lundy
 ENGINEERS
 CHICAGO, ILL. 60
 ALLIS CHALMERS
 MANUFACTURING CO. LTD.
 POWER ENGINEERING
 DIVISION

S.E.P.

8104100025

