


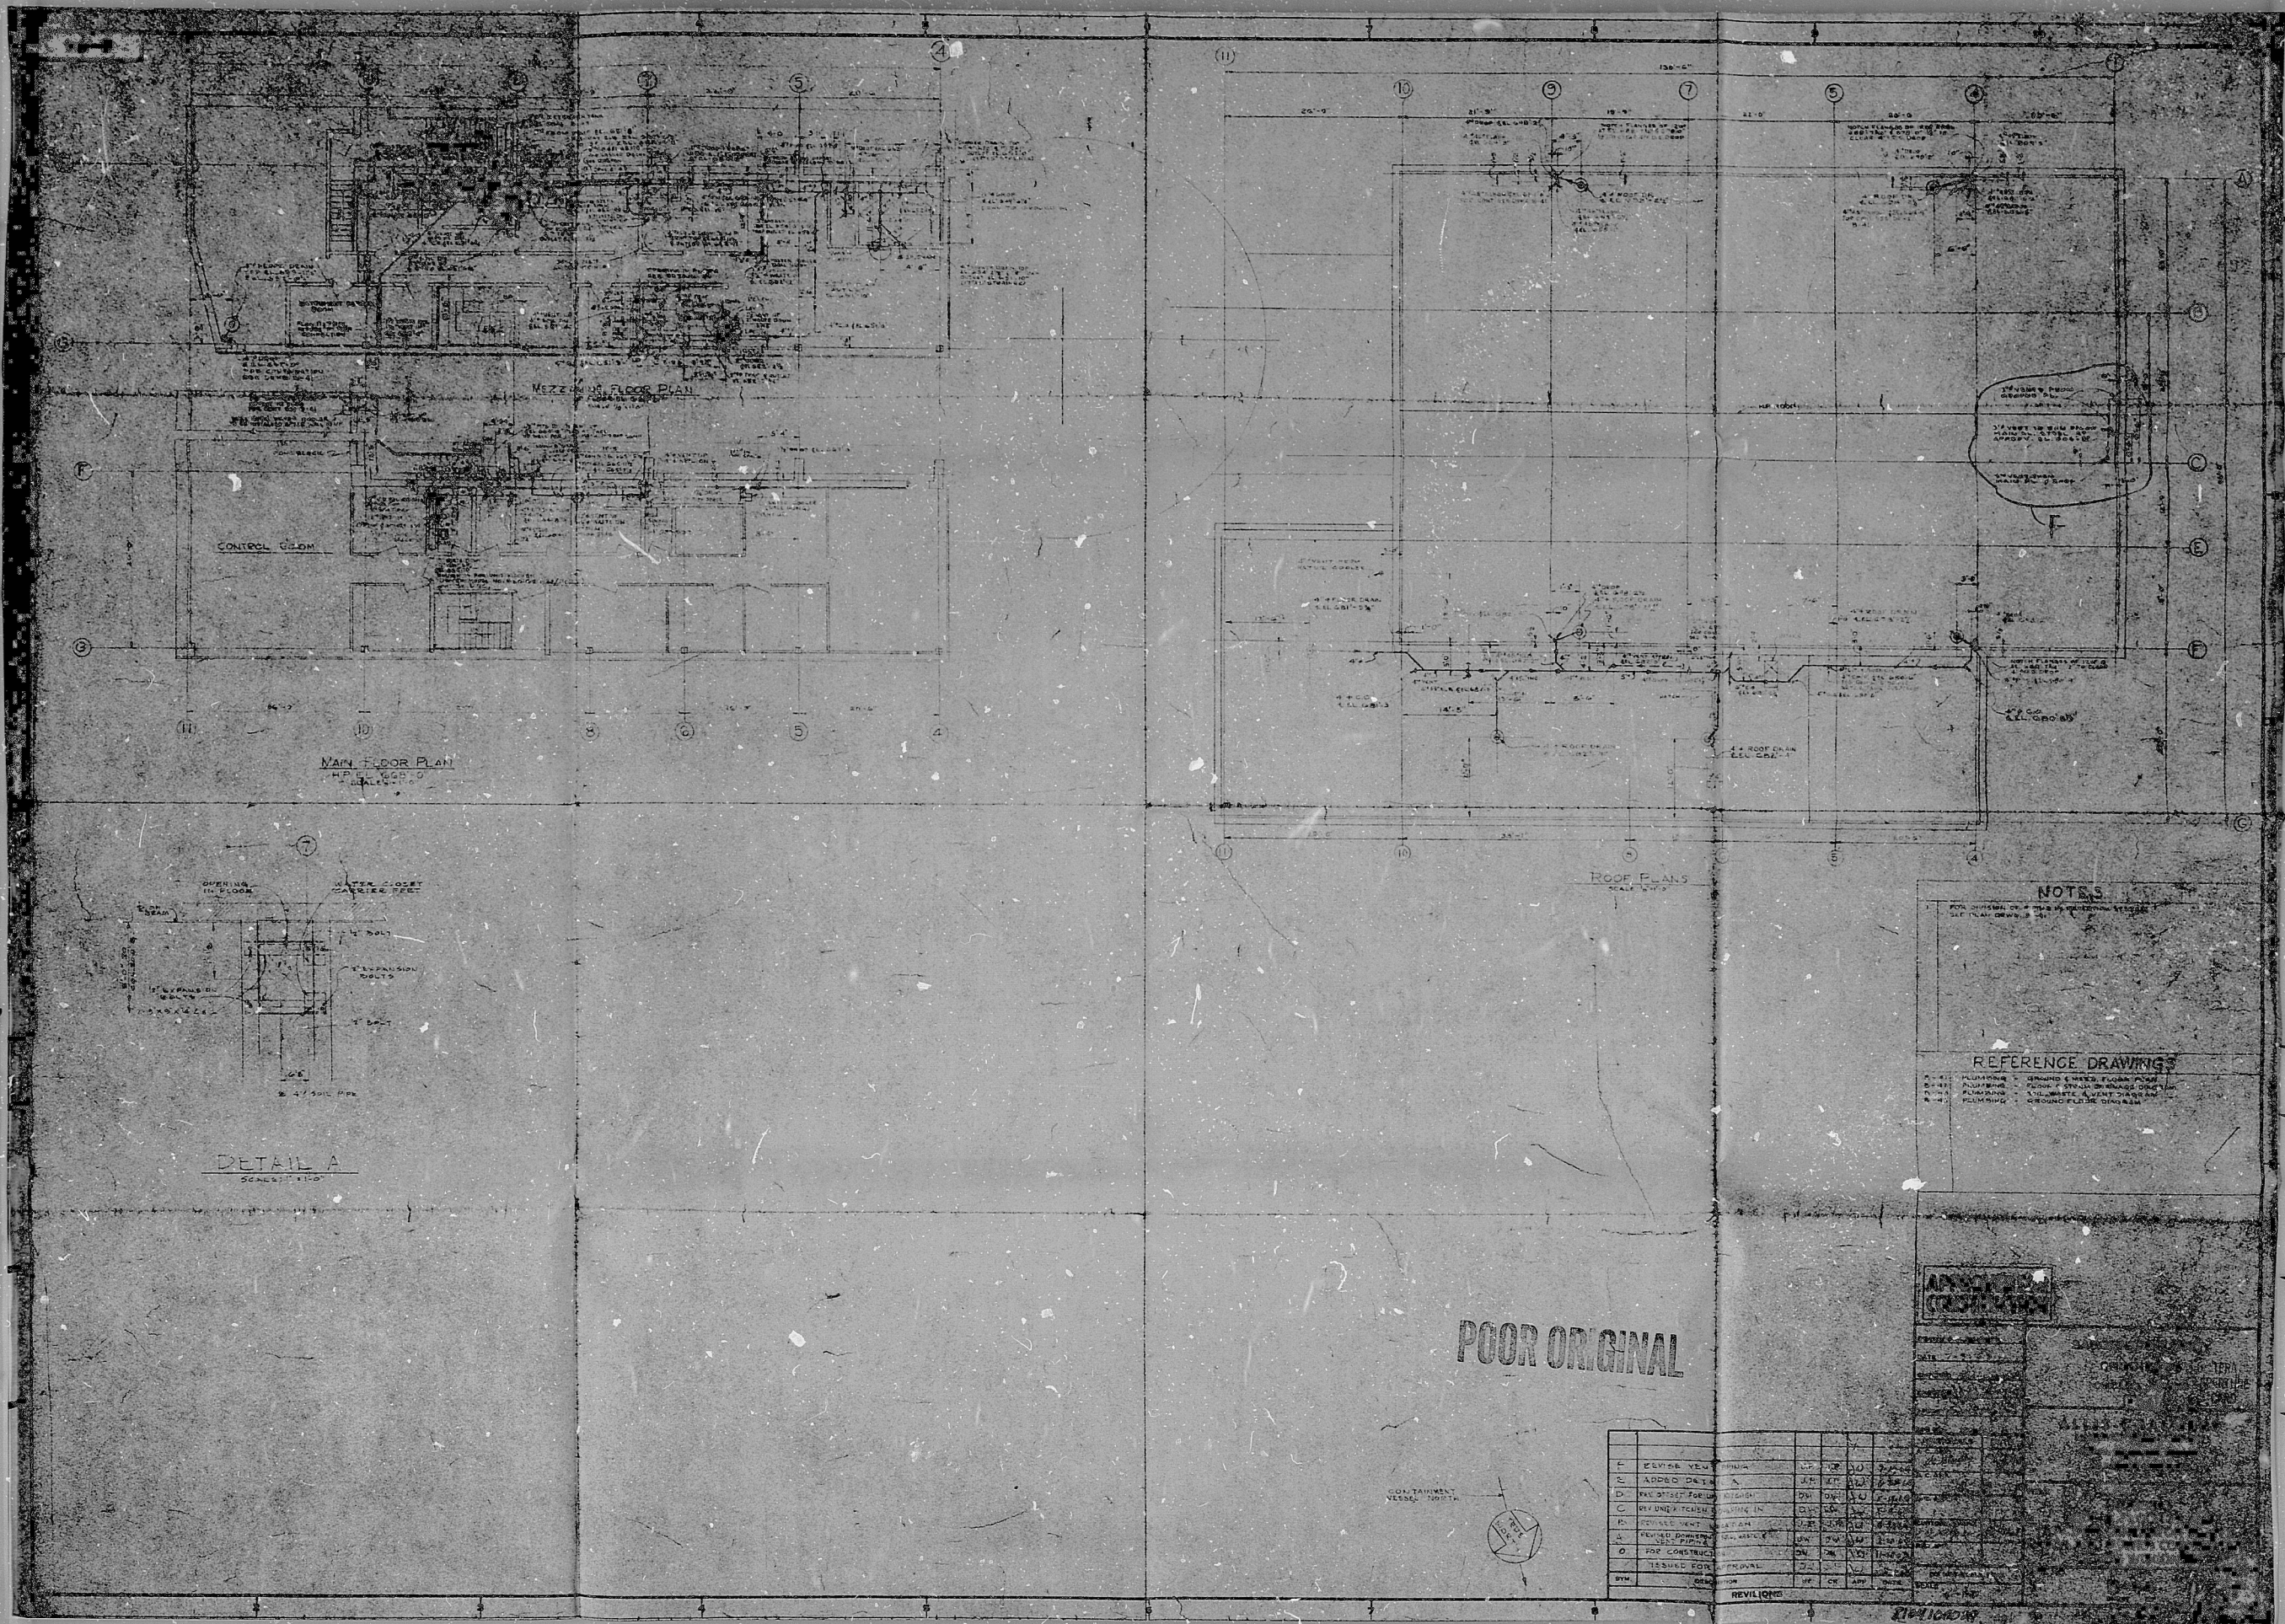

S.E.P.

8104100029

