


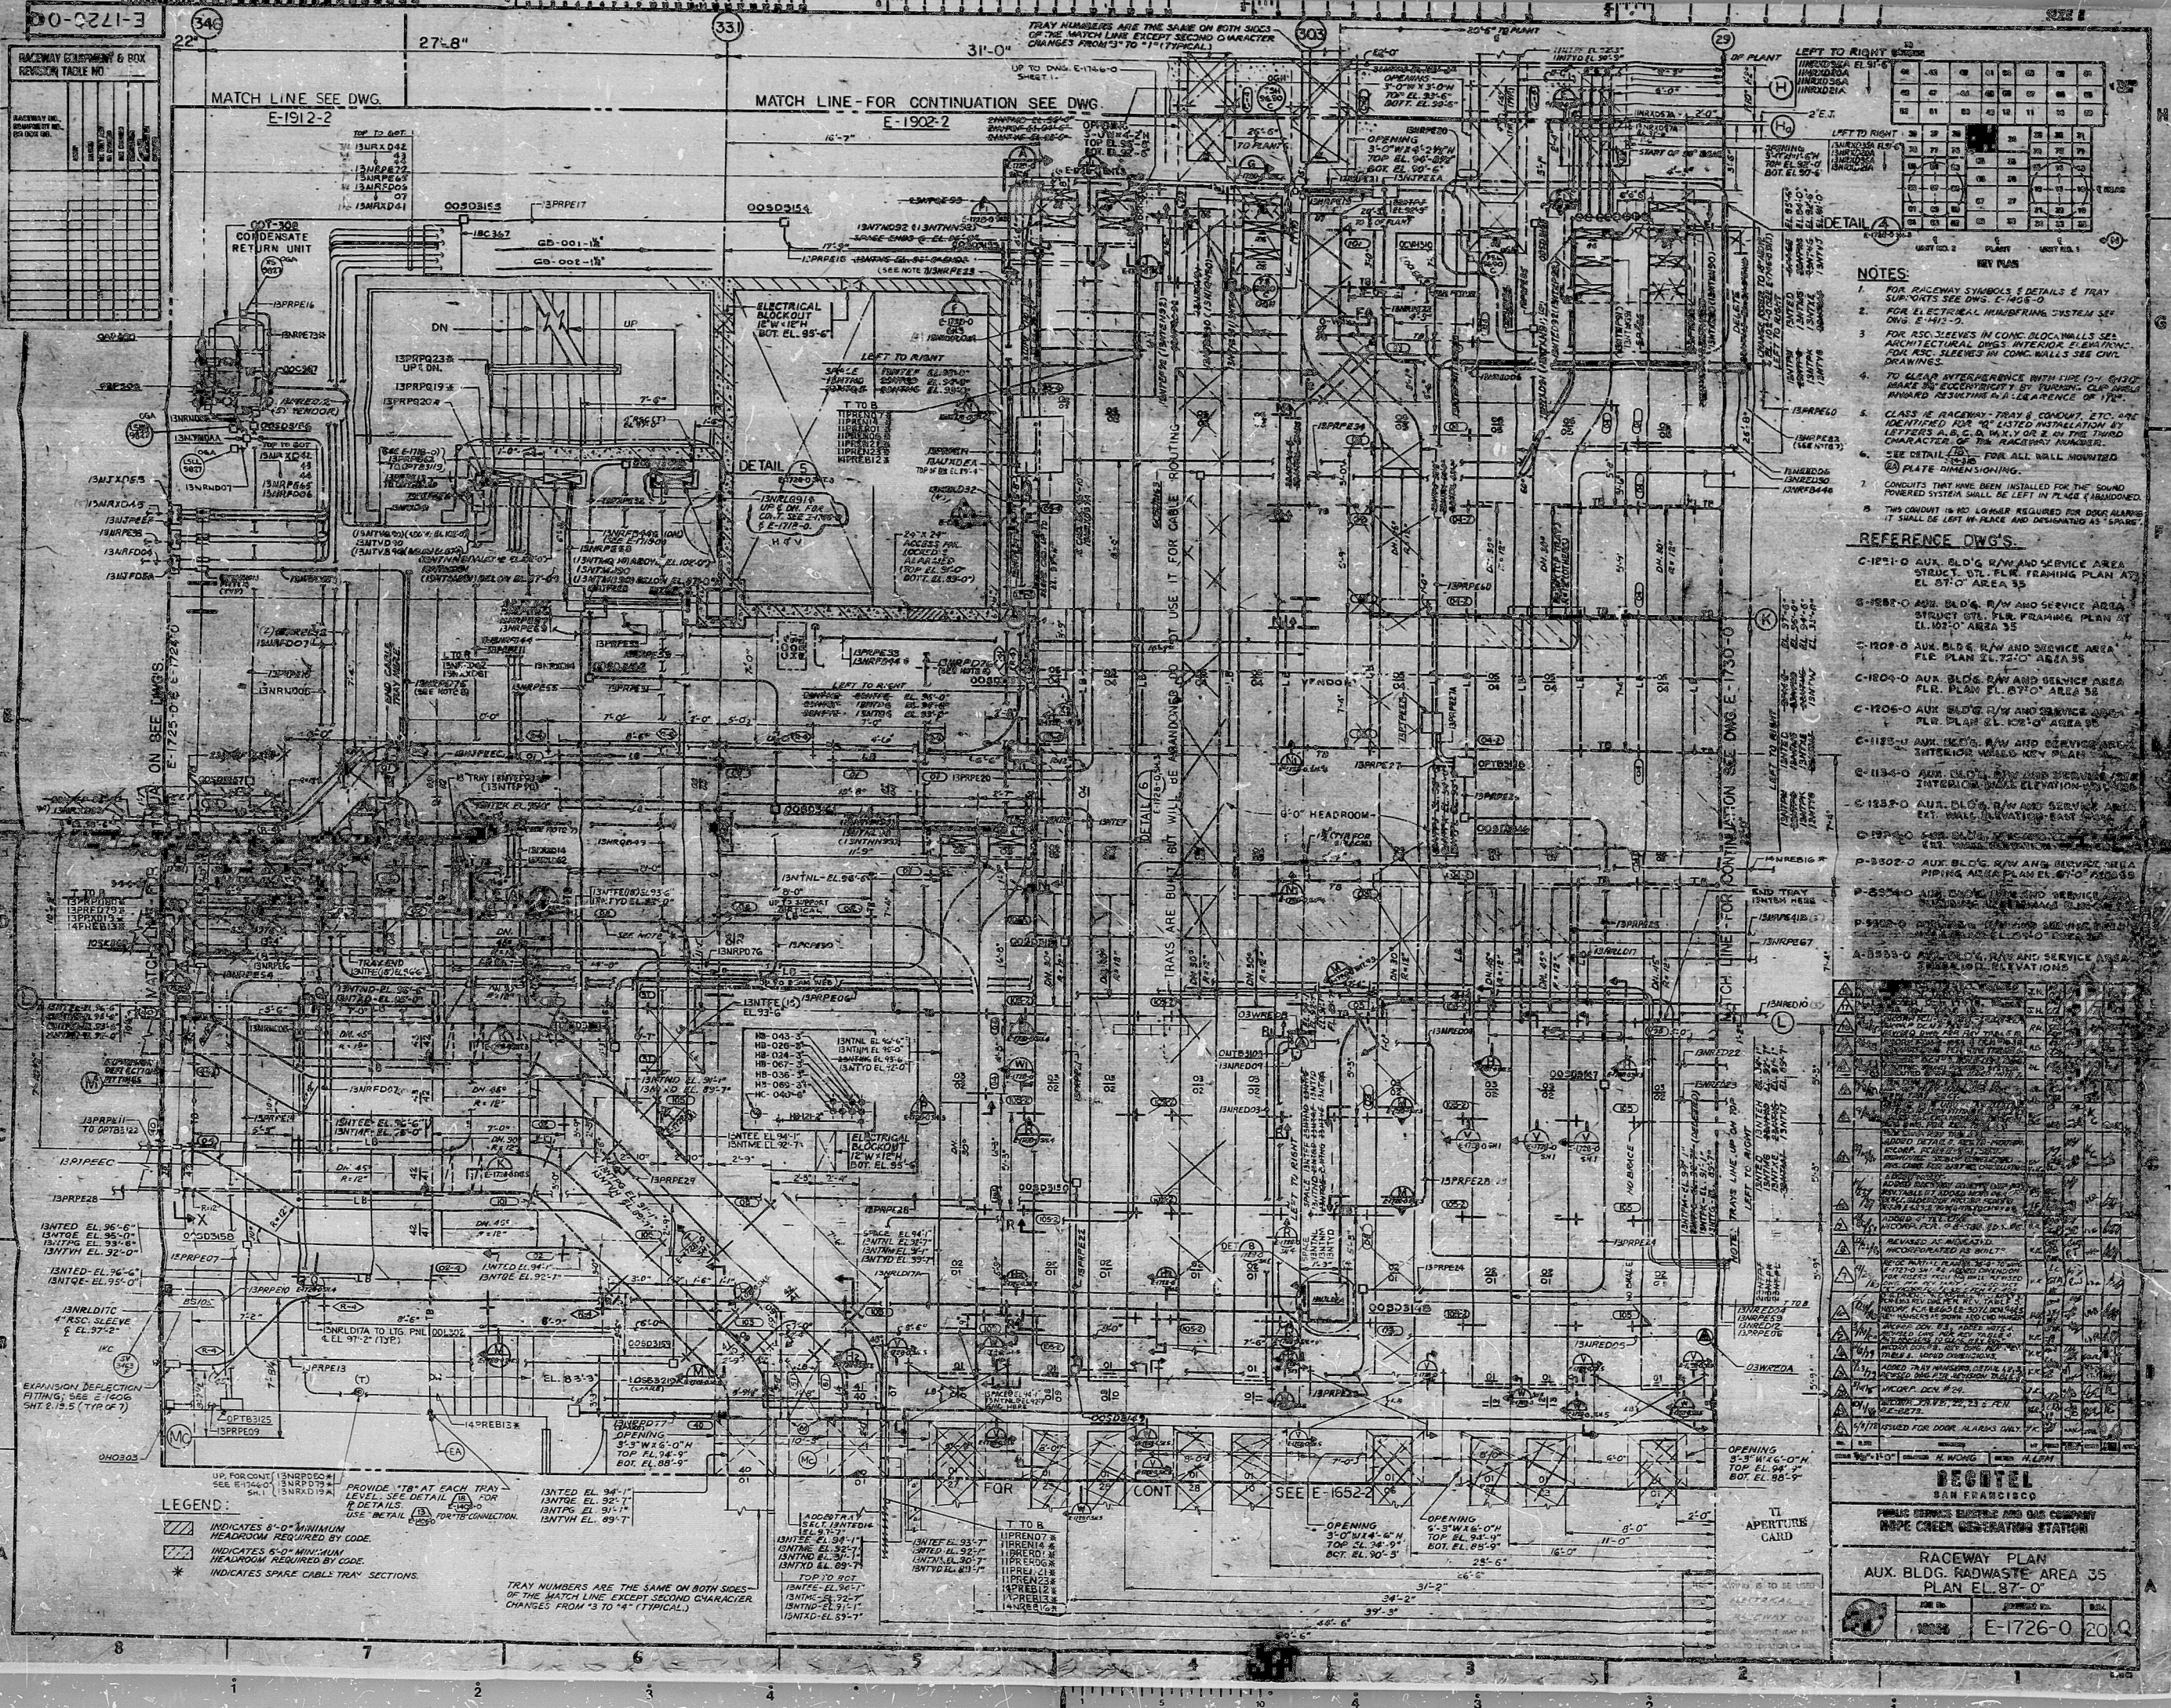

RACEWAY EQUIPMENT & BOX
REVISION TABLE NO.


- NOTES:
- FOR RACEWAY SYMBOLS & DETAILS & TRAY SUPPORTS SEE DWG. E-1408-0
 - FOR ELECTRICAL NUMBERING SYSTEM SEE DWG. E-1412-0
 - FOR ALL SLEEVES IN CONC. BLOCK WALLS SEE ARCHITECTURAL DWG. INTERIOR ELEVATION. FOR ALL SLEEVES IN CONC. WALLS SEE CIVIL DRAWINGS
 - TO CLEAR INTERFERENCE WITH PIPE (10-1) CHD. MAKE AN OCCASIONAL 90° TURNING. CLEARANCE MINIMUM 2" BETWEEN SLEEVES & 1/2" CLEARANCE OF 1/2"
 - CLASS "B" RACEWAY - TRAY & CONDUIT, ETC. ARE IDENTIFIED FOR LISTED INSTALLATION BY LETTERS A, B, C, UY, UV, UW, UX, ZZ

- REFERENCE DWGS.

LEGEND:

- INDICATES 8'-0" MINIMUM HEADROOM REQUIRED BY CODE.
- INDICATES 6'-0" MINIMUM HEADROOM REQUIRED BY CODE.
- INDICATES SPARE CABLE TRAY SECTIONS.

TRAY NUMBERS ARE THE SAME ON BOTH SIDES OF THE MATCH LINE EXCEPT SECOND CHARACTER CHANGES FROM "3" TO "4" (TYPICAL)


SAN FRANCISCO



RACEWAY PLAN

AUX. BLDG. R/W AND SERVICE AREA 35


NO.	DATE	BY	CHKD.
1	10/1/58	E-1726-0	20

PDR RIDS

850729039L

