


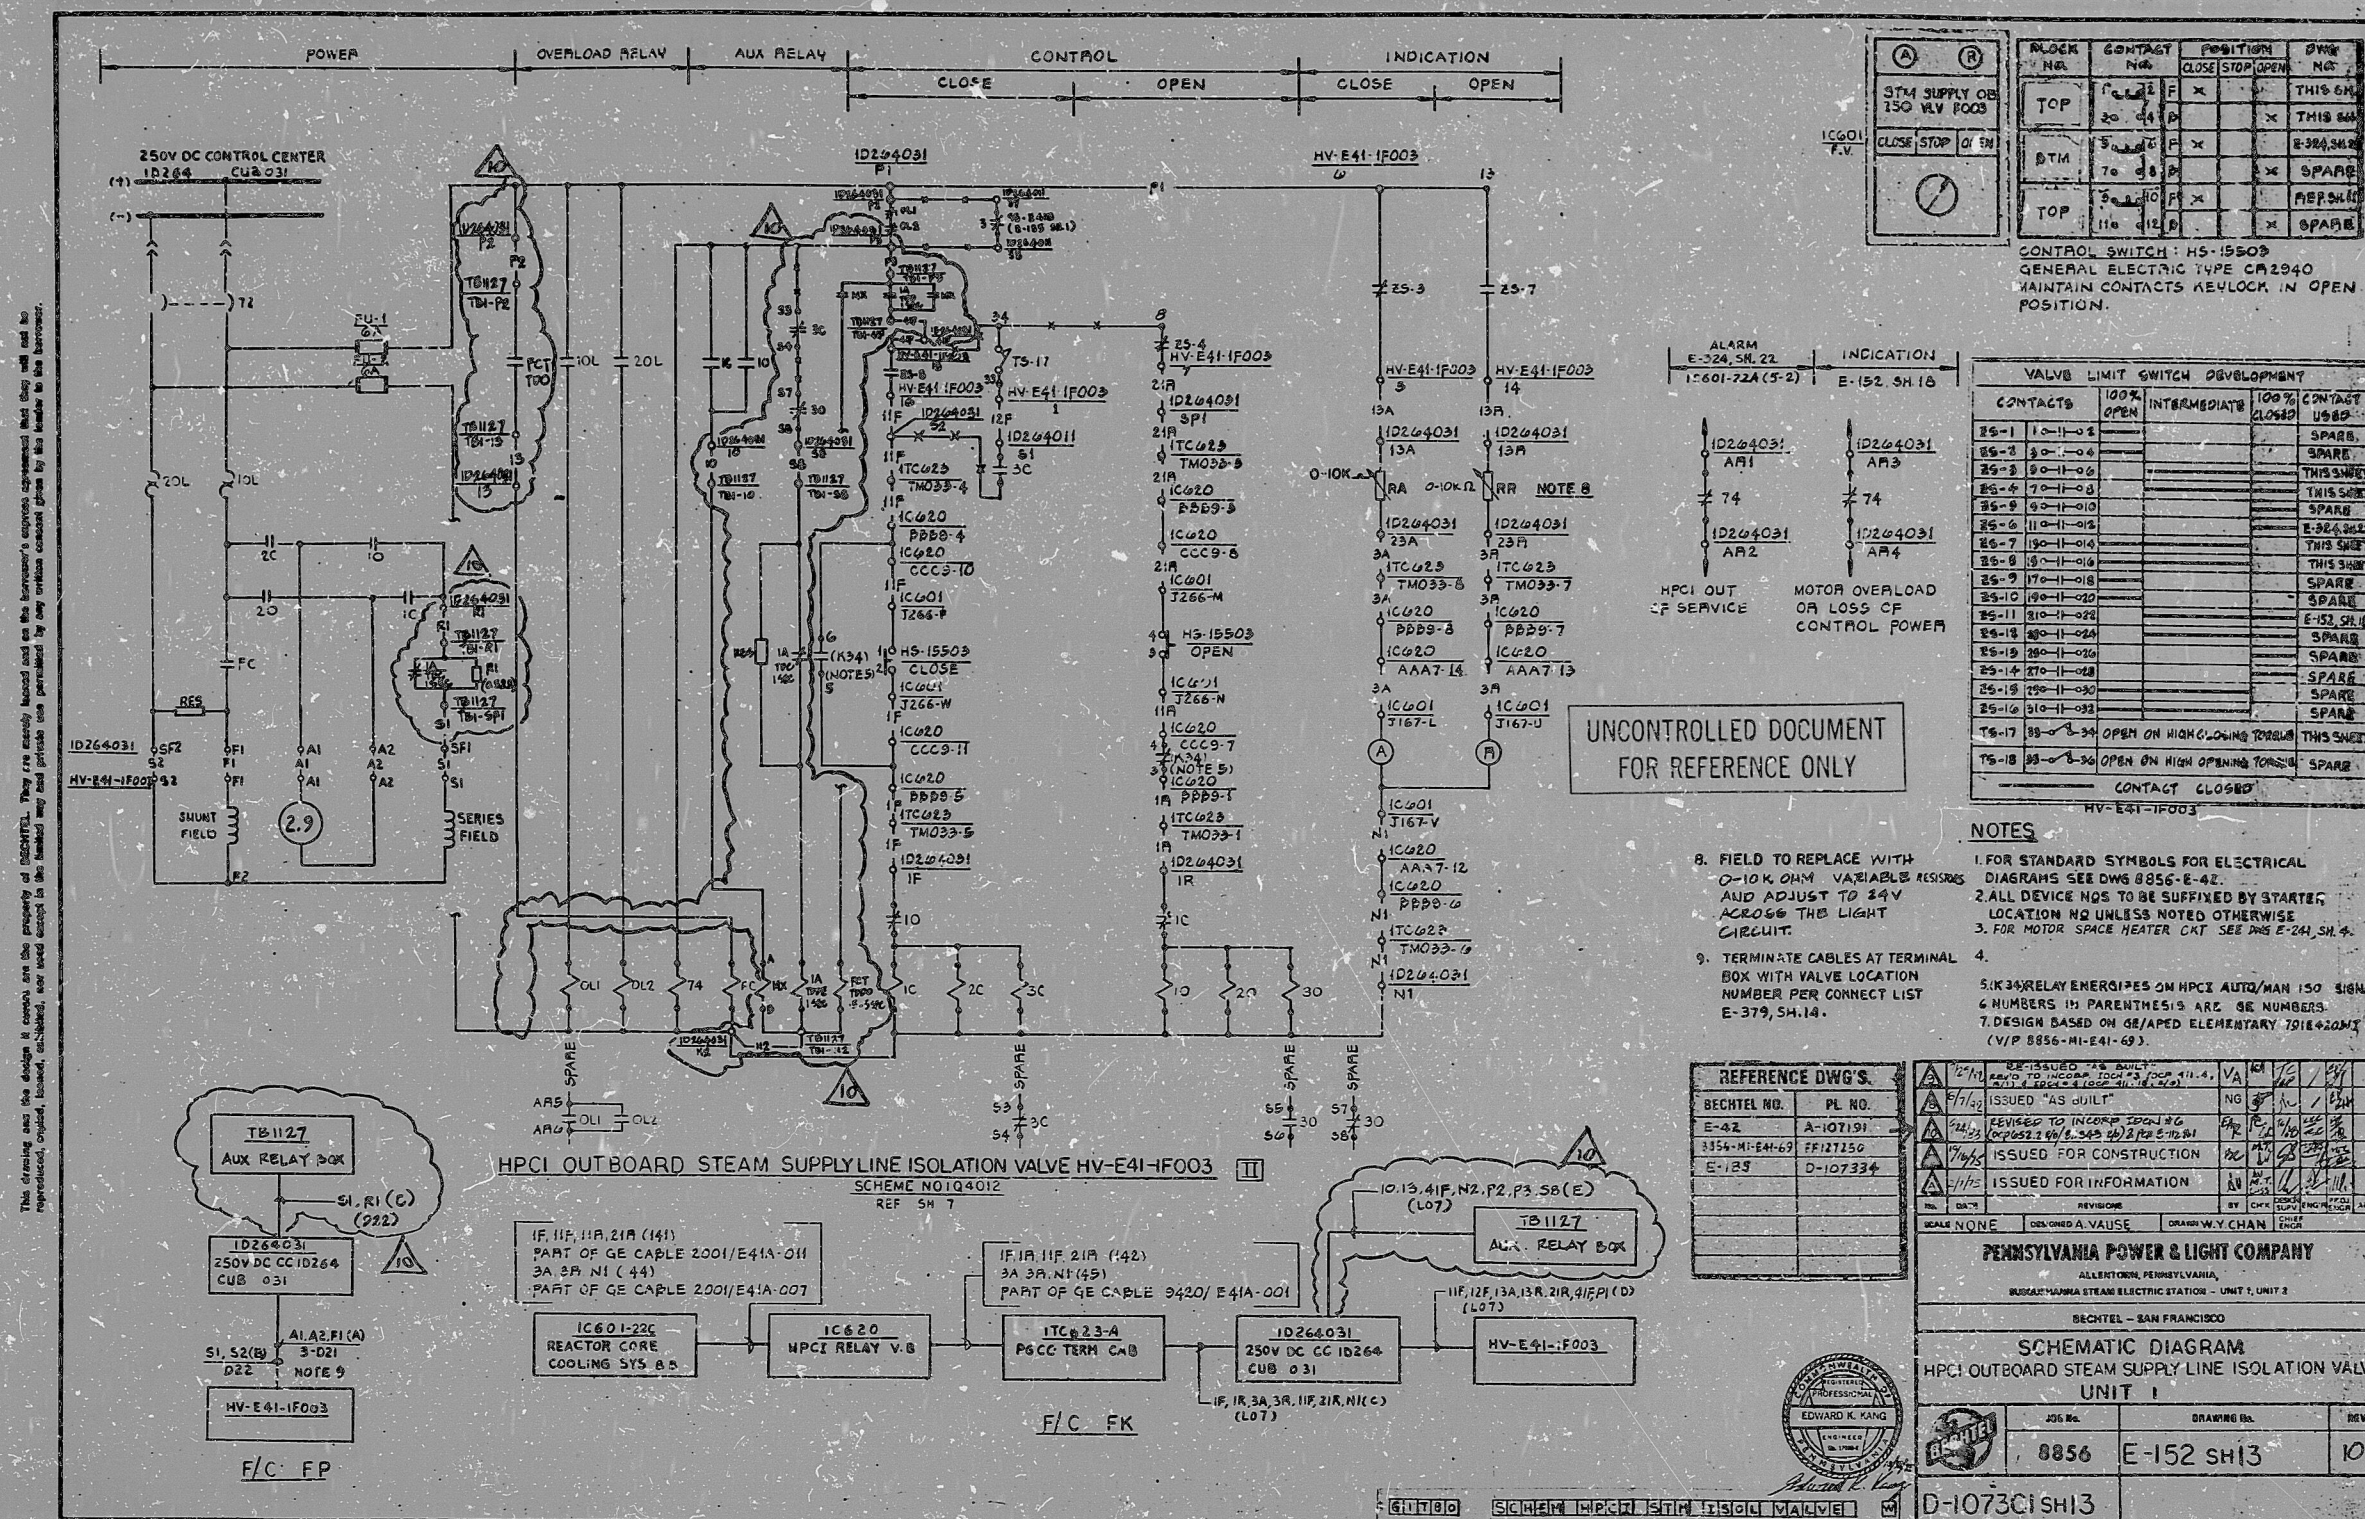

24X

PRC
APERTURE
CARD

RIDS

8309210058

