


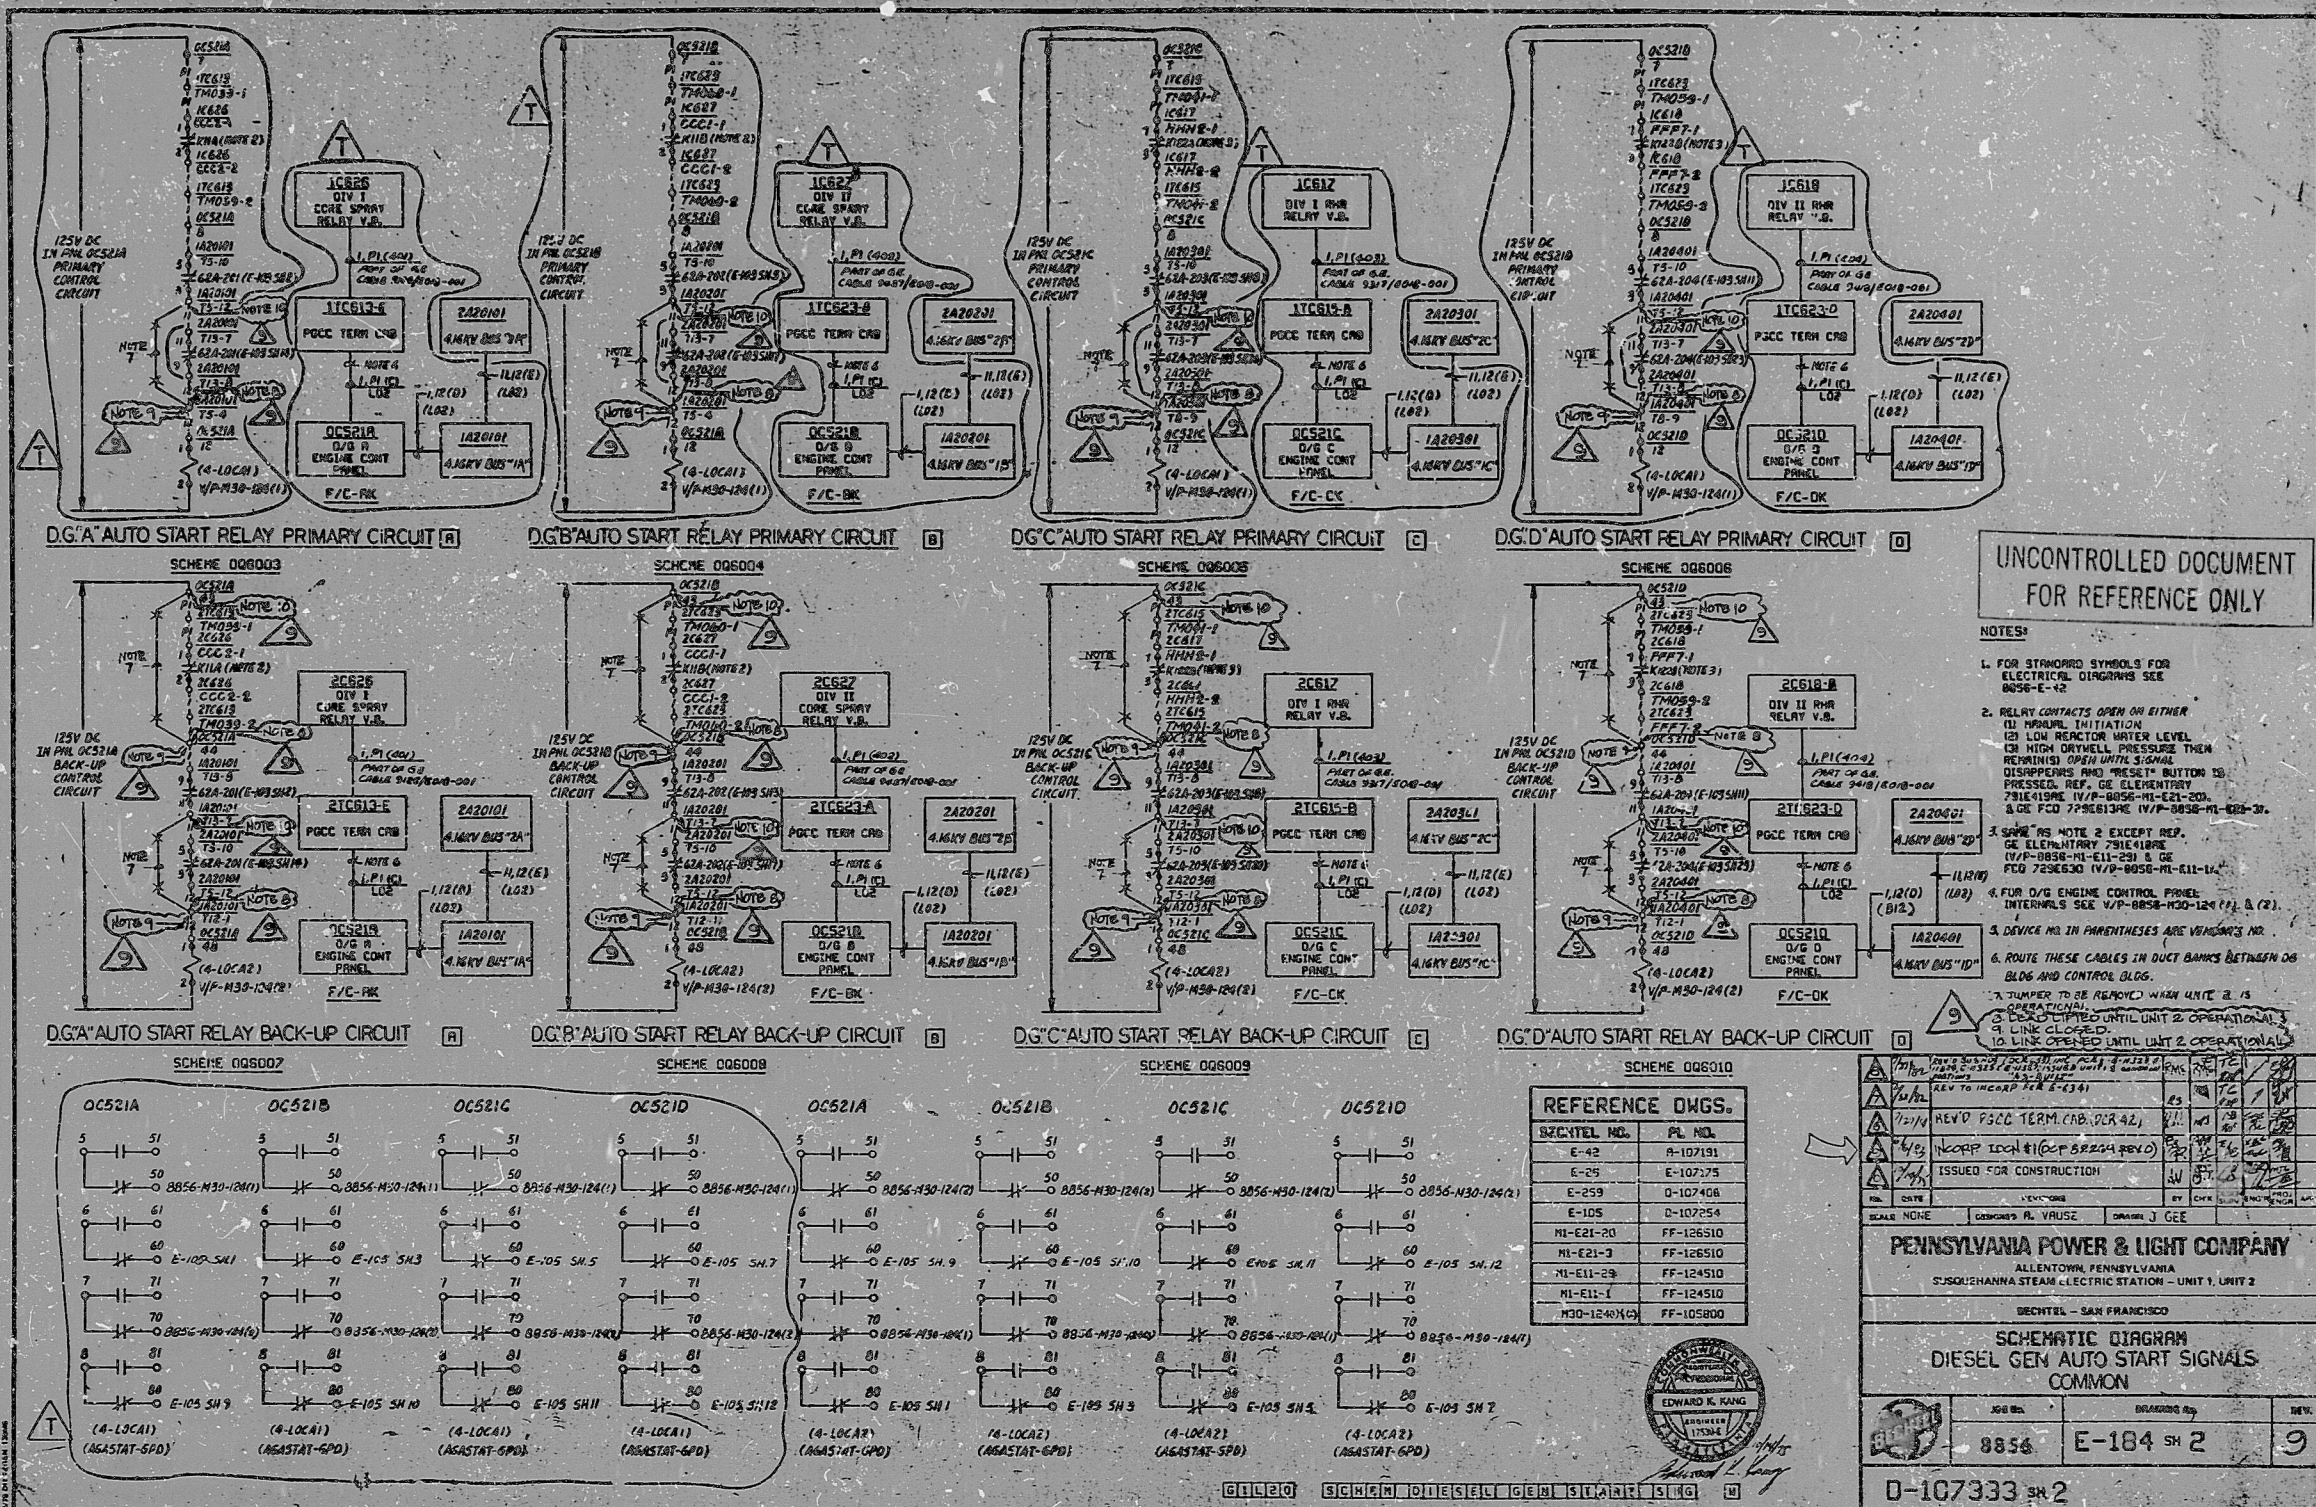

24X

I certify that the microfilm image contained on this microform was made in the normal and regular course of business. This is a true, full, correct and complete reproduction and replacement for use in lieu of original documents.

F. J. HARRIS, JR.  
6-21-83  
Micro Type MICRO-1

PRC  
APERTURE  
CARD



RIDS

8309210083

