


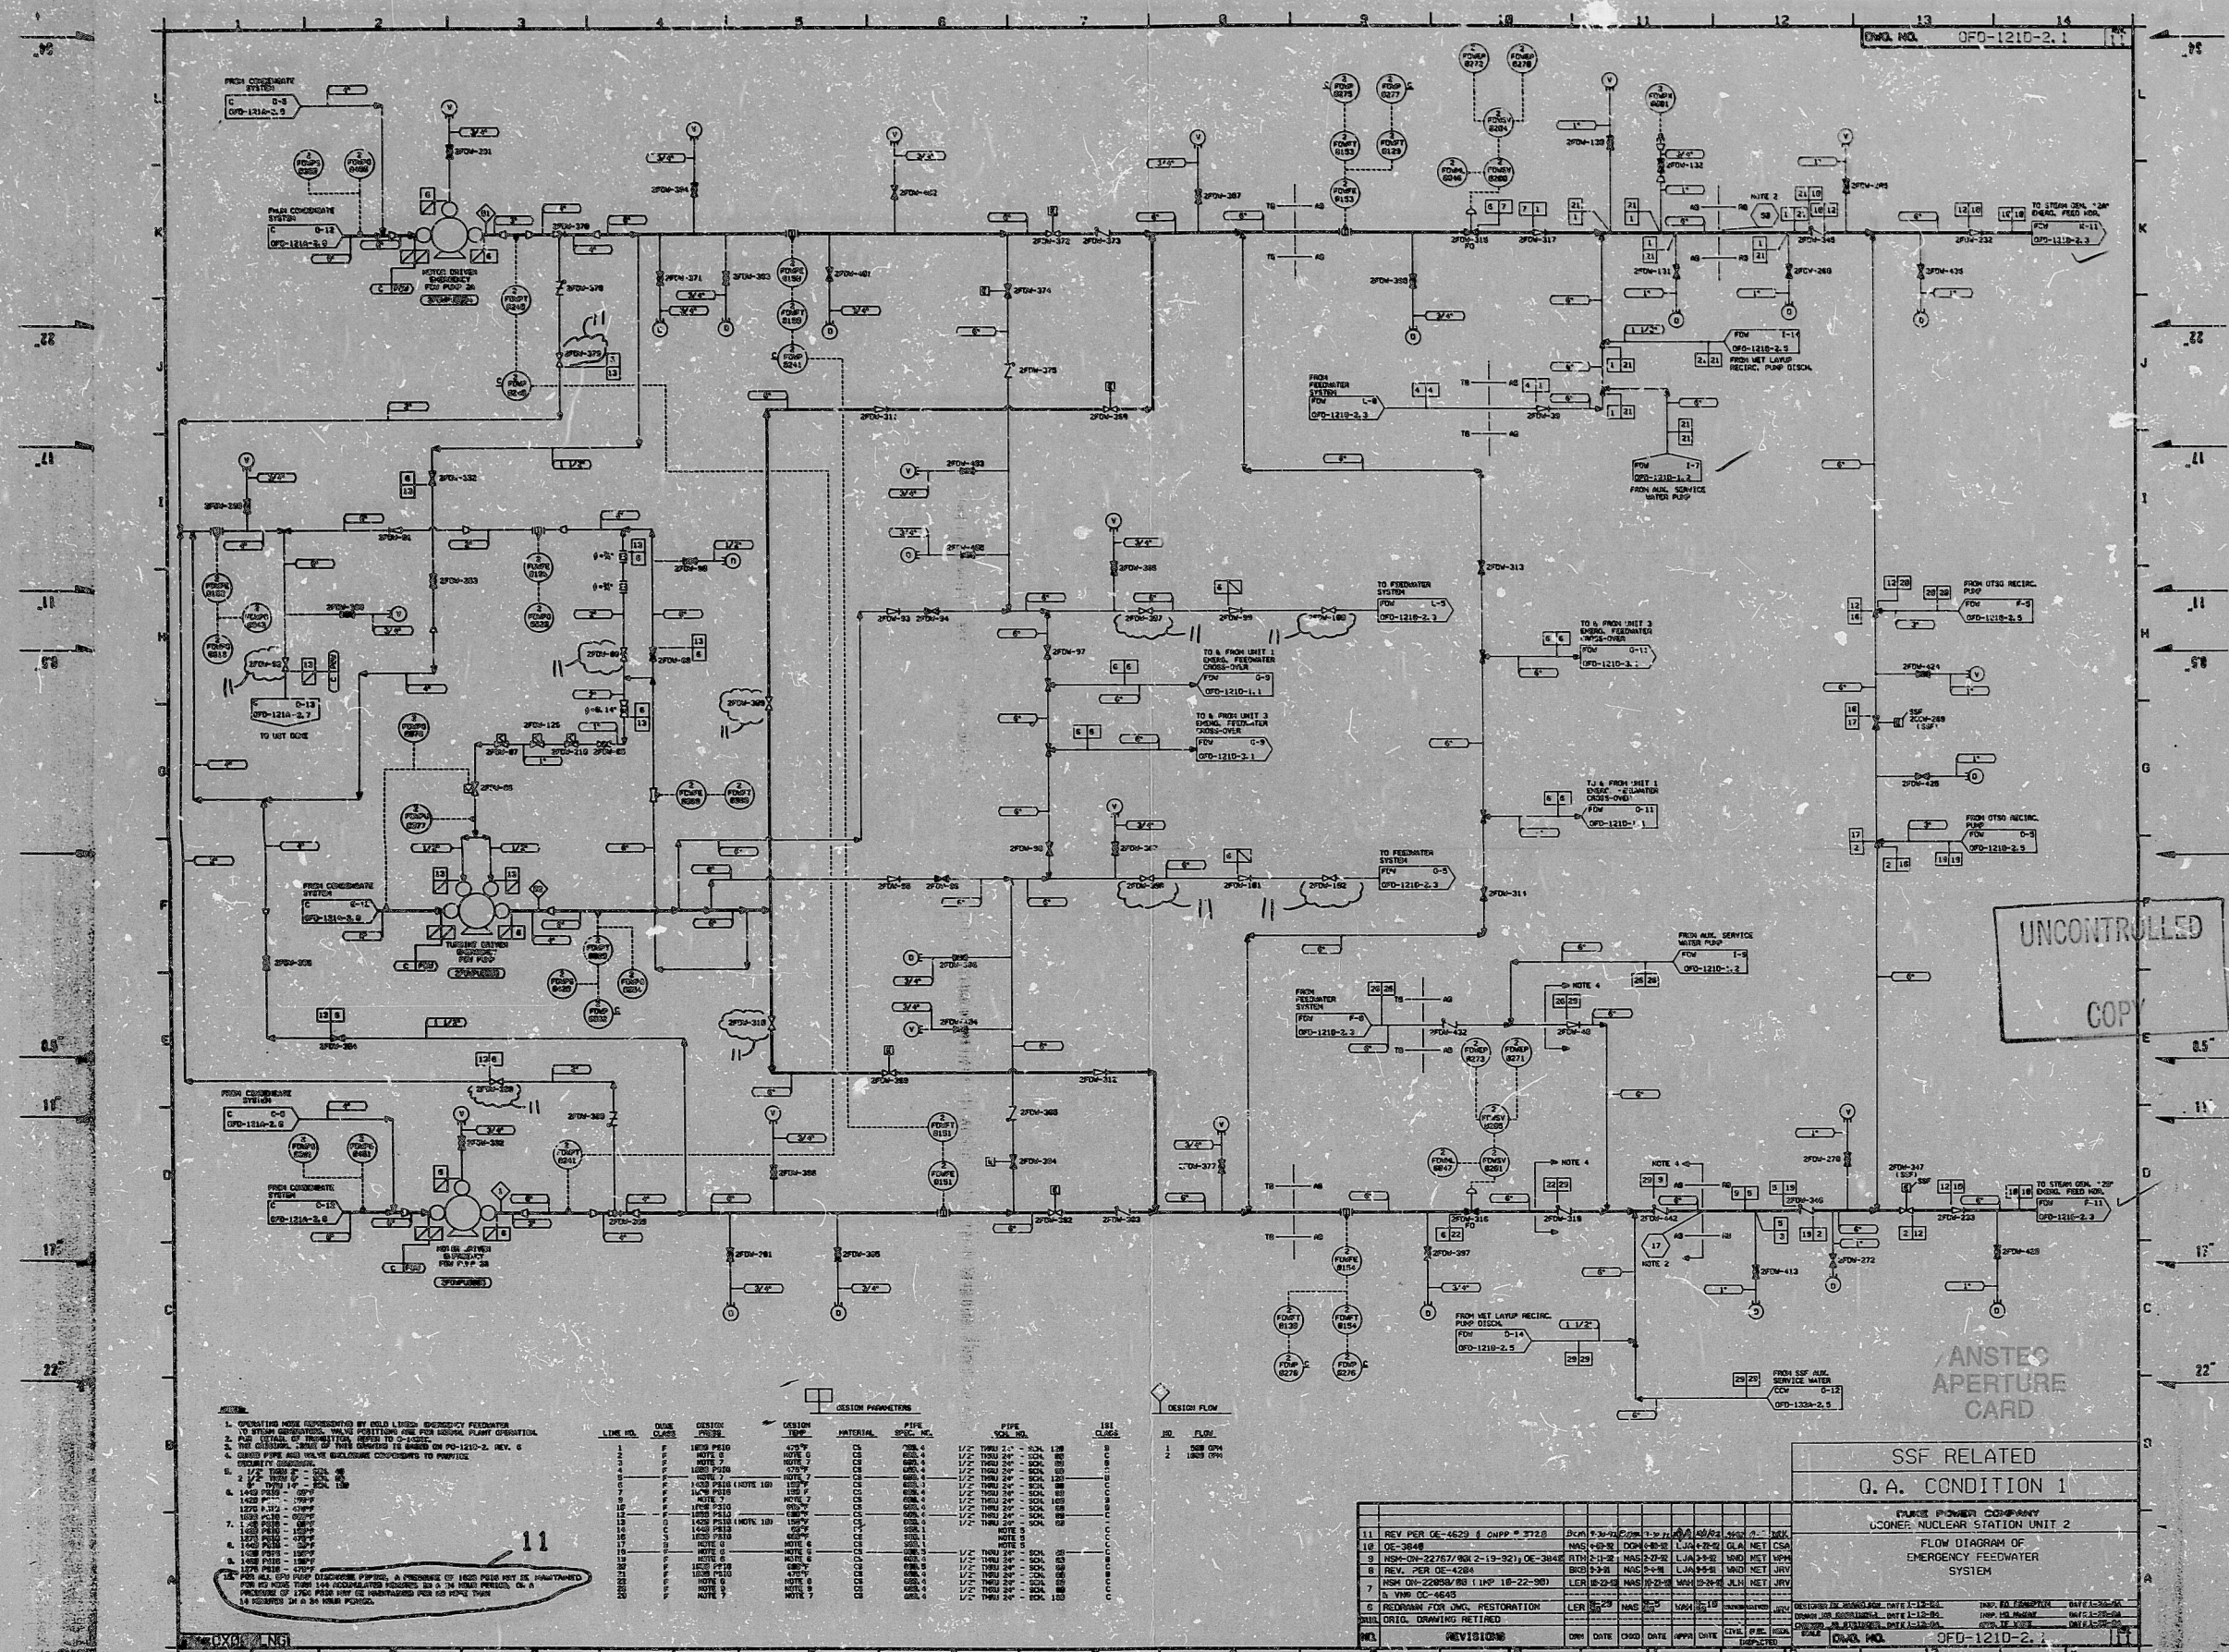

UNCONTROLLED
COPY

ANSTEC
APERTURE
CARD

SSF RELATED
Q. A. CONDITION 1

11										12										13										14									
