


THIS DRAWING AND THE DESIGN IT COVERS IS THE PROPERTY OF THE UTILITIES WHICH ARE PARTICIPATING IN THE SNPPS PROJECT. IT IS LOANED ON THE USER'S EXPRESS AGREEMENT THAT IT WILL NOT BE REPRODUCED, COPIED, LOANED, EXHIBITED, OR USED EXCEPT IN THE LIMITED WAY AND FOR THE LIMITED PURPOSES GIVEN BY THE SNPPS UTILITIES TO THE BROWNER.

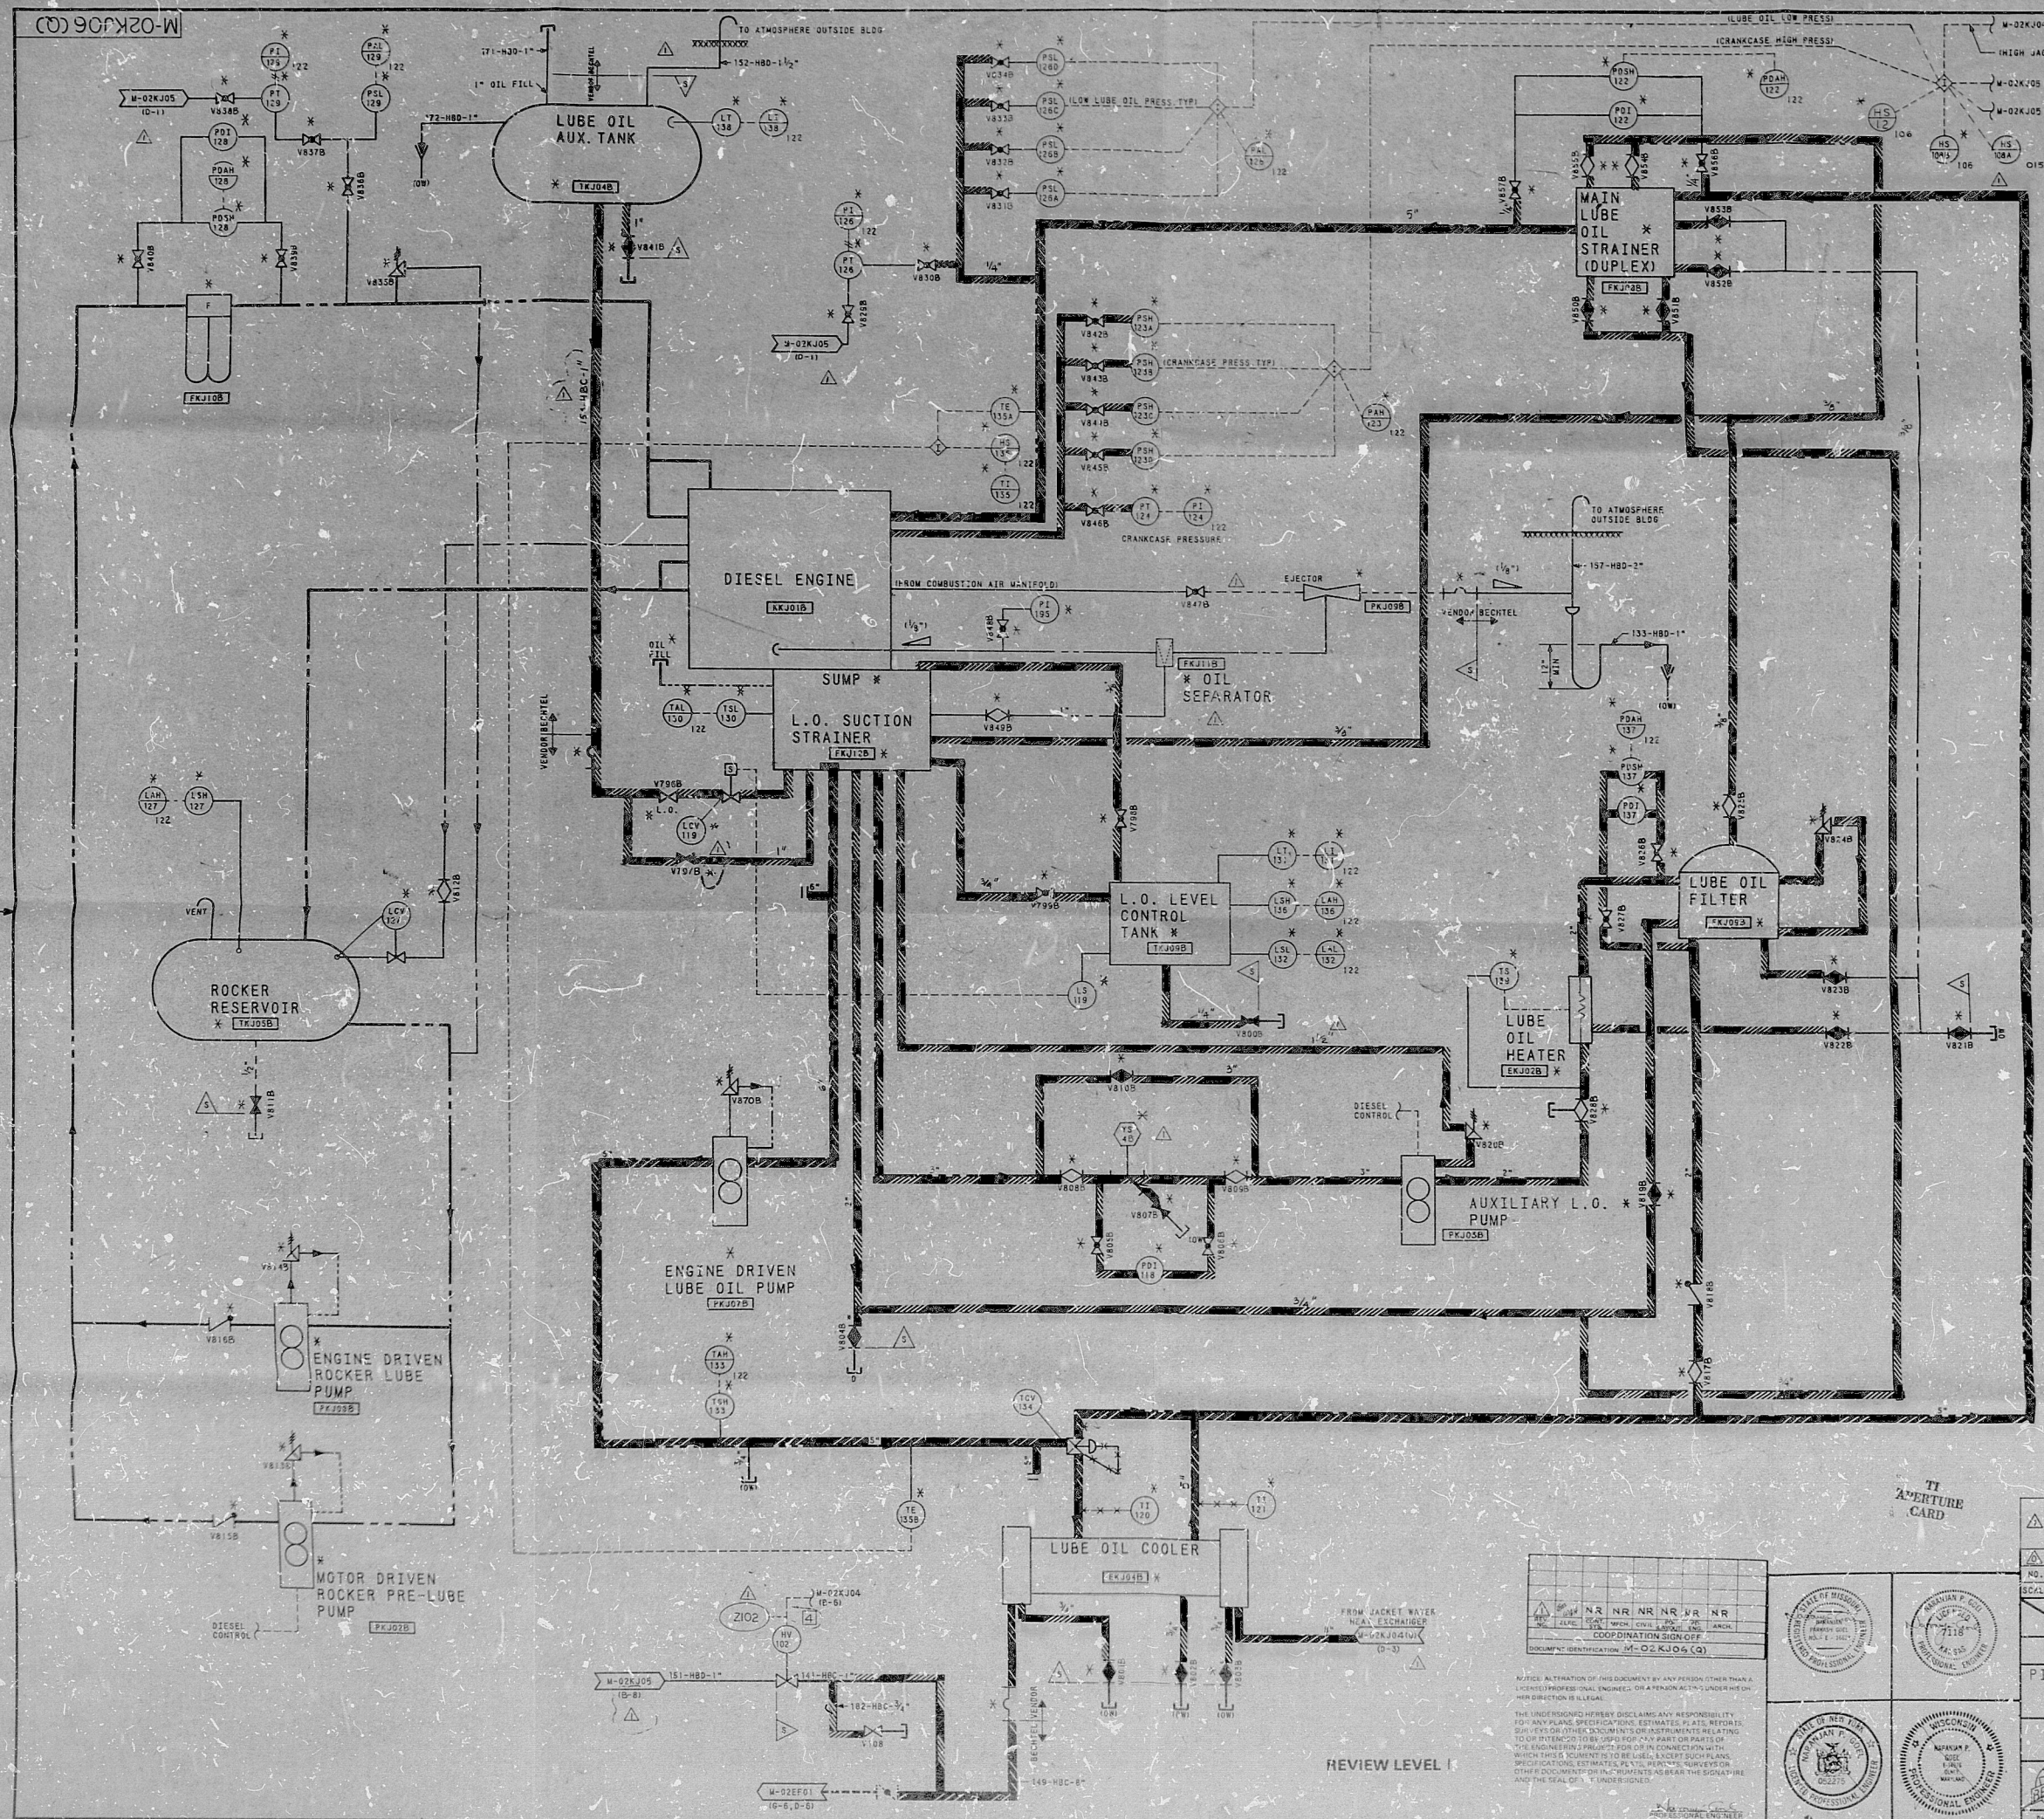

SNPPS NUCLEAR SERVICE PROJECT

FILE: BOUNDARY DIAGRAM

PROJECT NO.: M-02KJ06-151 REV.

BY: [Signature] DATE: 11/15/85 CLASSIFICATION: [Blank]

APP. [Signature] DATE: 11/15/85 GROUP C

NOTES:

- 1. FOR ISI PURPOSES.
- 2. ALL COMPONENTS WITHIN THESE BOUNDARIES REQUIRE A PUMP EXAMINATION DURING A SYSTEM PRESSURE TEST.

3. UPDATED TO REFLECT CHANGES FOR BECHTEL DOWD MC 12-25KAW (2) NOTE: B FOR SIGNAL CLASS 1253 LINES ONLY. OTHER LINES AND BECHTEL NOTES MAY NOT BE ACCURATE.

TI ADVERTISE CARD

REVIEW LEVEL

NO.	DATE	REVISIONS	BY	CHK	APP
1					
2					
3					
4					
5					
6					
7					
8					
9					
10					

BECHTEL

CAITHERSBURG, MARYLAND

SNPPS

PIPING AND INSTRUMENTATION DIAGRAM

STANDBY DIESEL GENERATOR "B"

LUBE OIL SYSTEM

10466 M-02KJ06(Q)

SHOWN APPLICABLE TO UNITS 1 2 3 4 5 6 7 8

PDR RIDS

850801064

