
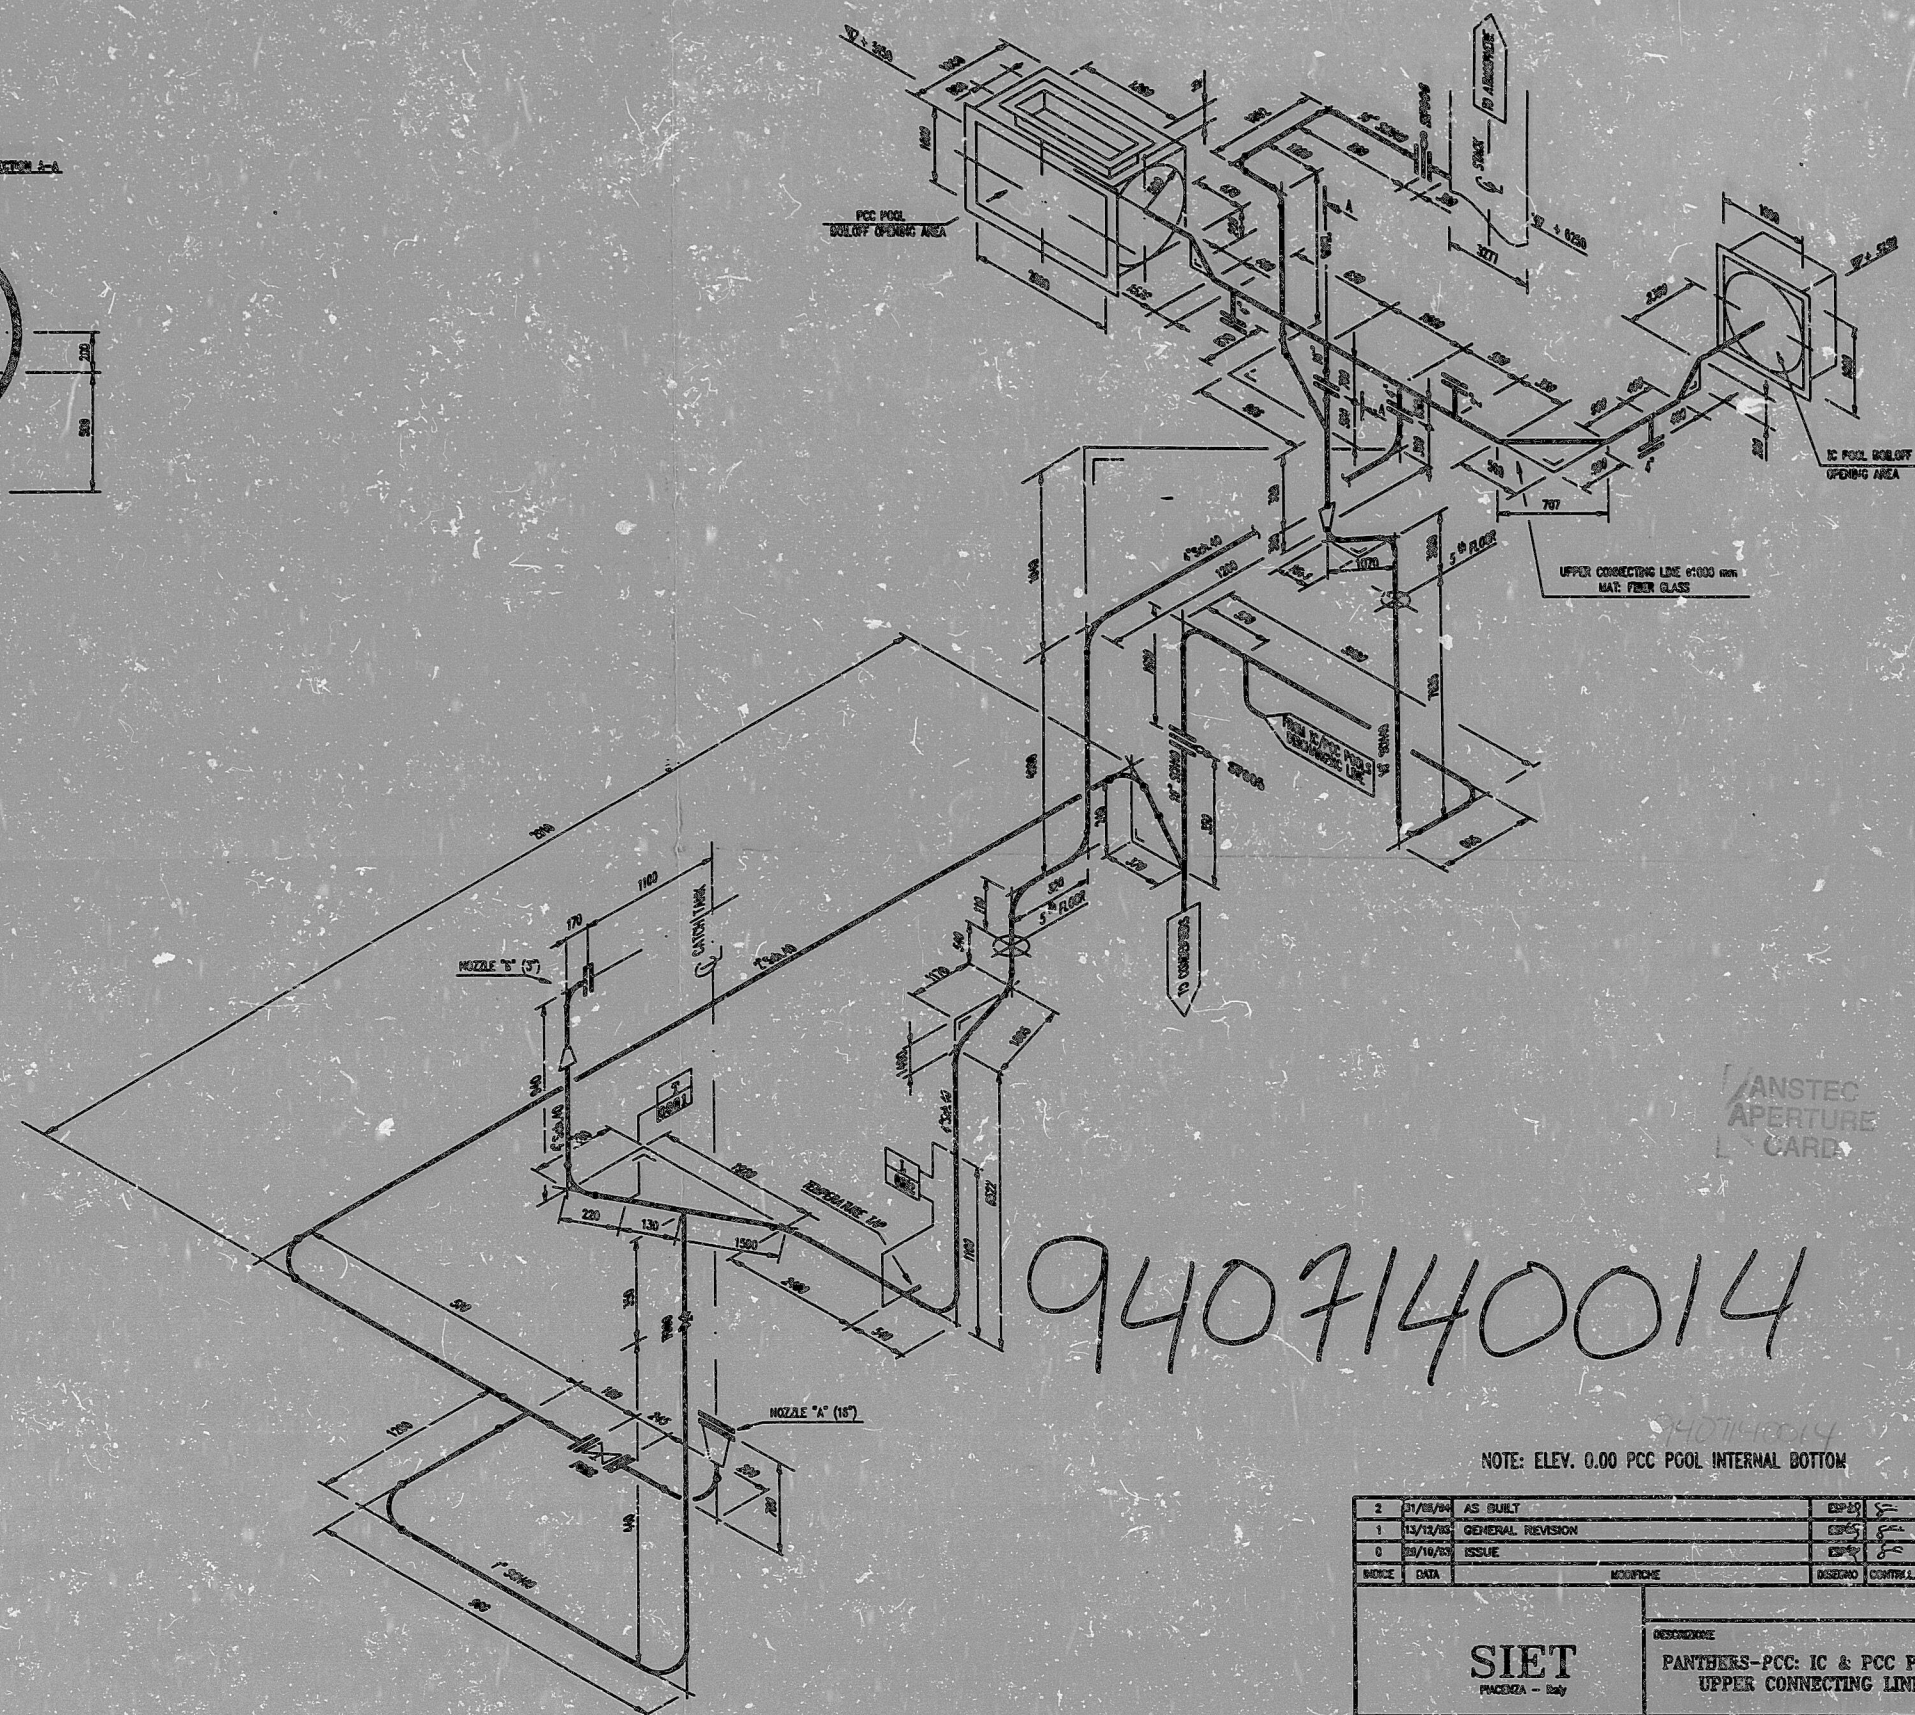


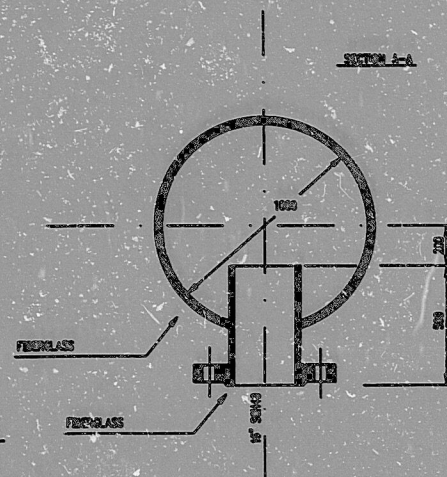

NOTE: ELEV. 0.00 PCC POOL INTERNAL BOTTOM

2	01/03/94	AS BUILT	DESIGN	REVISION
1	15/12/85	GENERAL REVISION	DESIGN	REVISION
0	08/10/83	ISSUE	DESIGN	REVISION
INDEX	DATA	DESCRIPTION	DESIGN	CONTROL
SIET		PANTHERS-PCC: IC & PCC POOLS UPPER CONNECTING LINE		
SCALA	DEGRADO	PCC'D	DI	DEGRADO DA
	N° 24.00.32	1	1	

SCALE - PANTHERS P2

PDR RIDS

9407140014

