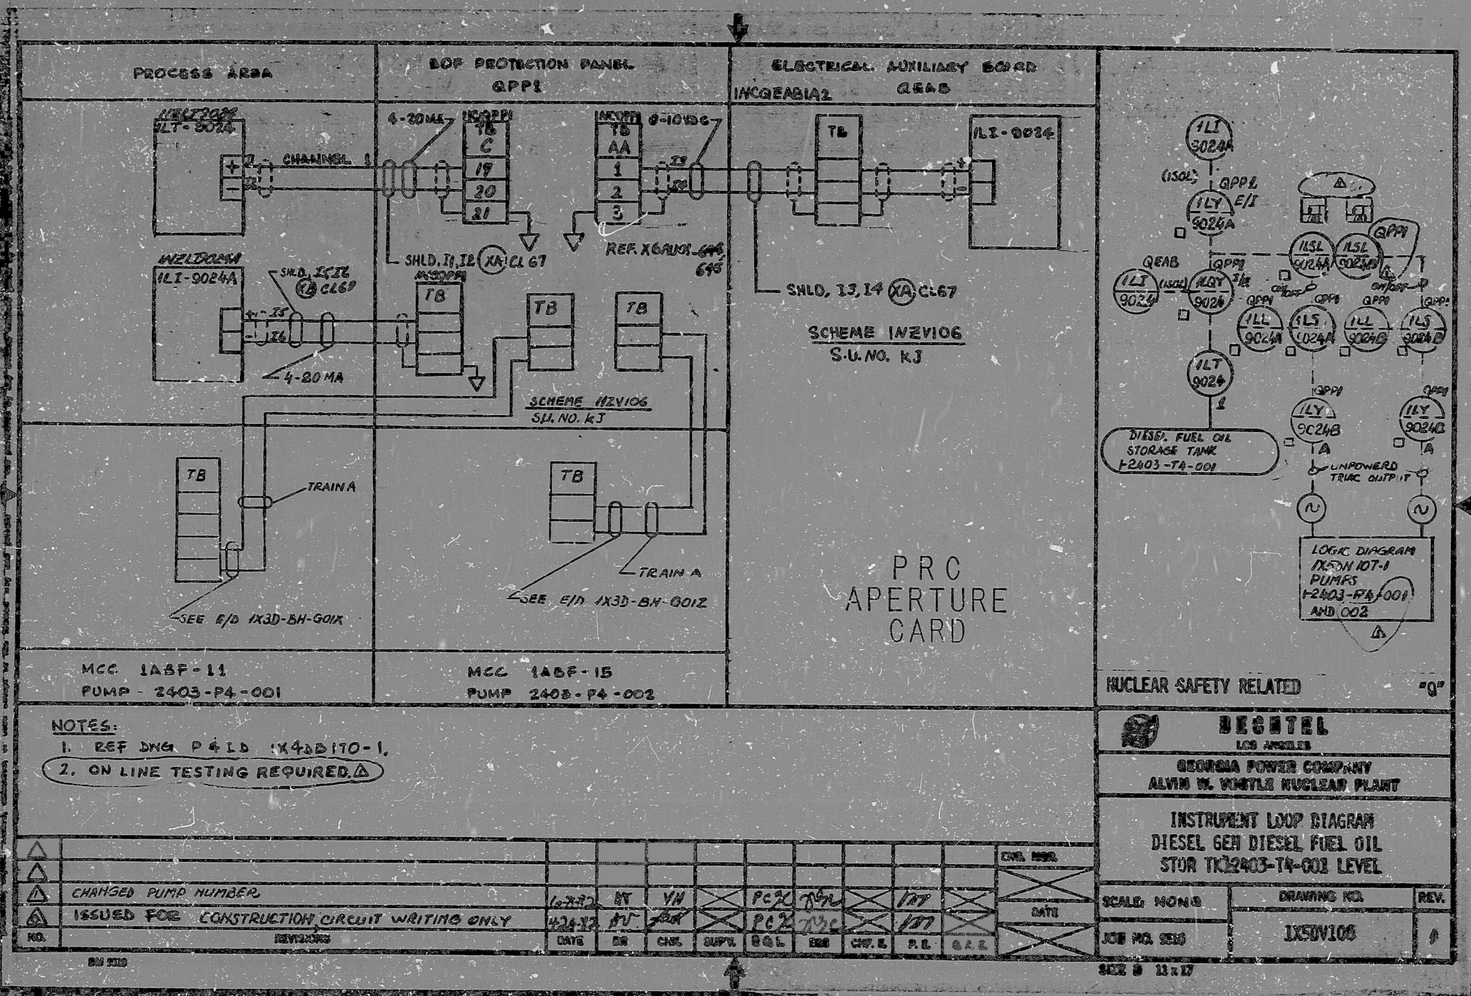
PROCESS AREA
EOF PROTECTION PANEL QPP1
ELECTRICAL AUXILIARY BOARD QEAB
INCGEABIA2
WELDORM 1LT-9024A
4-20 MA
CHANNEL 1
INCQPP1
TB C 19 20 21
INCQPP1
TB AA 1 2 3
0-10 VDC
1LI-9024
SHLD. 11, 12 XA CL 67
REF. X6AN3 646 645
WELDORM 1LI-9024A
SHLD. 13, 14 XA CL67
SCHEME 1NZV106
S.U. NO. KJ
4-20 MA
SCHEME 1NZV106
S.U. NO. KJ
TB
TRAIN A
SEE E/D 1X3D-BH-G01X
TRAIN A
SEE E/D 1X3D-BH-G01Z
MCC 1ABF-11
PUMP - 2403-P4-001
MCC 1ABF-15
PUMP 2403-P4-002
PRC APERTURE CARD
1LI 9024A
(ISOL)
QPP1 E/I
1LY 9024A
QEAB
1LI 9024
1LT 9024
1LL 9024A
1LS 9024A
1LS 9024B
1LL 9024B
1LS 9024C
1LS 9024D
DIESEL FUEL OIL STORAGE TANK 2403-TA-001
UNPOWERED TRIAC OUTPUT
LOGIC DIAGRAM 1X4DW107-1 PUMPS 2403-P4-001 AND 002
NUCLEAR SAFETY RELATED
"Q"
BECHTEL
LOS ANGELES
GEORGIA POWER COMPANY
ALVIN W. VOGTLE NUCLEAR PLANT
INSTRUMENT LOOP DIAGRAM
DIESEL GEN DIESEL FUEL OIL
STOR TK 2403-T4-001 LEVEL
SCALE: NONE
DRAWING NO.
1X5DV106
REV.
JOB NO. 9515
SIZE D 11 x 17
NOTES:
1. REF DWG P&ID 1X4DB170-1.
2. ON LINE TESTING REQUIRED. △
△ CHANGED PUMP NUMBER
△ ISSUED FOR CONSTRUCTION, CIRCUIT WIRING ONLY
NO. REVISIONS
DATE
BY
CHK.
SUPVR.
ENG. MGR.
DATE

RIDS

8309230143

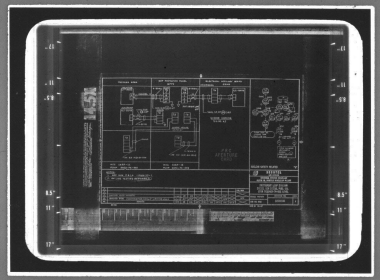

MMM 5824 — FILMSORT® Brand Aperture & Camera Cards and DUPLICARD® Brand Copy Cards — Product of 3M Company, St. Paul, Minn.