


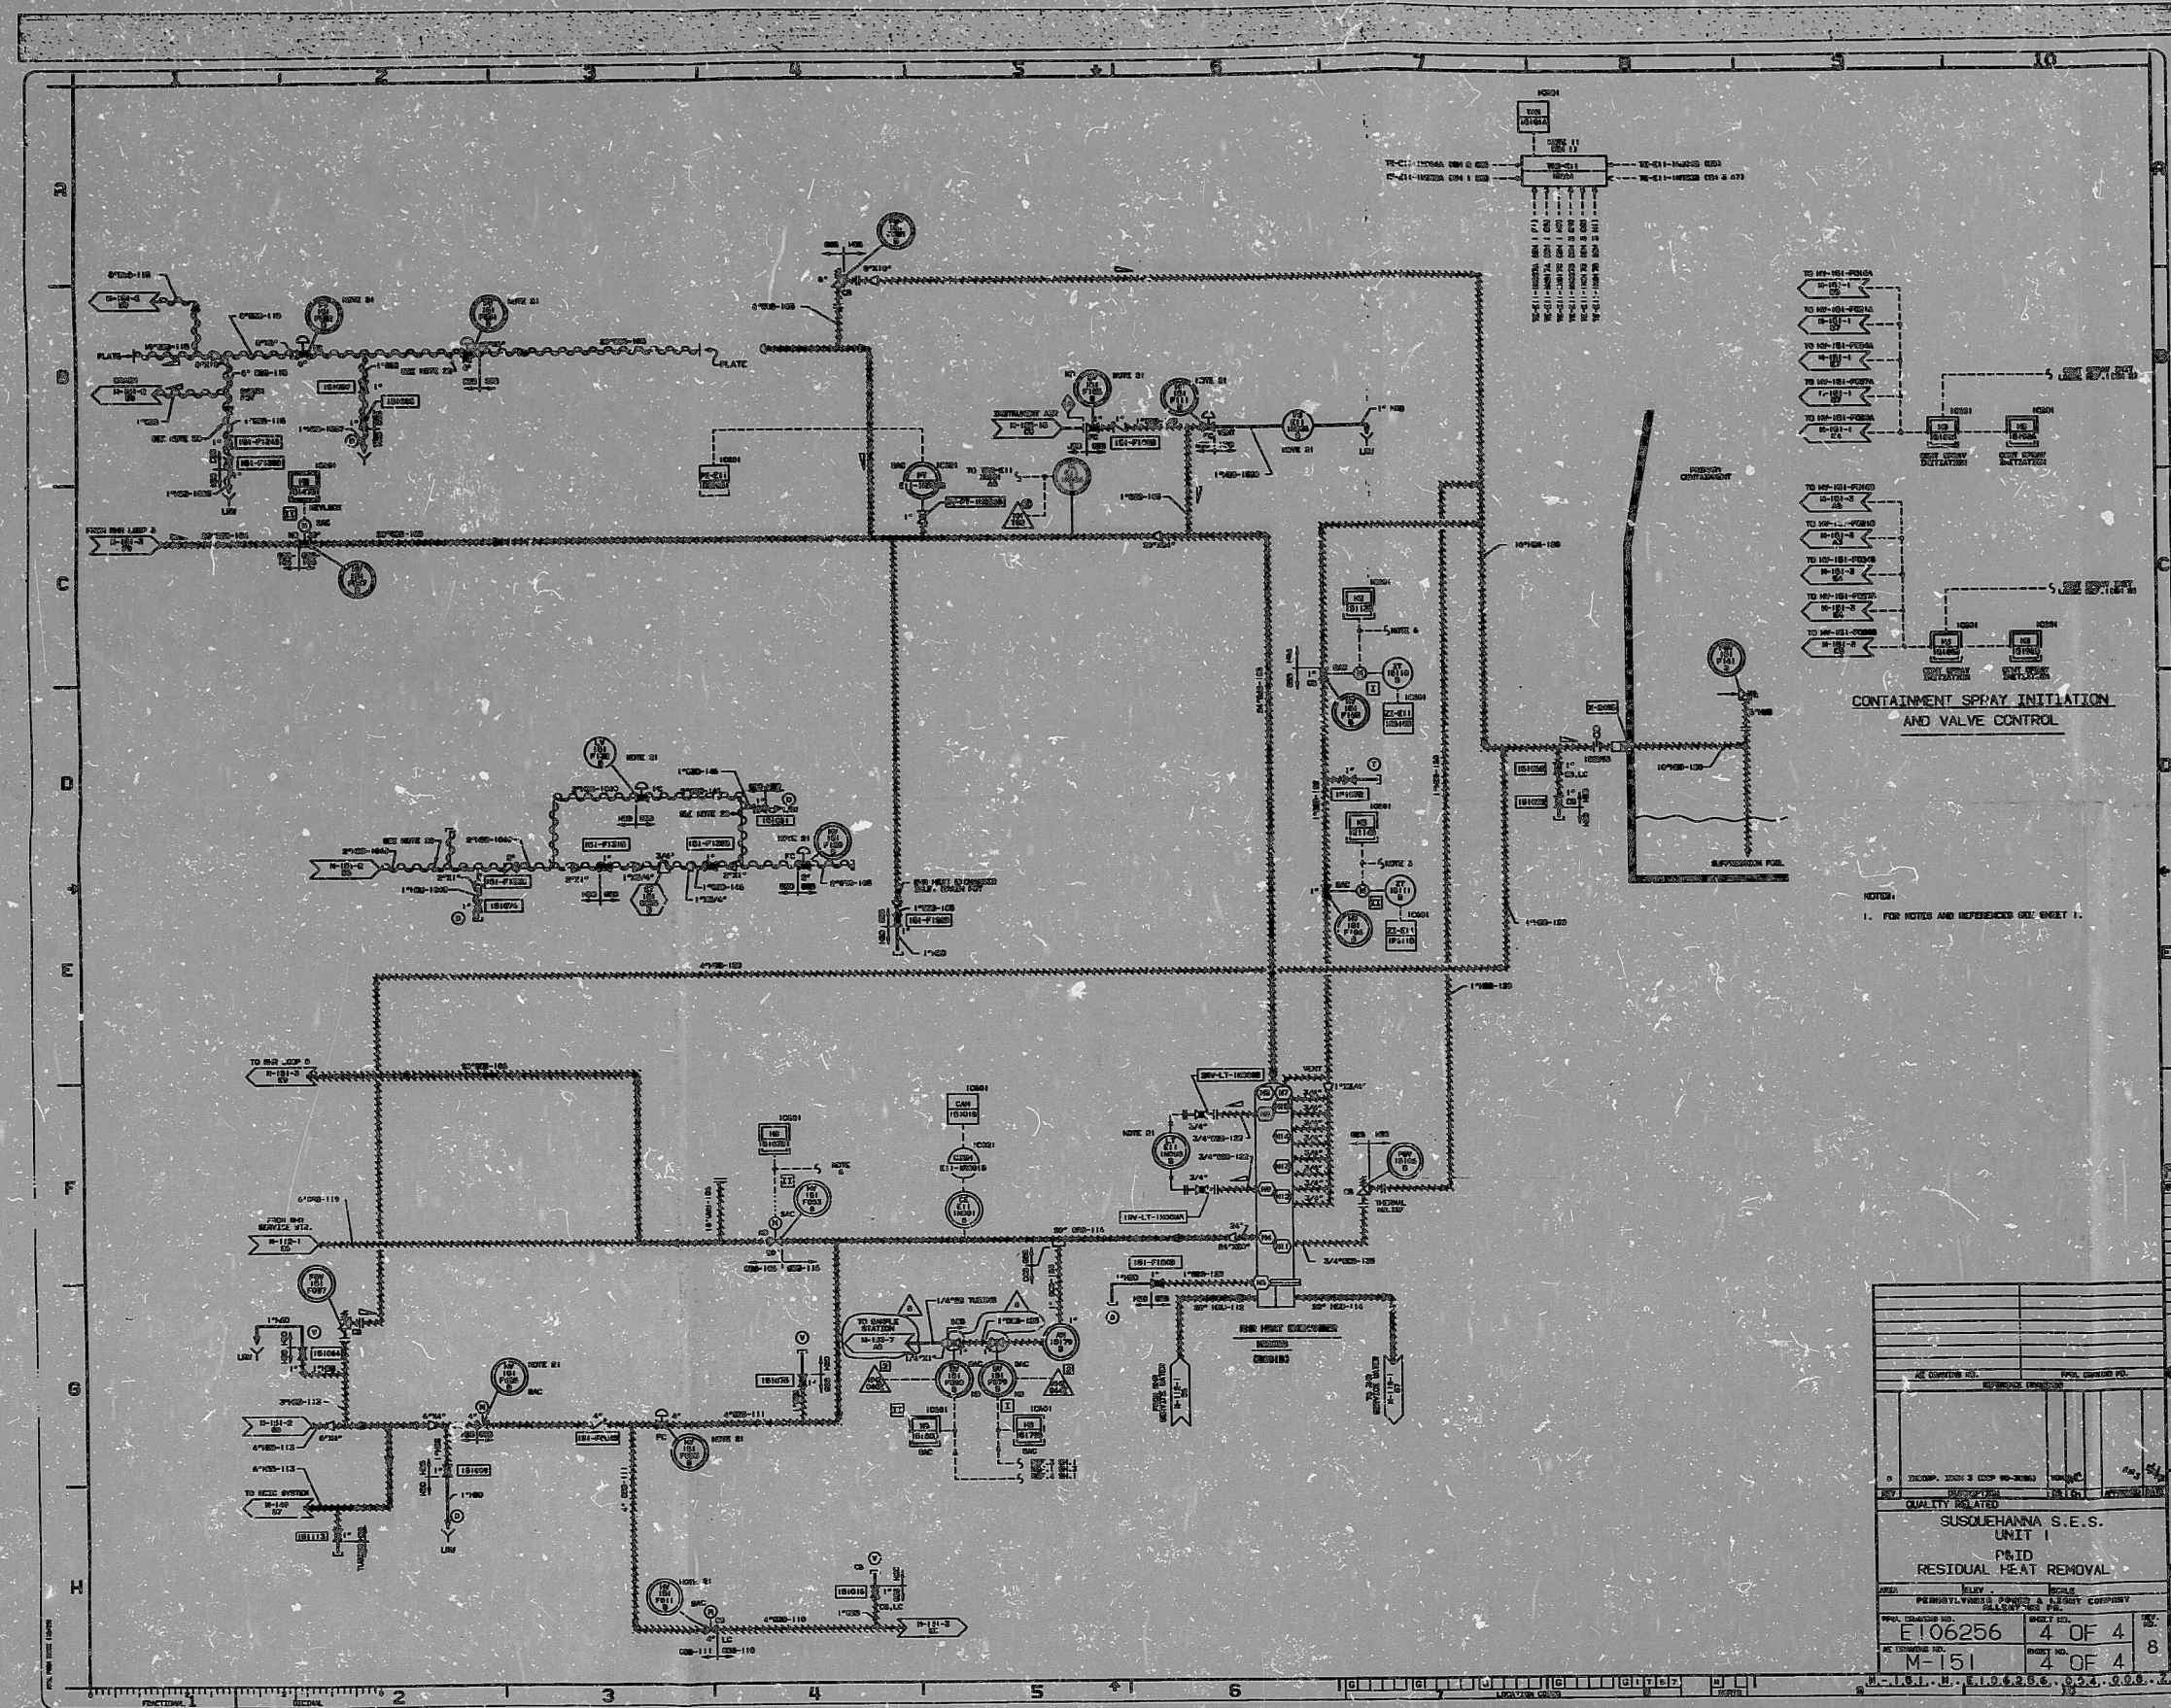

"Hot" Pipe
"B" Loop RHR
DBA LOCA or 1.3 LOCA

EC-RADN-1008
AT 2
P. 70 of 105

ANSTEC
APERTURE
CARD

9407290408

PDR RIDS

