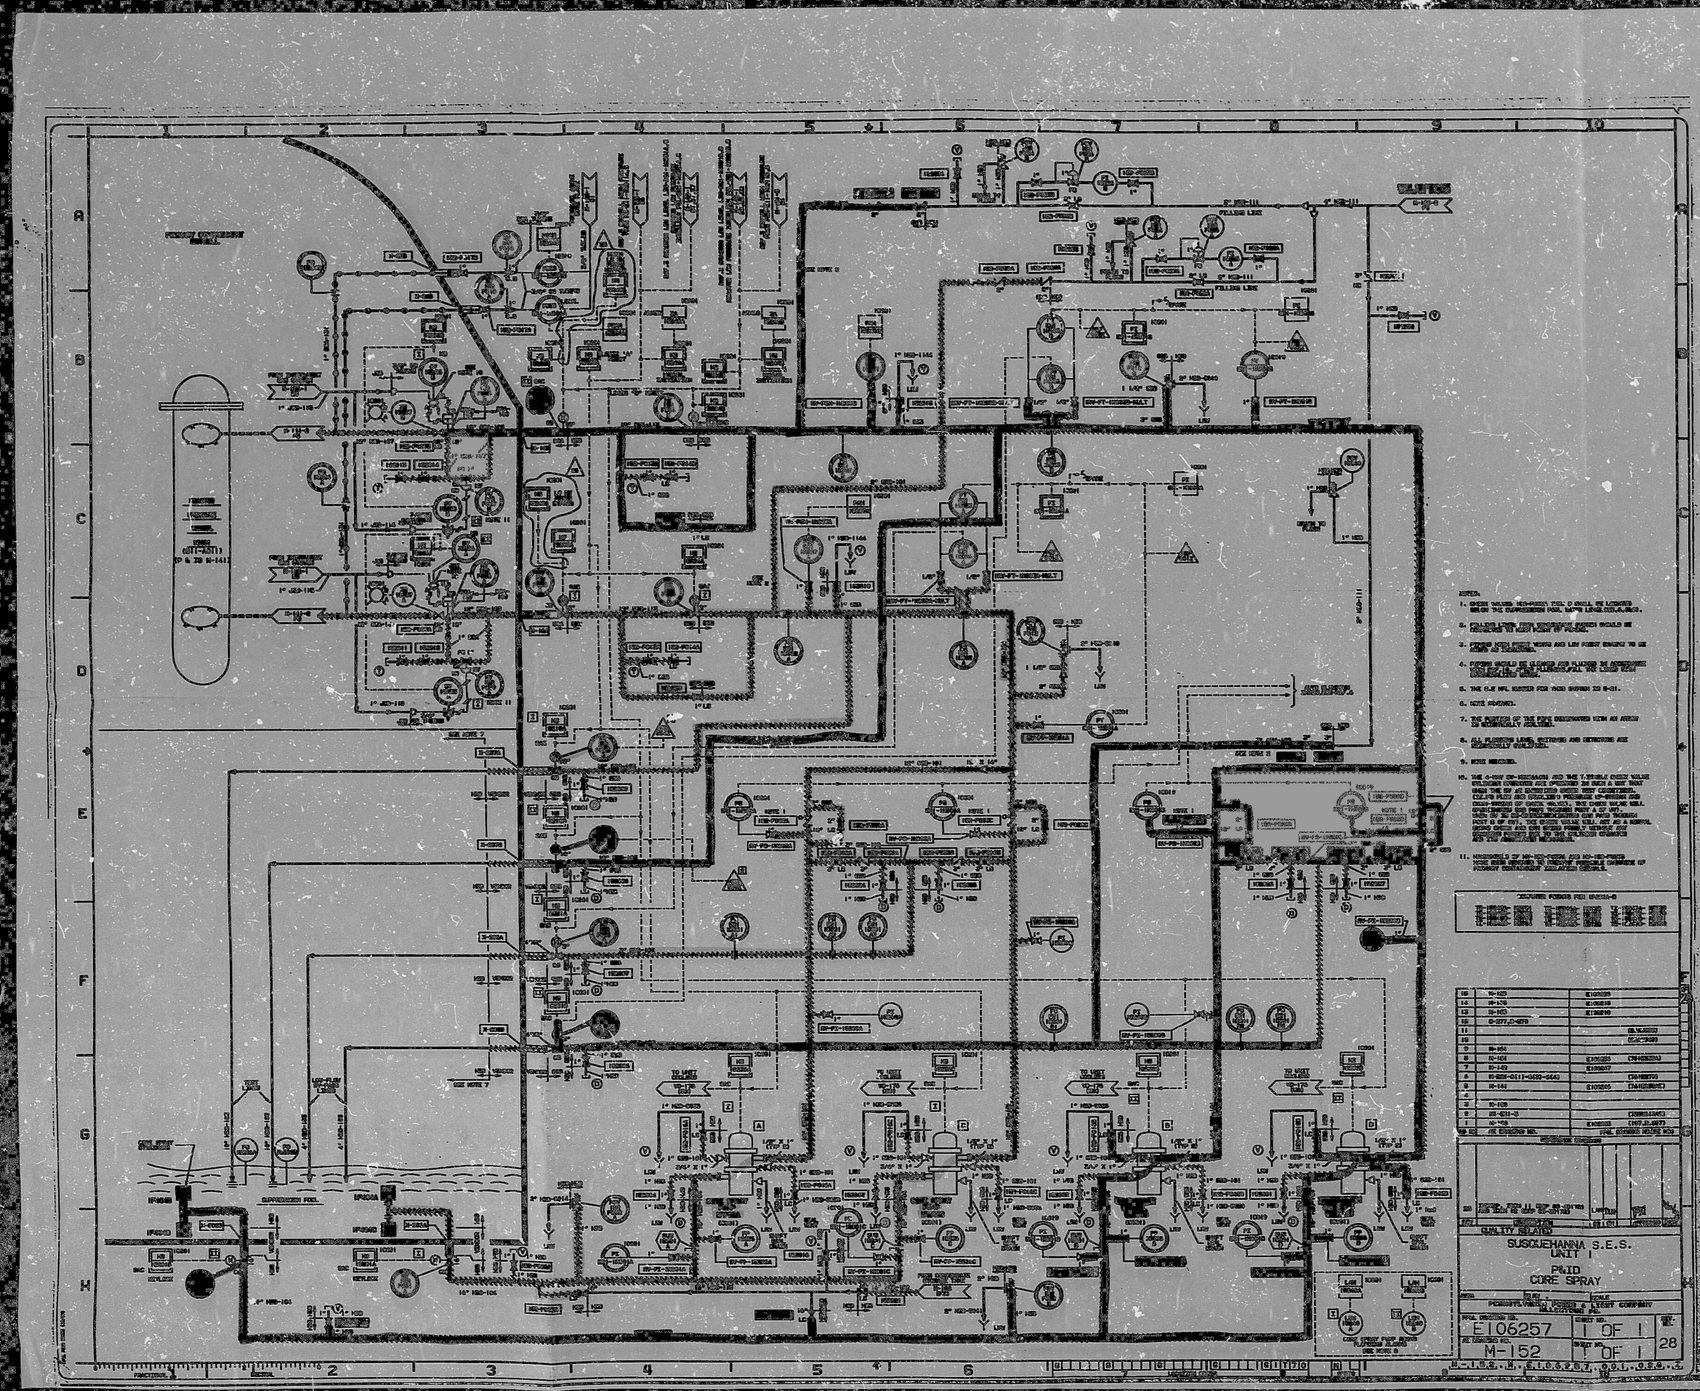

For DBA LOCA
2 Loops for 10 min. then
1 Loop Long term

"A" Loop "Hot" Pipe
for DBA LOCA
"B" Loop "Hot" Pipe
for DBA LOCA

No Core Spray
for
Reg. Guide 1.3 LOCA

ANSTED
APERTURE
CARD

EC- RADN-1003
ATT 2
p.71 of 185

9408010019

PDR RIDS

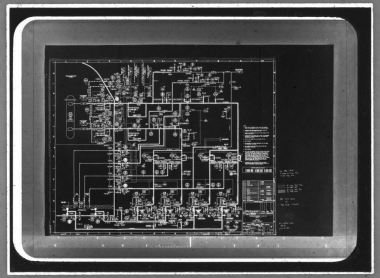

MMM 5824 · FILMSORT® & DUPLICARD® Cards

3M St. Paul, MN