


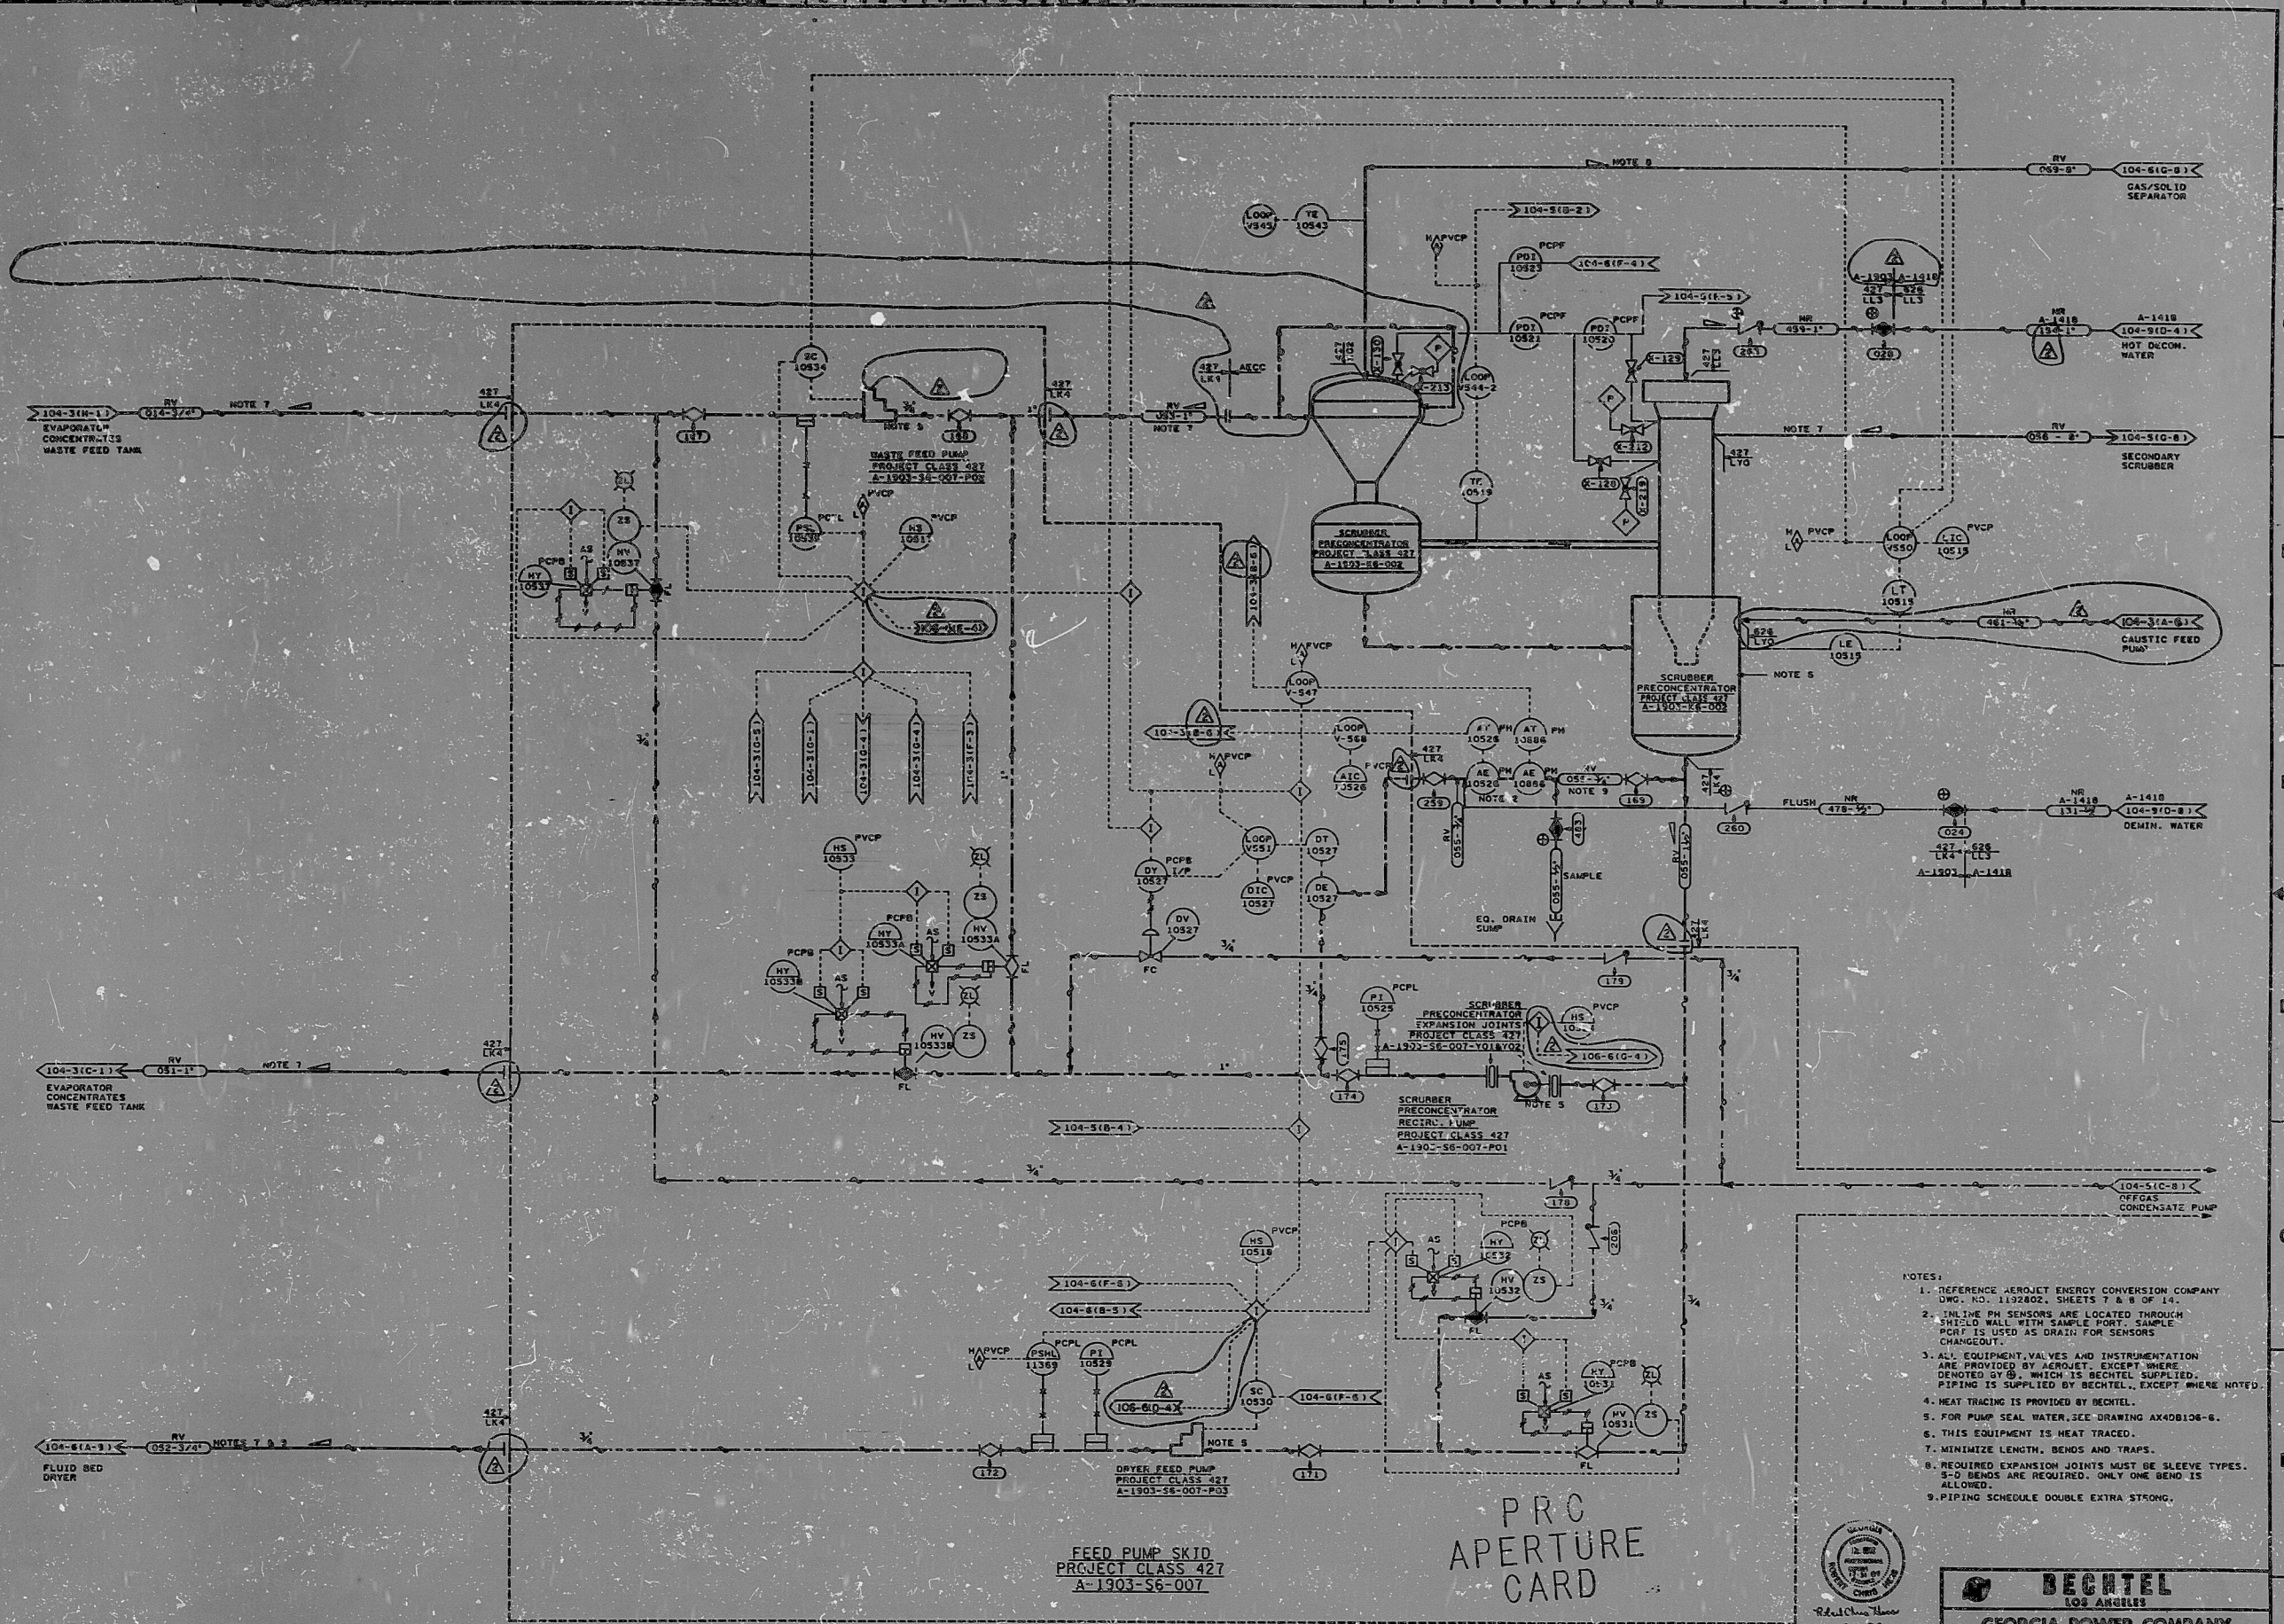

BECHTEL
LOS ANGELES

GEORGIA POWER COMPANY
ALVIN W. VOGLE NUCLEAR PLANT

P & ID DIAGRAM
RADIATION SOLIDIFICATION AND VOLUME
REDUCTION SYSTEM - SYSTEM NO. 1903
(WASTE FEED AND SCRUBBER)

AX408104-4

2

REV	DESCRIPTION	DATE	BY	CHKD	APP'D	REVISIONS

RIDS

6309230189

