


This drawing and the design it covers is the property of the utilities which are participating in the SNUPPS Project. It is loaned on the borrower's express agreement that it will not be reproduced, copied, loaned, exhibited, or used except in the limited way and private use permitted by written consent given by the SNUPPS utilities to the borrower.

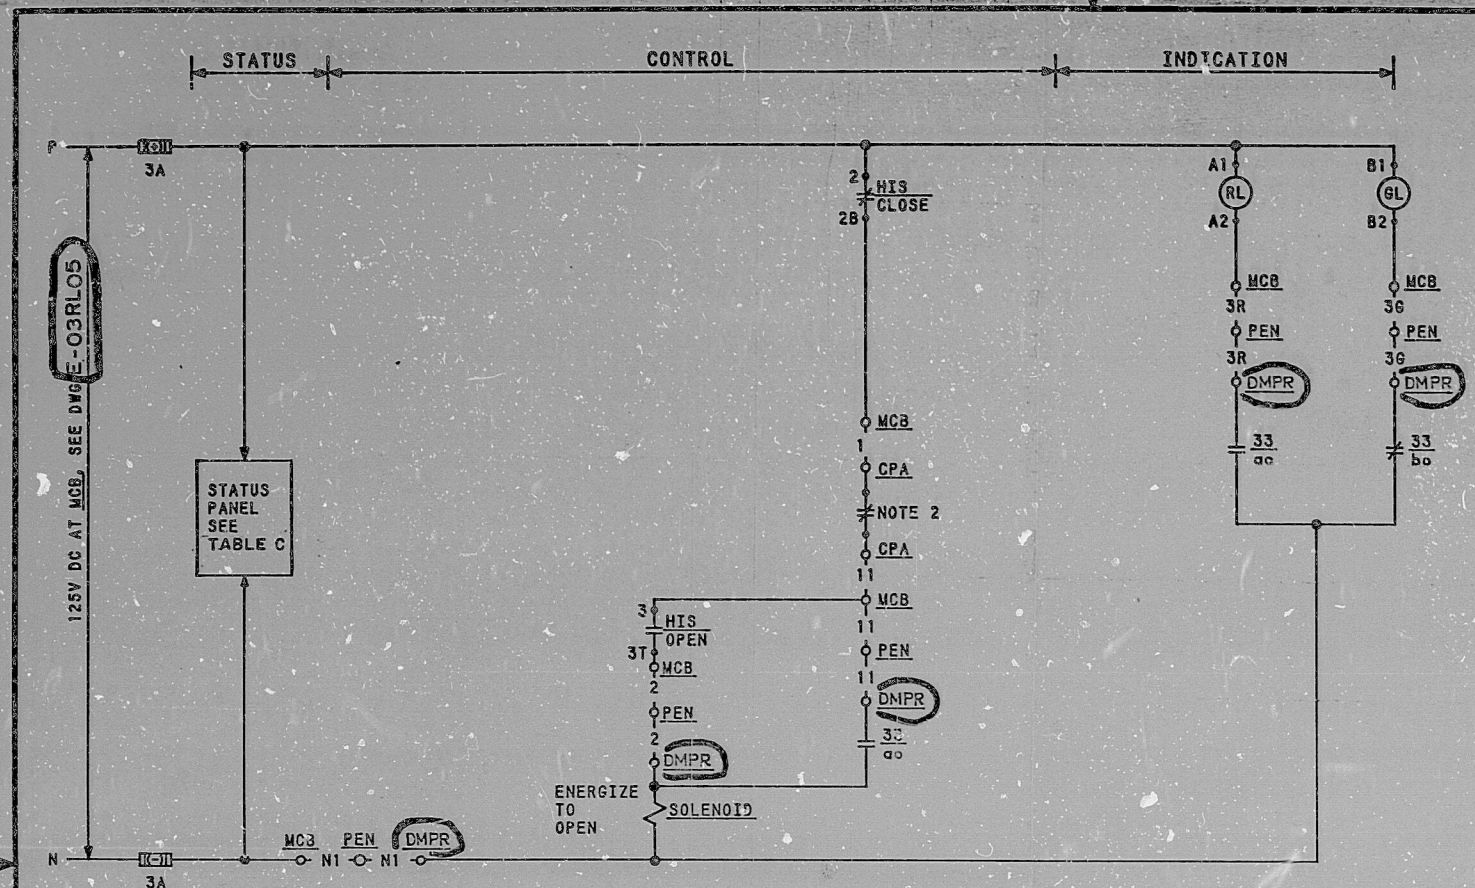

OPEN		POSITION		
GL	RL	MORM	CLOSE	OPEN
CLOSE		1-11-1T	X	X
		3-11-3T		X
		2-11-2B	X	X
		4-11-4B		X

CUTLER-HAMMER
TYPE E30 JY9
WITH TWO KLA3
CONTACT BLOCKS

HAND INDICATING SWITCH
HIS-SEE TABLE
MOMENTARY CONTACT

DEVICE 33 POSITION SWITCHES			
CONTACT	DAMPER POSITION		FUNCTION
	CLOSED	OPEN	
1			RED LIGHT
2			NOTE 3
3			SPARE
4			COMPUTER
5			SEAL IN CKT
6			GREEN LIGHT
7			NOTE 4
8			SPARE

SOLID BAR INDICATES CONTACT CLOSED
(2) NAMCO EA 18032302 LIMIT SWITCHES


REFERENCE DWGS:
M-026T01
J-026T03

- CONTACT USED TO INTLK WITH GTRV33A # B. REFER TO DWG. E-026T13 (Q). THIS ONLY APPLIES TO DMPR GTHZ8. CONTACT IS SPARE FOR GTHZ 5, 7, 11.
- TO STATUS PANEL, SEE DWG. E-03SA14.
- CONTACT OPENS ON CONTAINMENT PURGE ISOLATION SIGNAL SEE BECHTEL V.P. NO. J-104-0034 & J-104-0042.
- DAMPER SHOWN IN FULL CLOSED POSITION.

NOTES:

NO.	DATE	REVISIONS	BY	CHK	DESIGN	ENGR	PROJ	DRW
TERA
APERTURE
CARD

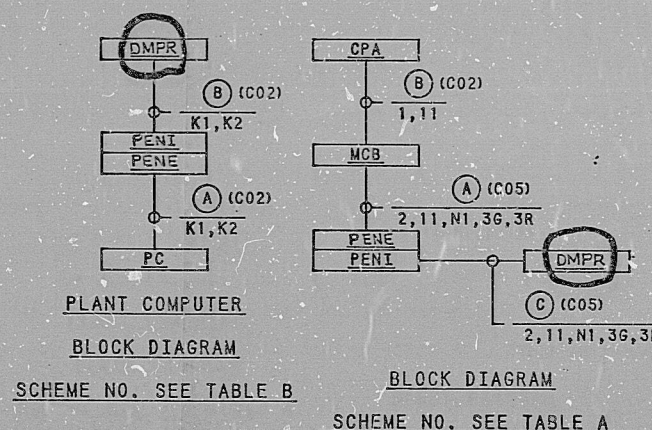

REVIEW LEVEL 3

RIDS-PDR

8104130444

