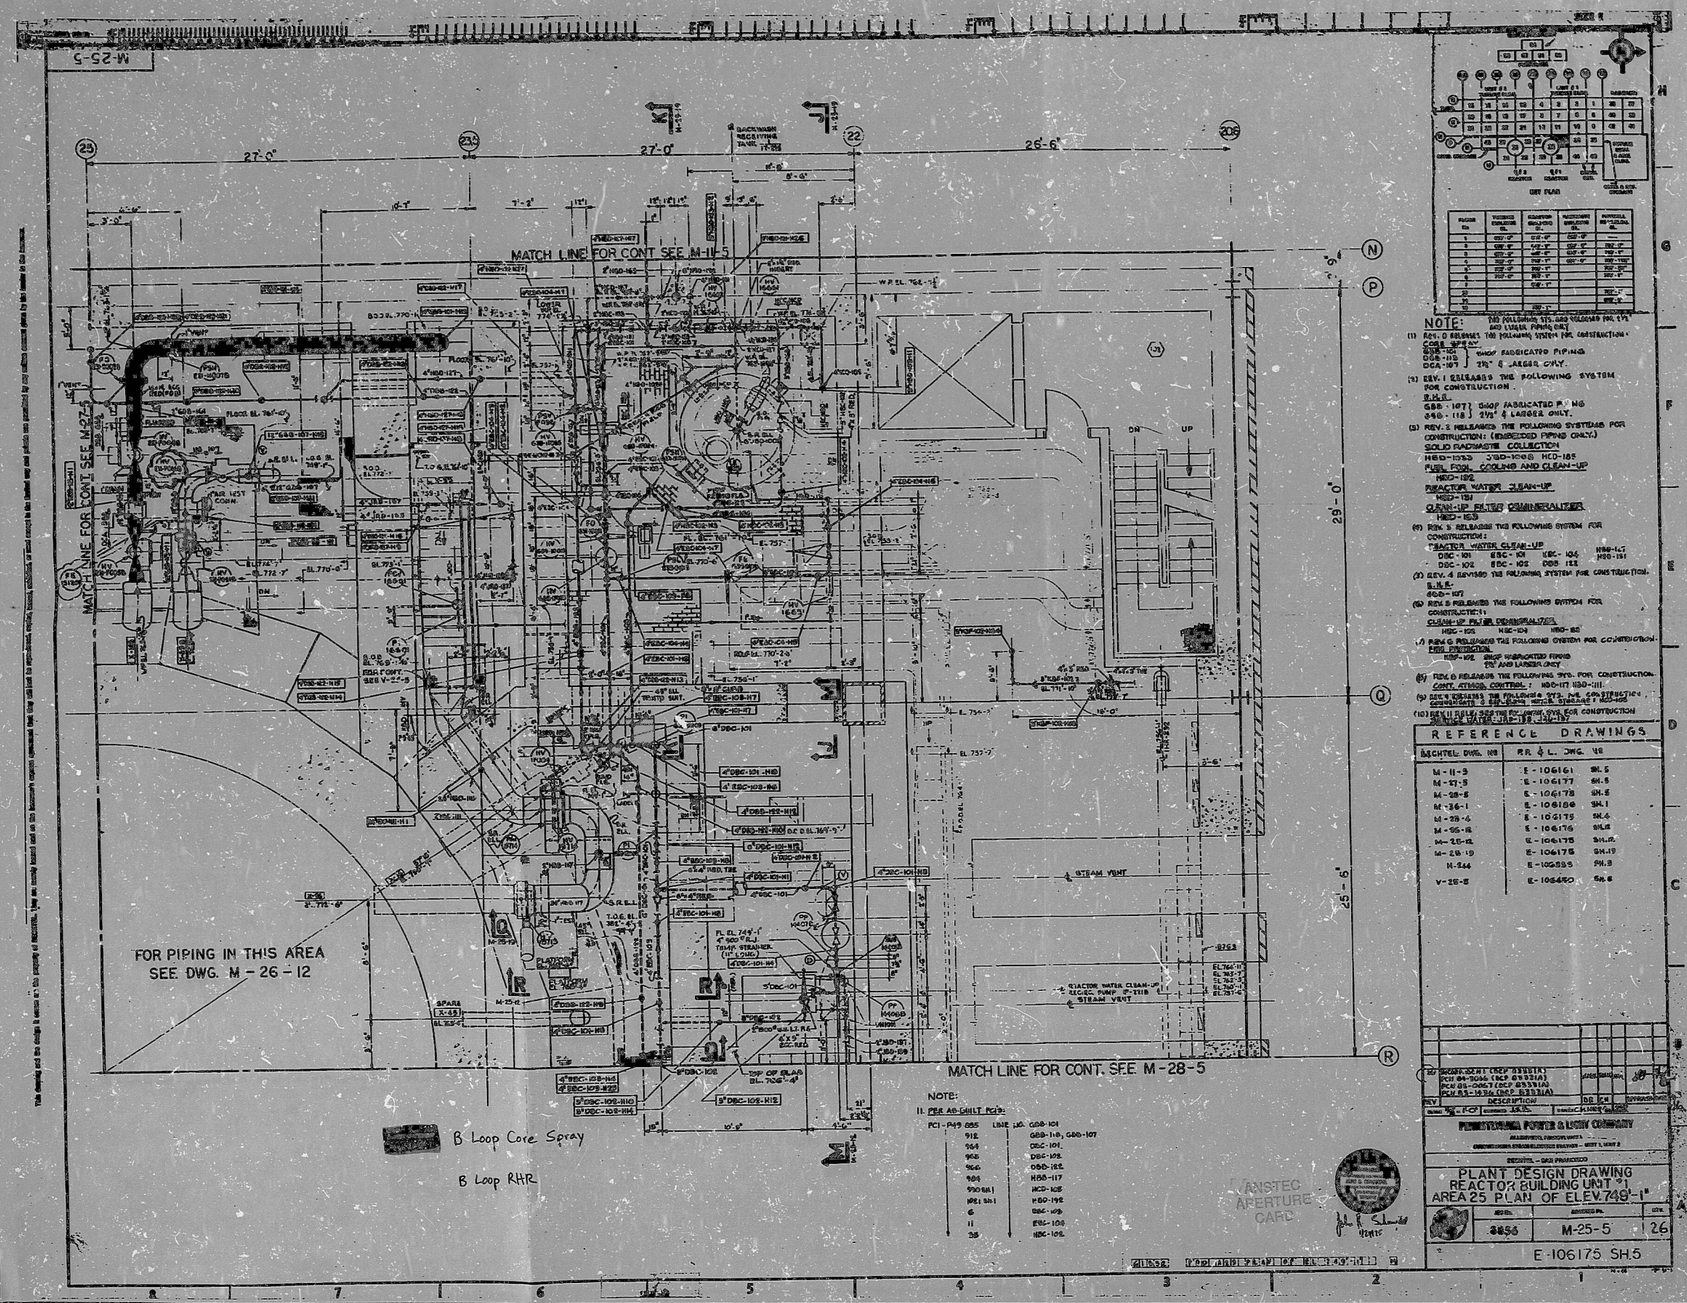
M-25-5
MATCH LINE FOR CONT SEE M-11-5
MATCH LINE FOR CONT SEE M-27-5
MATCH LINE FOR CONT. SEE M-28-5
FOR PIPING IN THIS AREA SEE DWG. M-26-12
STEAM VENT
REACTOR WATER CLEAN-UP RECIRC. PUMP
B Loop Core Spray
B Loop RHR
NOTE:
REFERENCE DRAWINGS
PENNSYLVANIA POWER & LIGHT COMPANY
PLANT DESIGN DRAWING
REACTOR BUILDING UNIT #1
AREA 25 PLAN OF ELEV. 749'-1"
M-25-5
E-106175 SH.5
EC-RADN-1008
ATT 3
p.77 of 185

9408010035

PDR RIDS

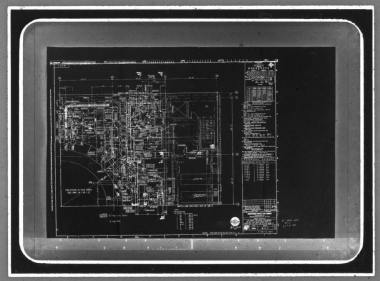

MMM 5824 · FILMSORT® & DUPLICARD® Cards 3M St. Paul, MN