


M-27-2

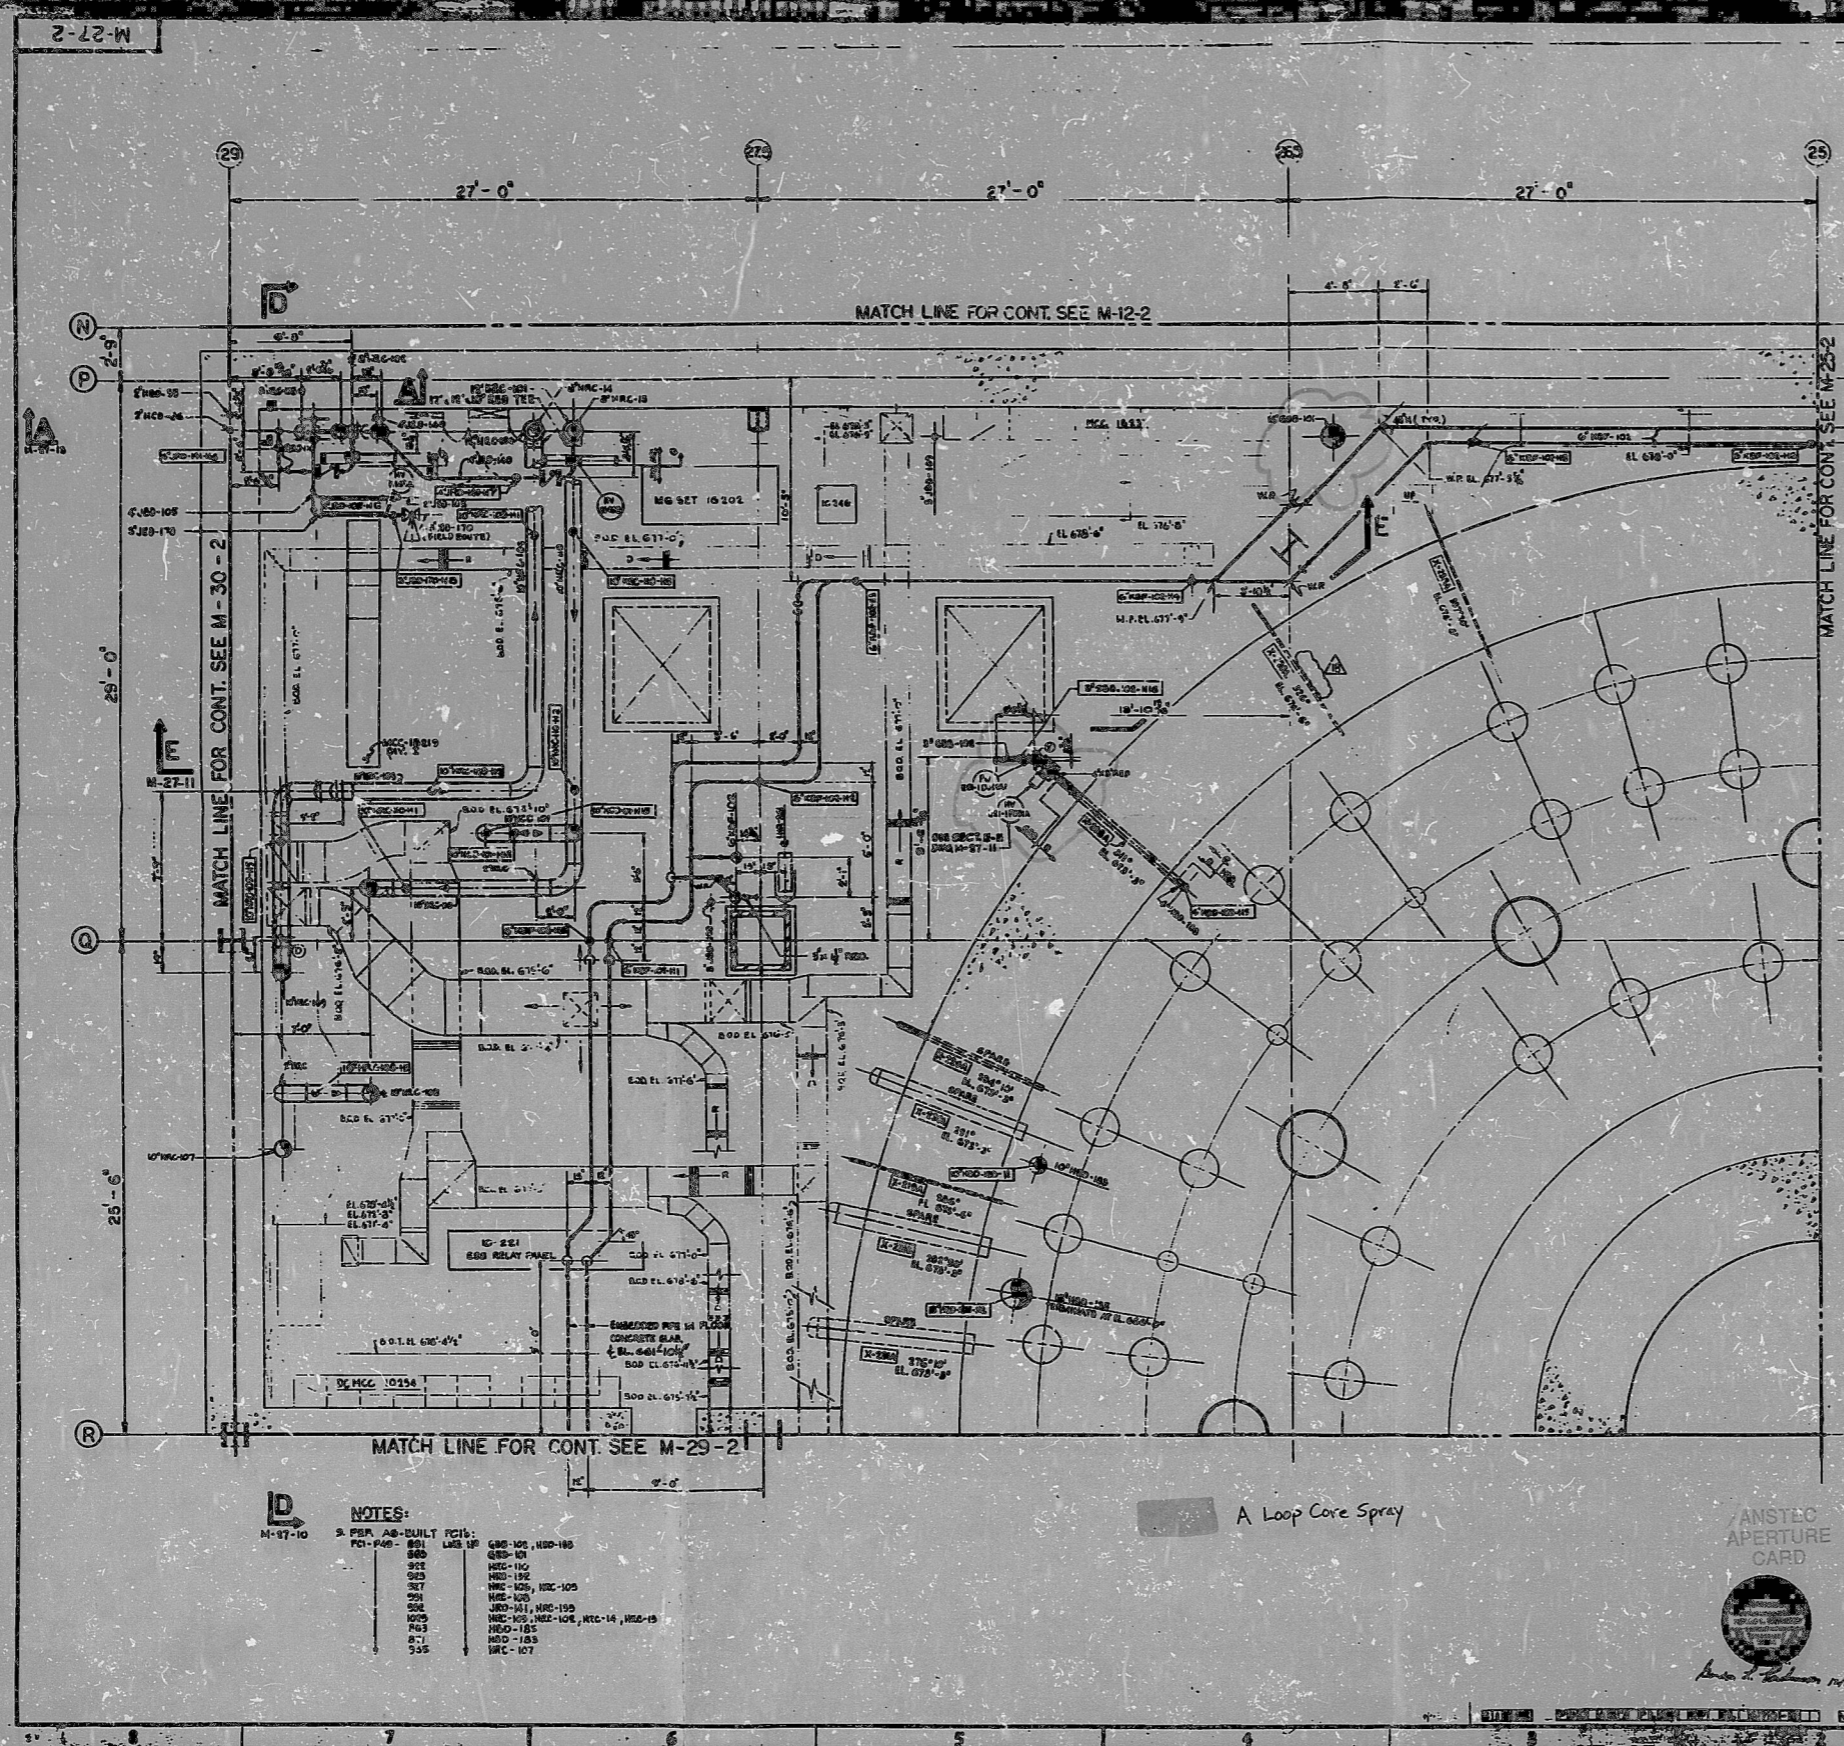



























9408010048

PDR RIDS

