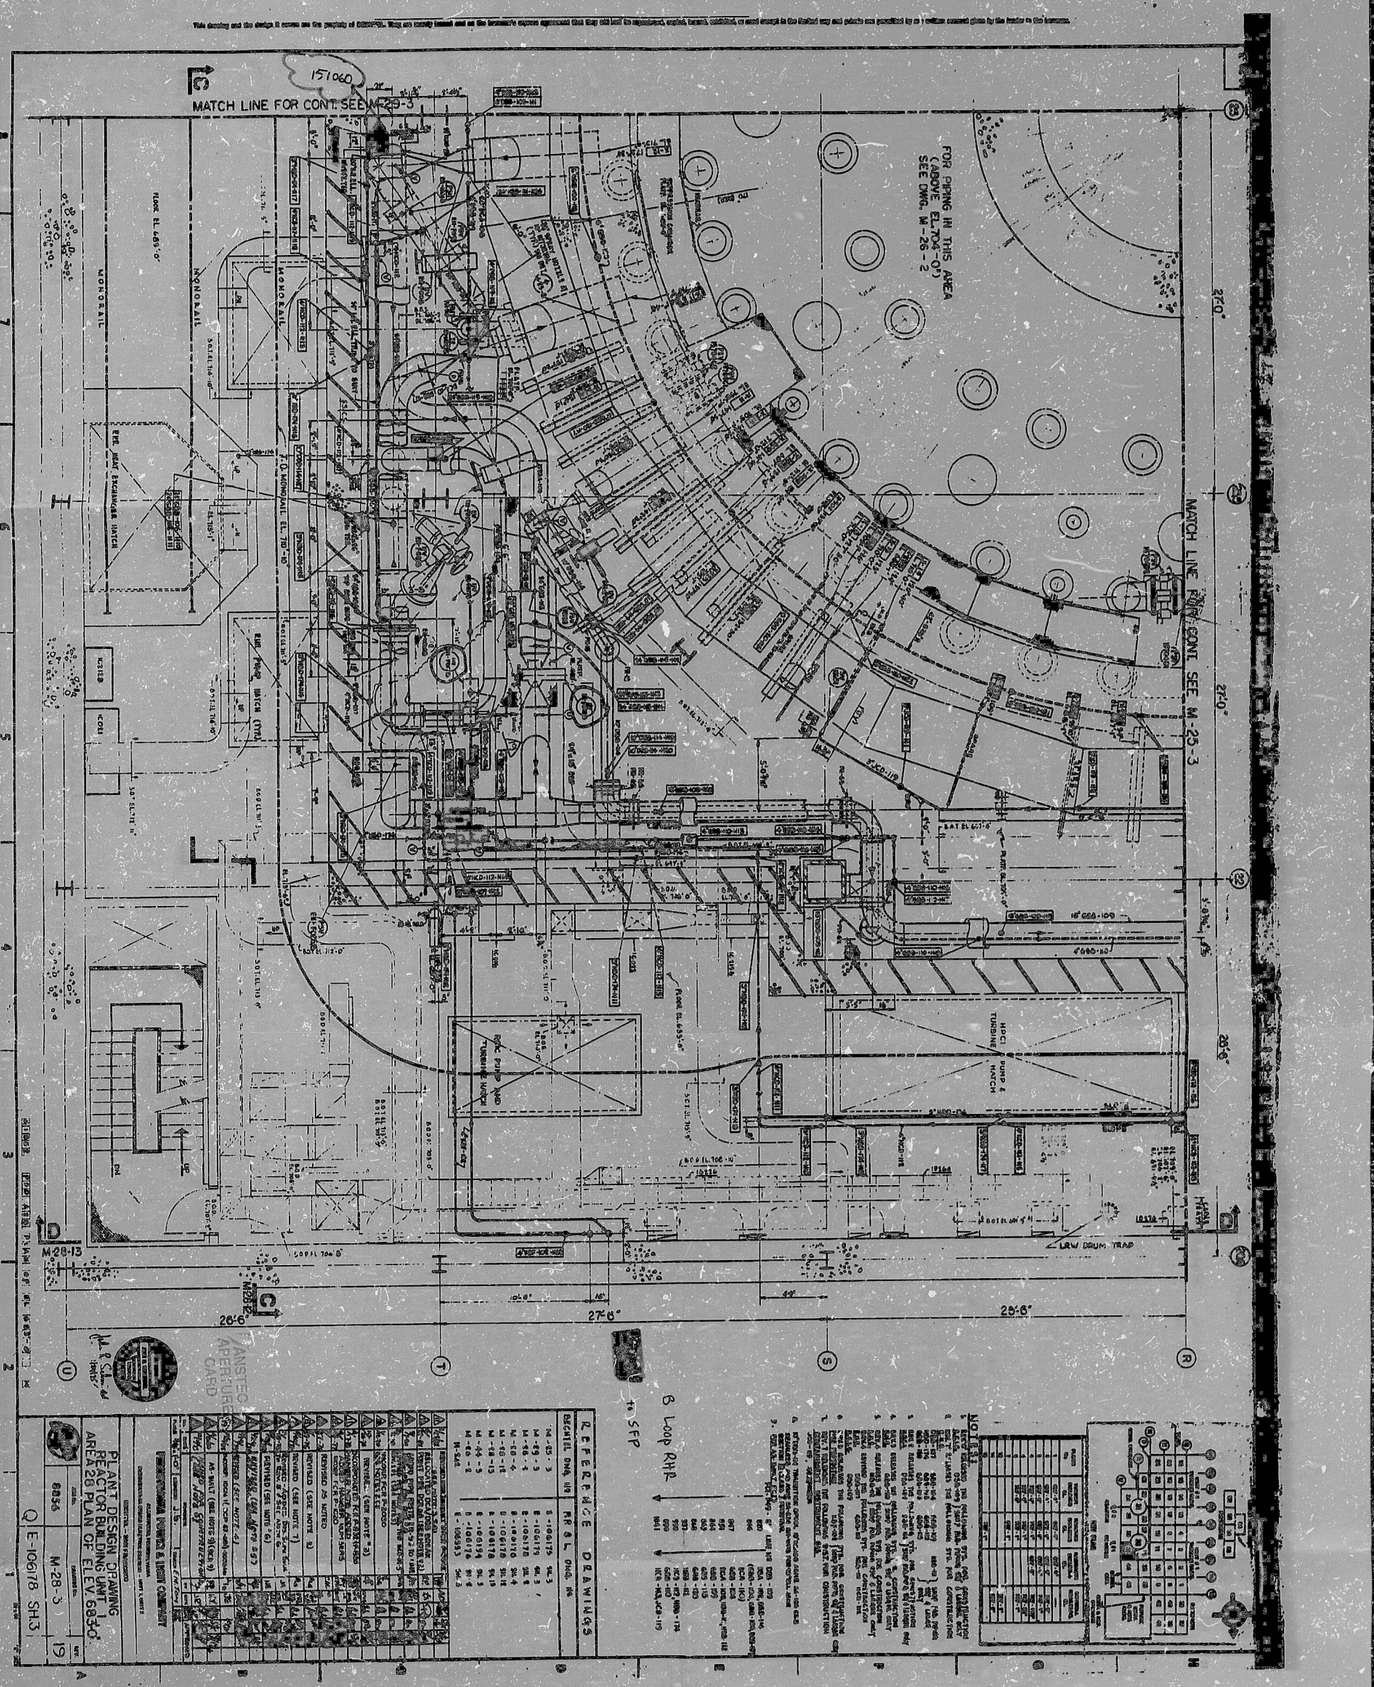

EC-RADN-1008
ATT 3
p 10 of 185

9408010100

PDR RIDS

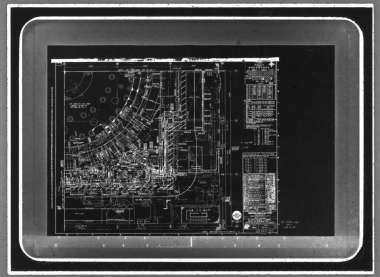

MMM 5824 · FILMSORT® & DUPLICARD® Cards

3M St. Paul, MN